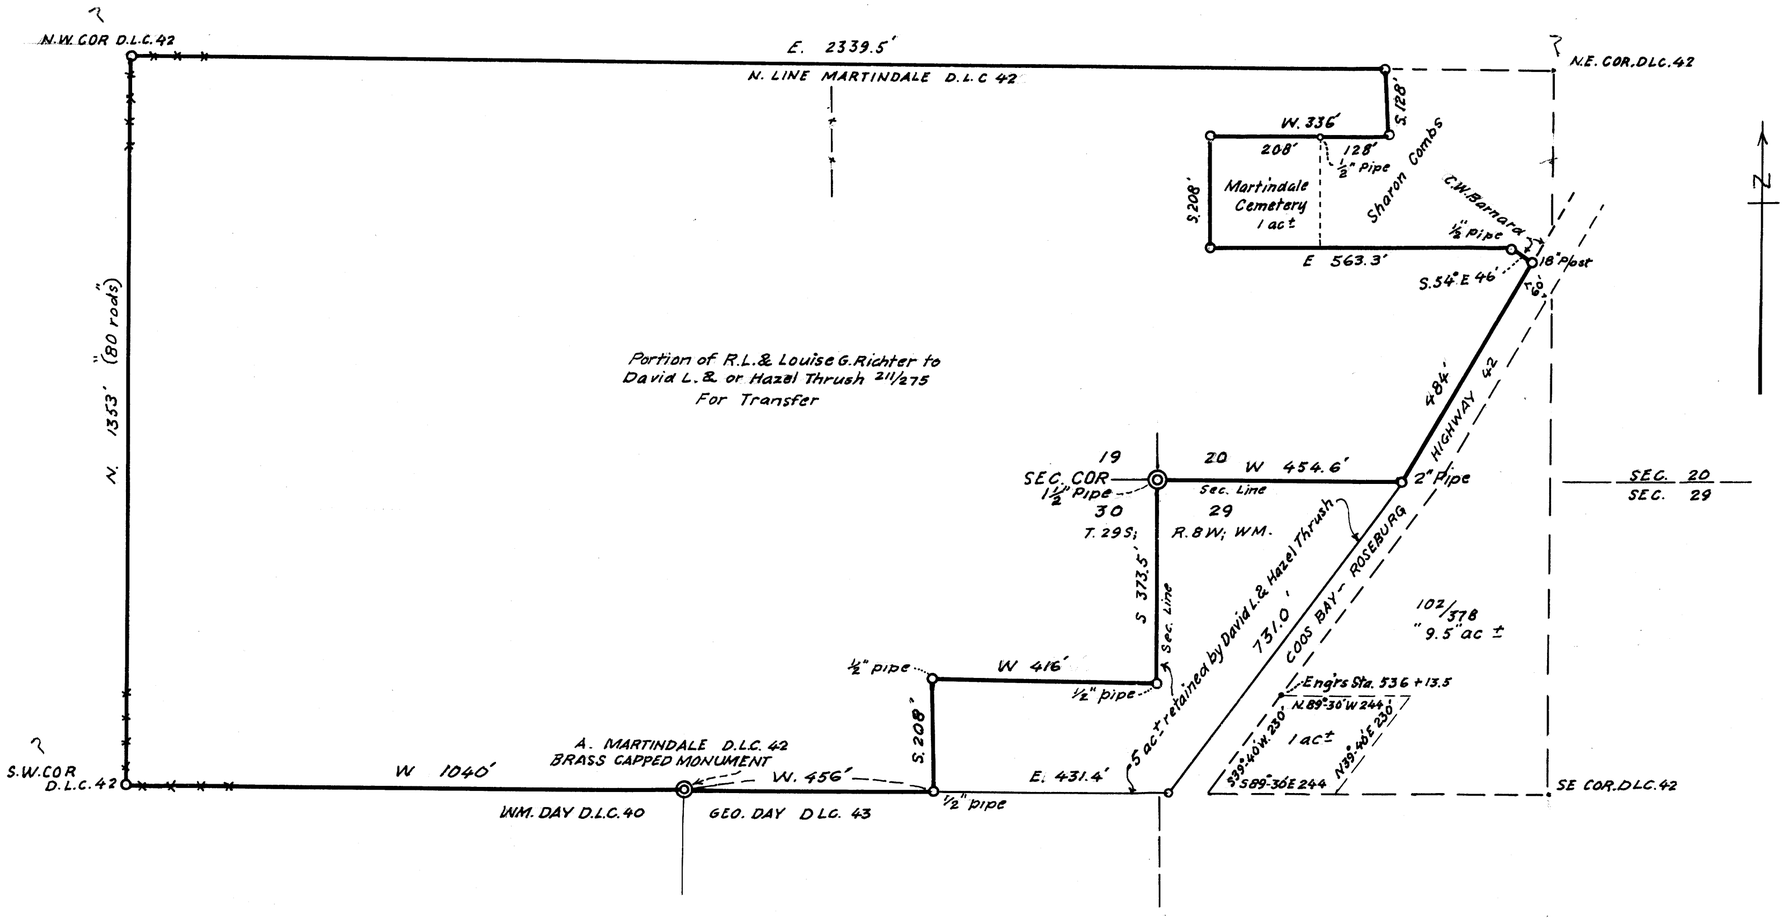

See M 39 - 42 for subdivision survey

COUNTY SURVEYORS FILE DO NOT REMOVE FROM OFF

FIELD STEREOTYPE SURVEY ENGINEER 1901 OREGON MAY 5, 1933 ARTHUR BOYER

Arthur Boyer

FILED RECORDED

SEP 27 1965

COUNTY SURVEYOR
DOUGLAS COUNTY, ORE.

D.L. THRUSH AND OR HAZEL THRUSH
PART OF A. MARTINDALE D.L.C. 42, SECS. 19, 20, 29 & 30, T29S; R.8W; W.M.
CAMAS VALLEY, DOUGLAS COUNTY, ORE.

PORTION TO BE TRANSFERRED & PORTN. TO BE RETAINED
OF ACREAGE RECORDED IN DOUGLAS CO. DEEDS VOL. 211, PG 275

SEPT. 1965 1" = 200 ft.

M 30 - 45