MAP FILE M30-53

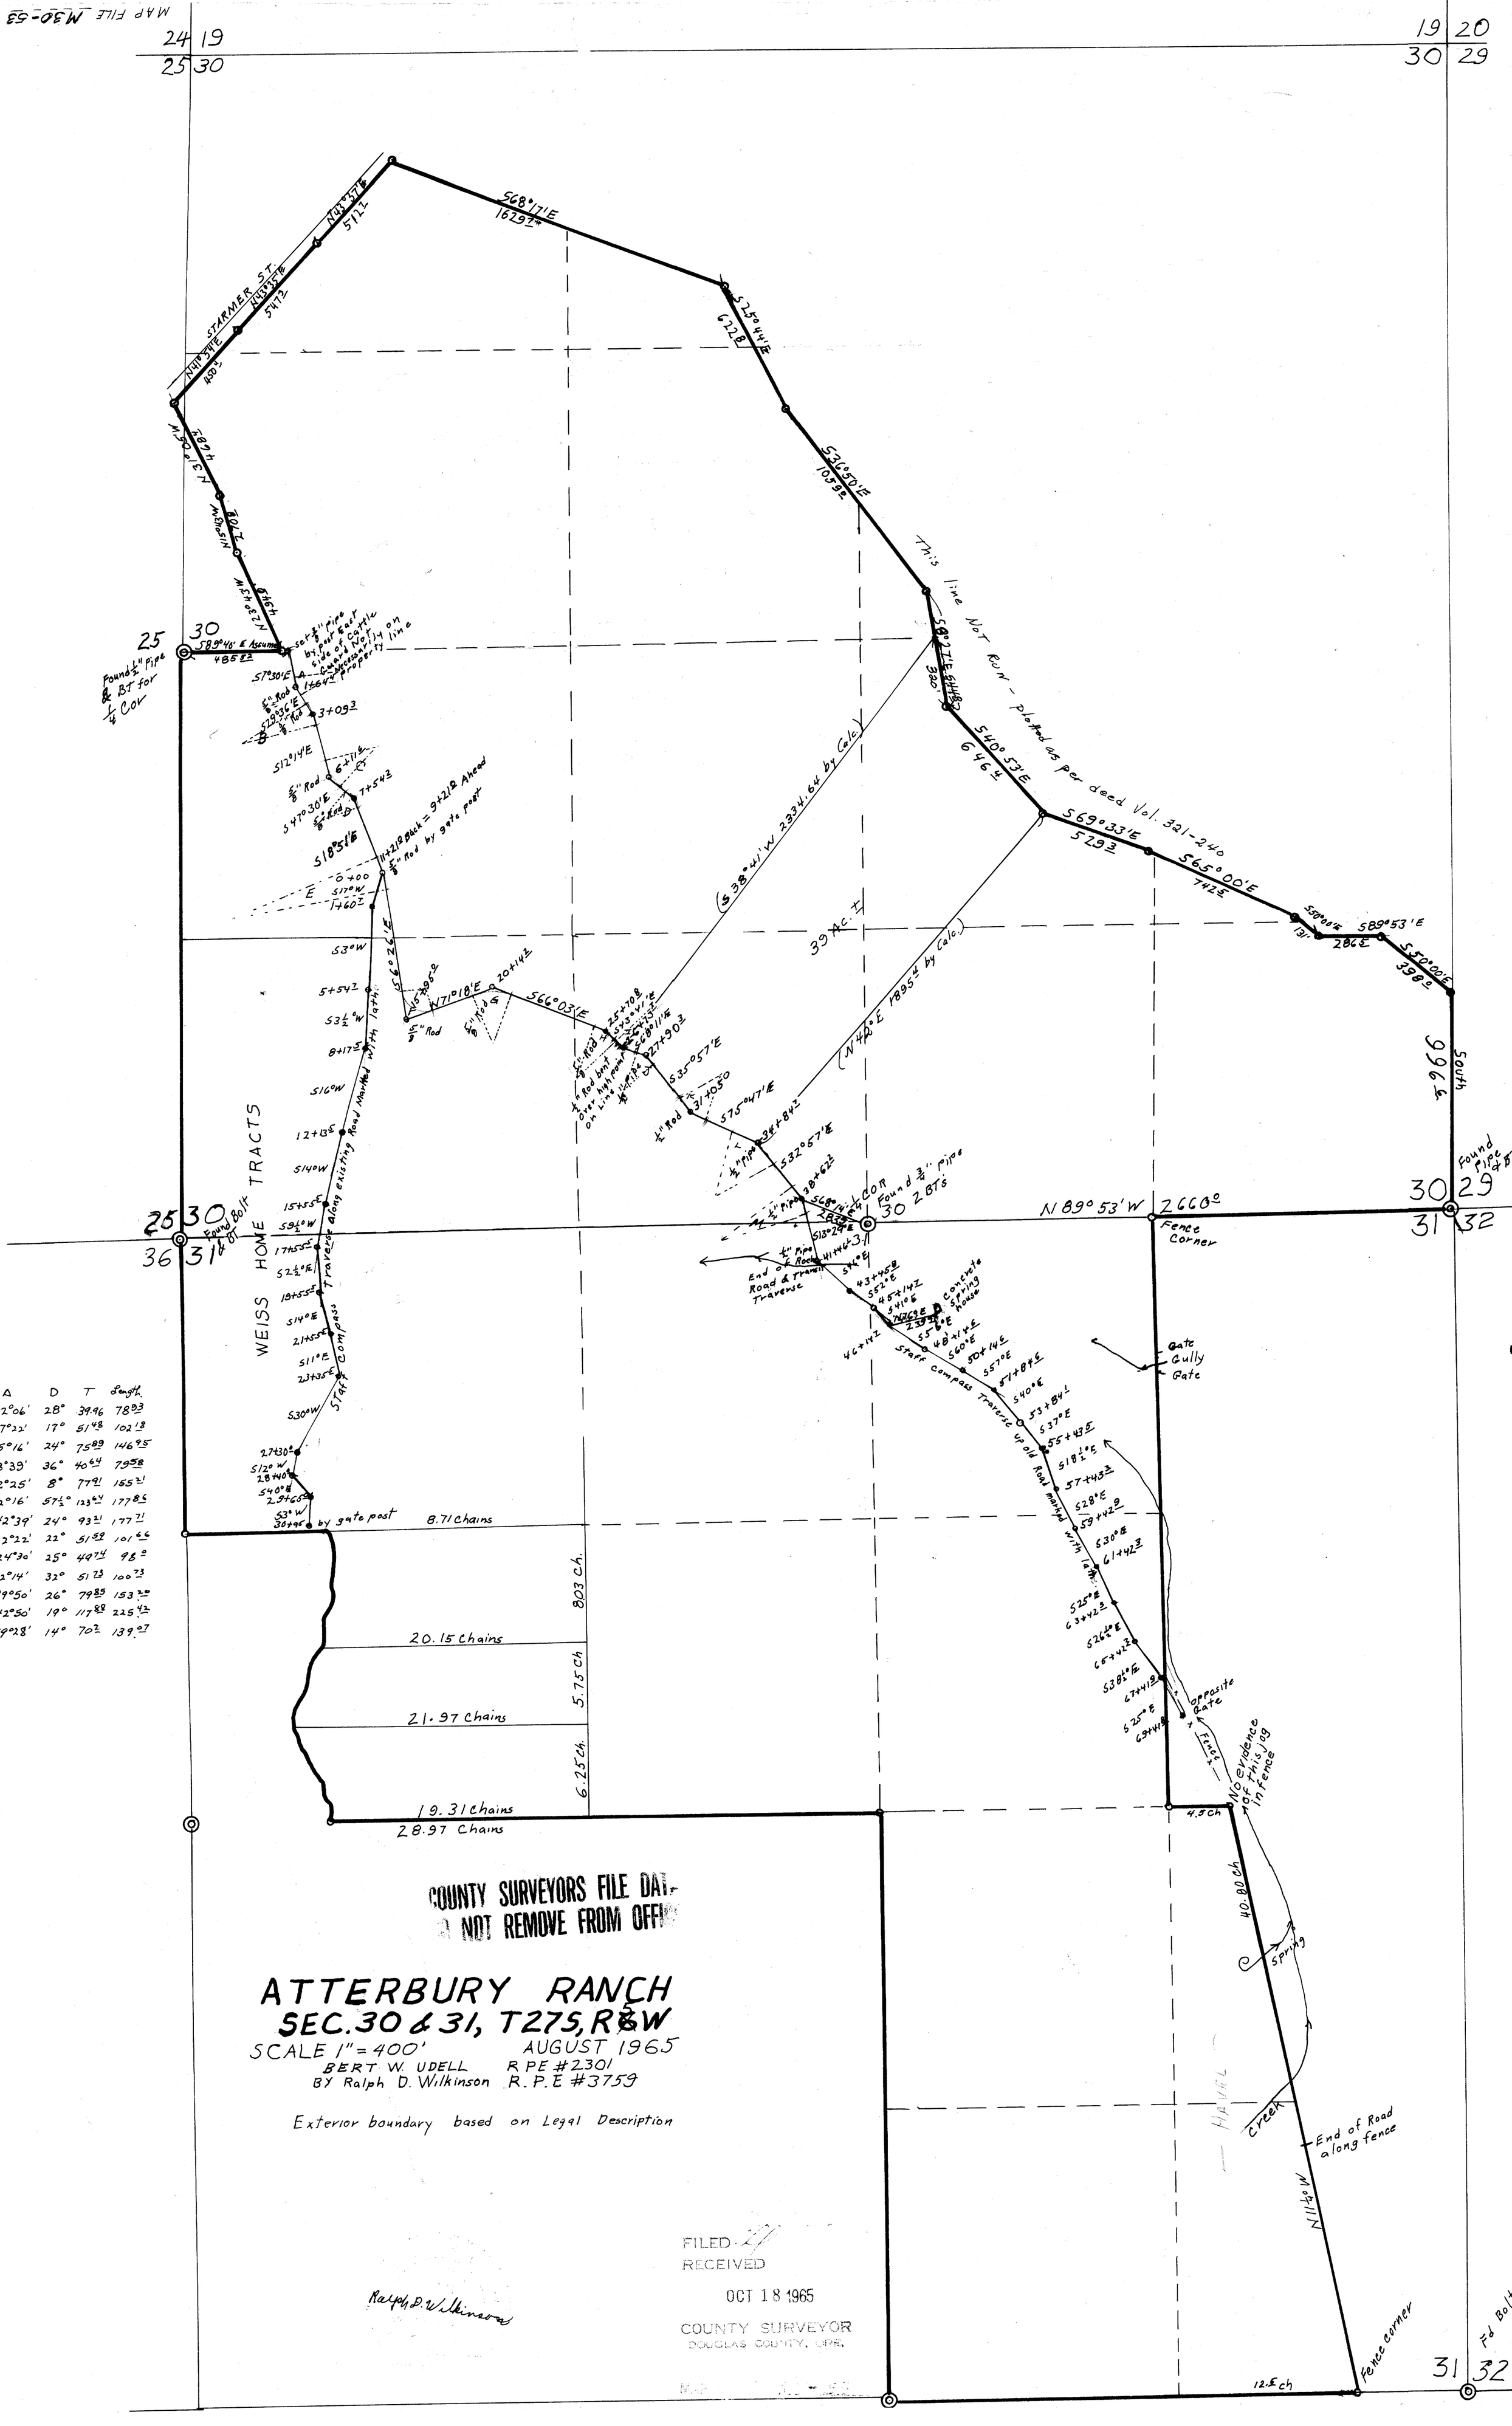
24 19
25 30
19 20
30 29
STARMER ST.
N43°57'E 512.2
N43°35'E 547.2
N40°54'E 430.4
S68°17'E 1629.7
S55°44'E 622.8
S36°50'E 1059.2
This line Not Run - plotted as per deed Vol. 321-240
S40°53'E 646.4
S69°33'E 529.3
S65°00'E 742.5
S50°00'E 131
S89°53'E 286.5
S50°00'E 398.0
South 996
(S38°41'W 2334.64 by Calc.)
(N42°E 1895.4 by Calc.)
39 Ac. ±
N 89° 53' W 2660.0
Fence Corner
Found 3/4" pipe & BT for 1/4 Cor
Found 3/4" pipe & BT
Found 3/4" pipe & BT
Found 3/4" pipe & BT