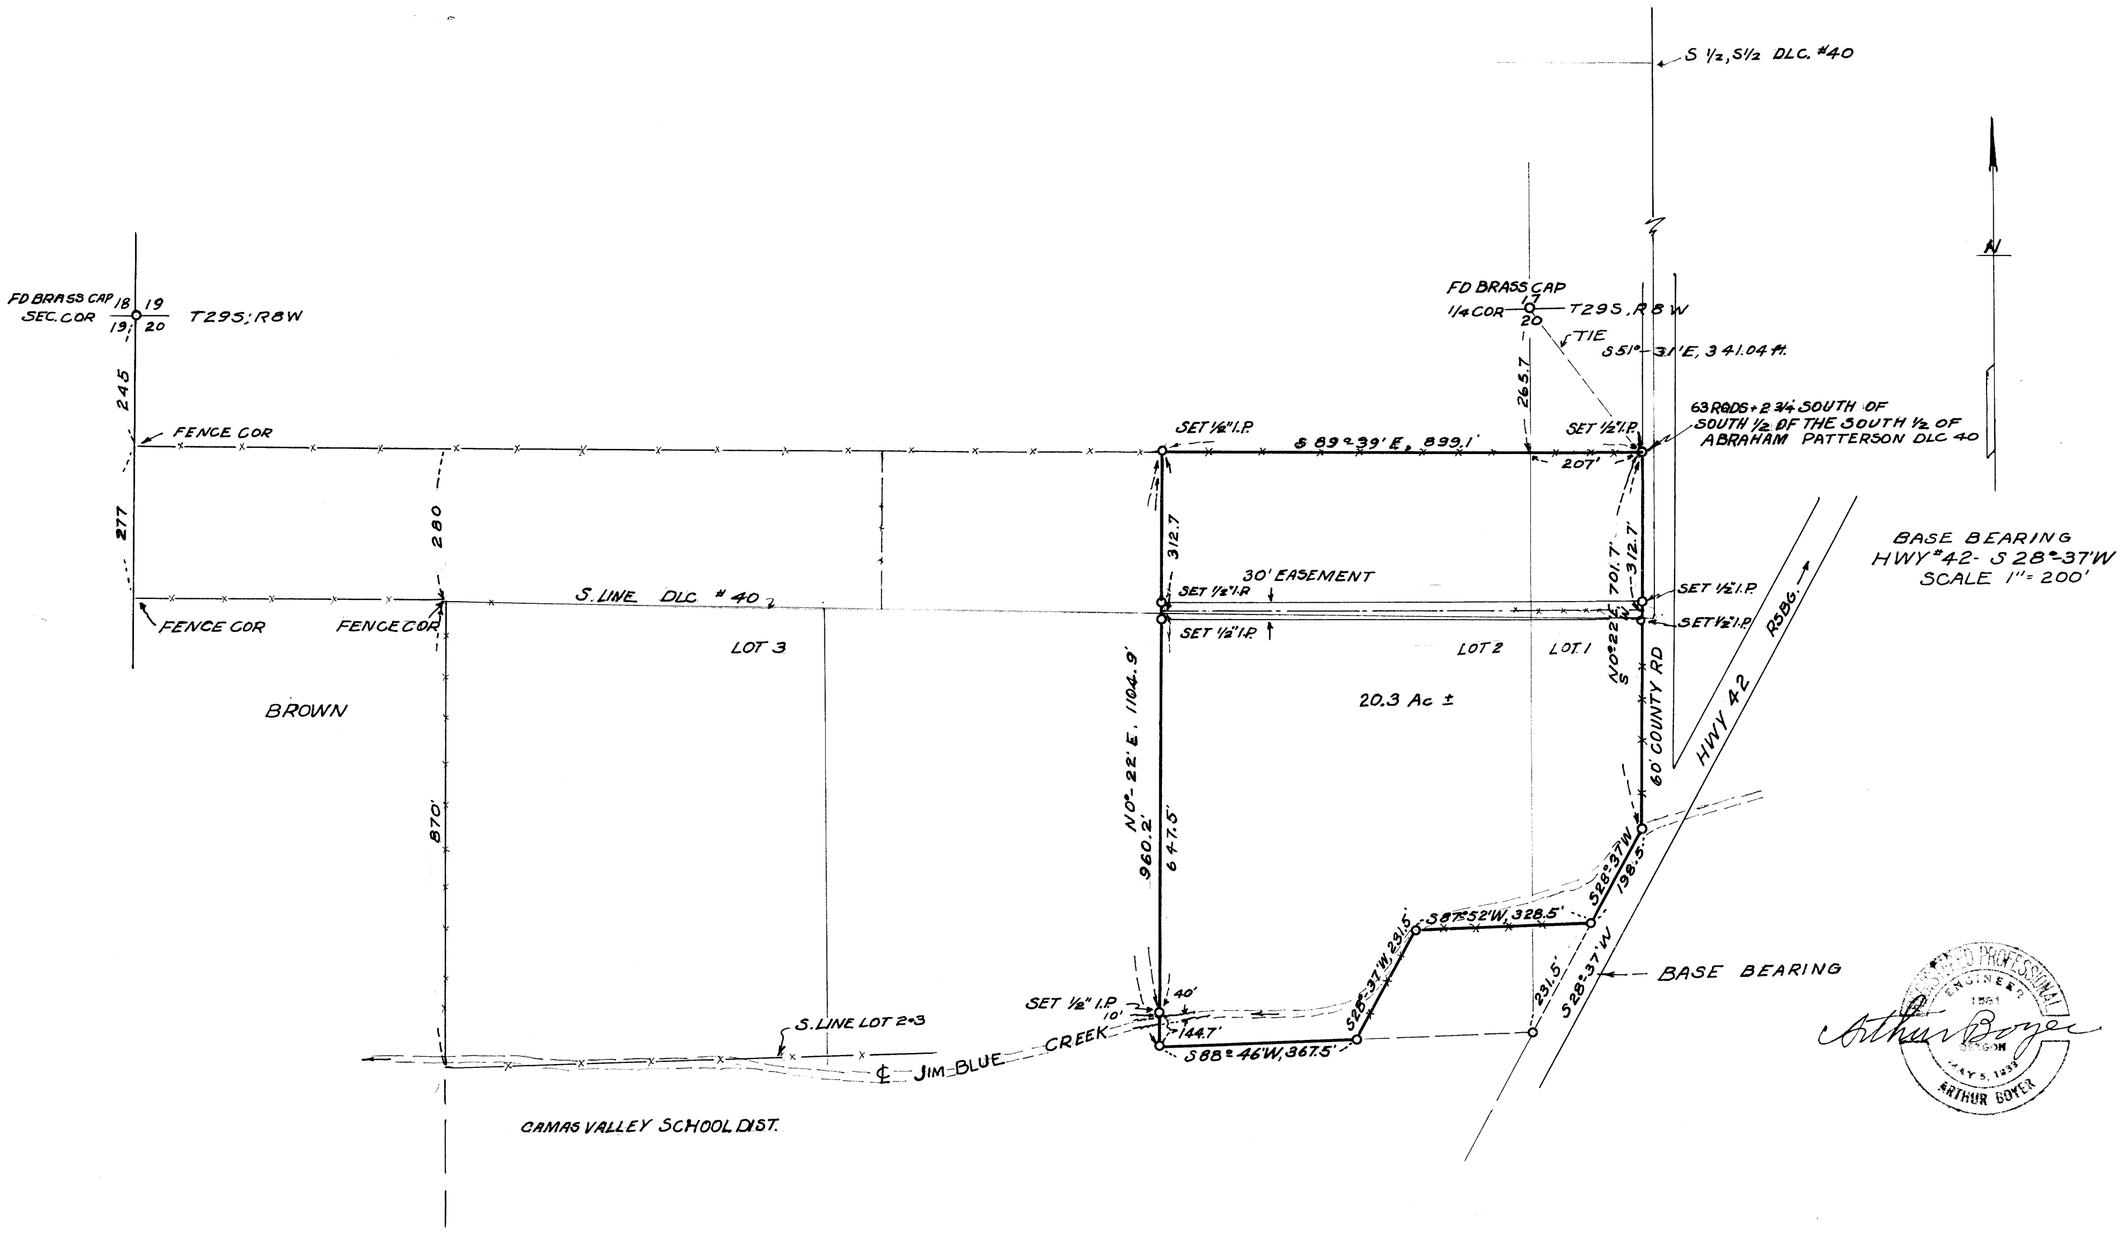

VOID

SEE REVISED SURVEY M 31-60

COUNTY SURVEYORS FILE DATA
DO NOT REMOVE FROM OFFICE

FILED
RECEIVED
OCT 29 1965
COUNTY SURVEYOR
DOUGLAS COUNTY, ORE.

HOWARD ELLIOTT
TRACT IN DLC #40, LOTS 1, 2 IN
SEC 20, T29S, R8W, W.M.;
CAMAS VALLEY, DOUG. CO; ORE.
SCALE 1" = 200' OCT. 1965

MAP FILE M30-58

MAP FILE M30-58