19-OEW

SURVEY OF THE GRANT PHILLIPS PROPERTY IN THE NORTH 10.5 FT. OF LOT 5 & LOTS 6, 7 & 8, BLOCK 35, RAILROAD ADDITION, ROSEBURG, ORE.

ENGINEER- W.S. BARNES SCALE 1" = 30' NOV. 1965
SURVEYED FOR - GRANT PHILLIPS.

COUNTY SURVEYORS FILE DATA
DO NOT REMOVE FROM OFFICE

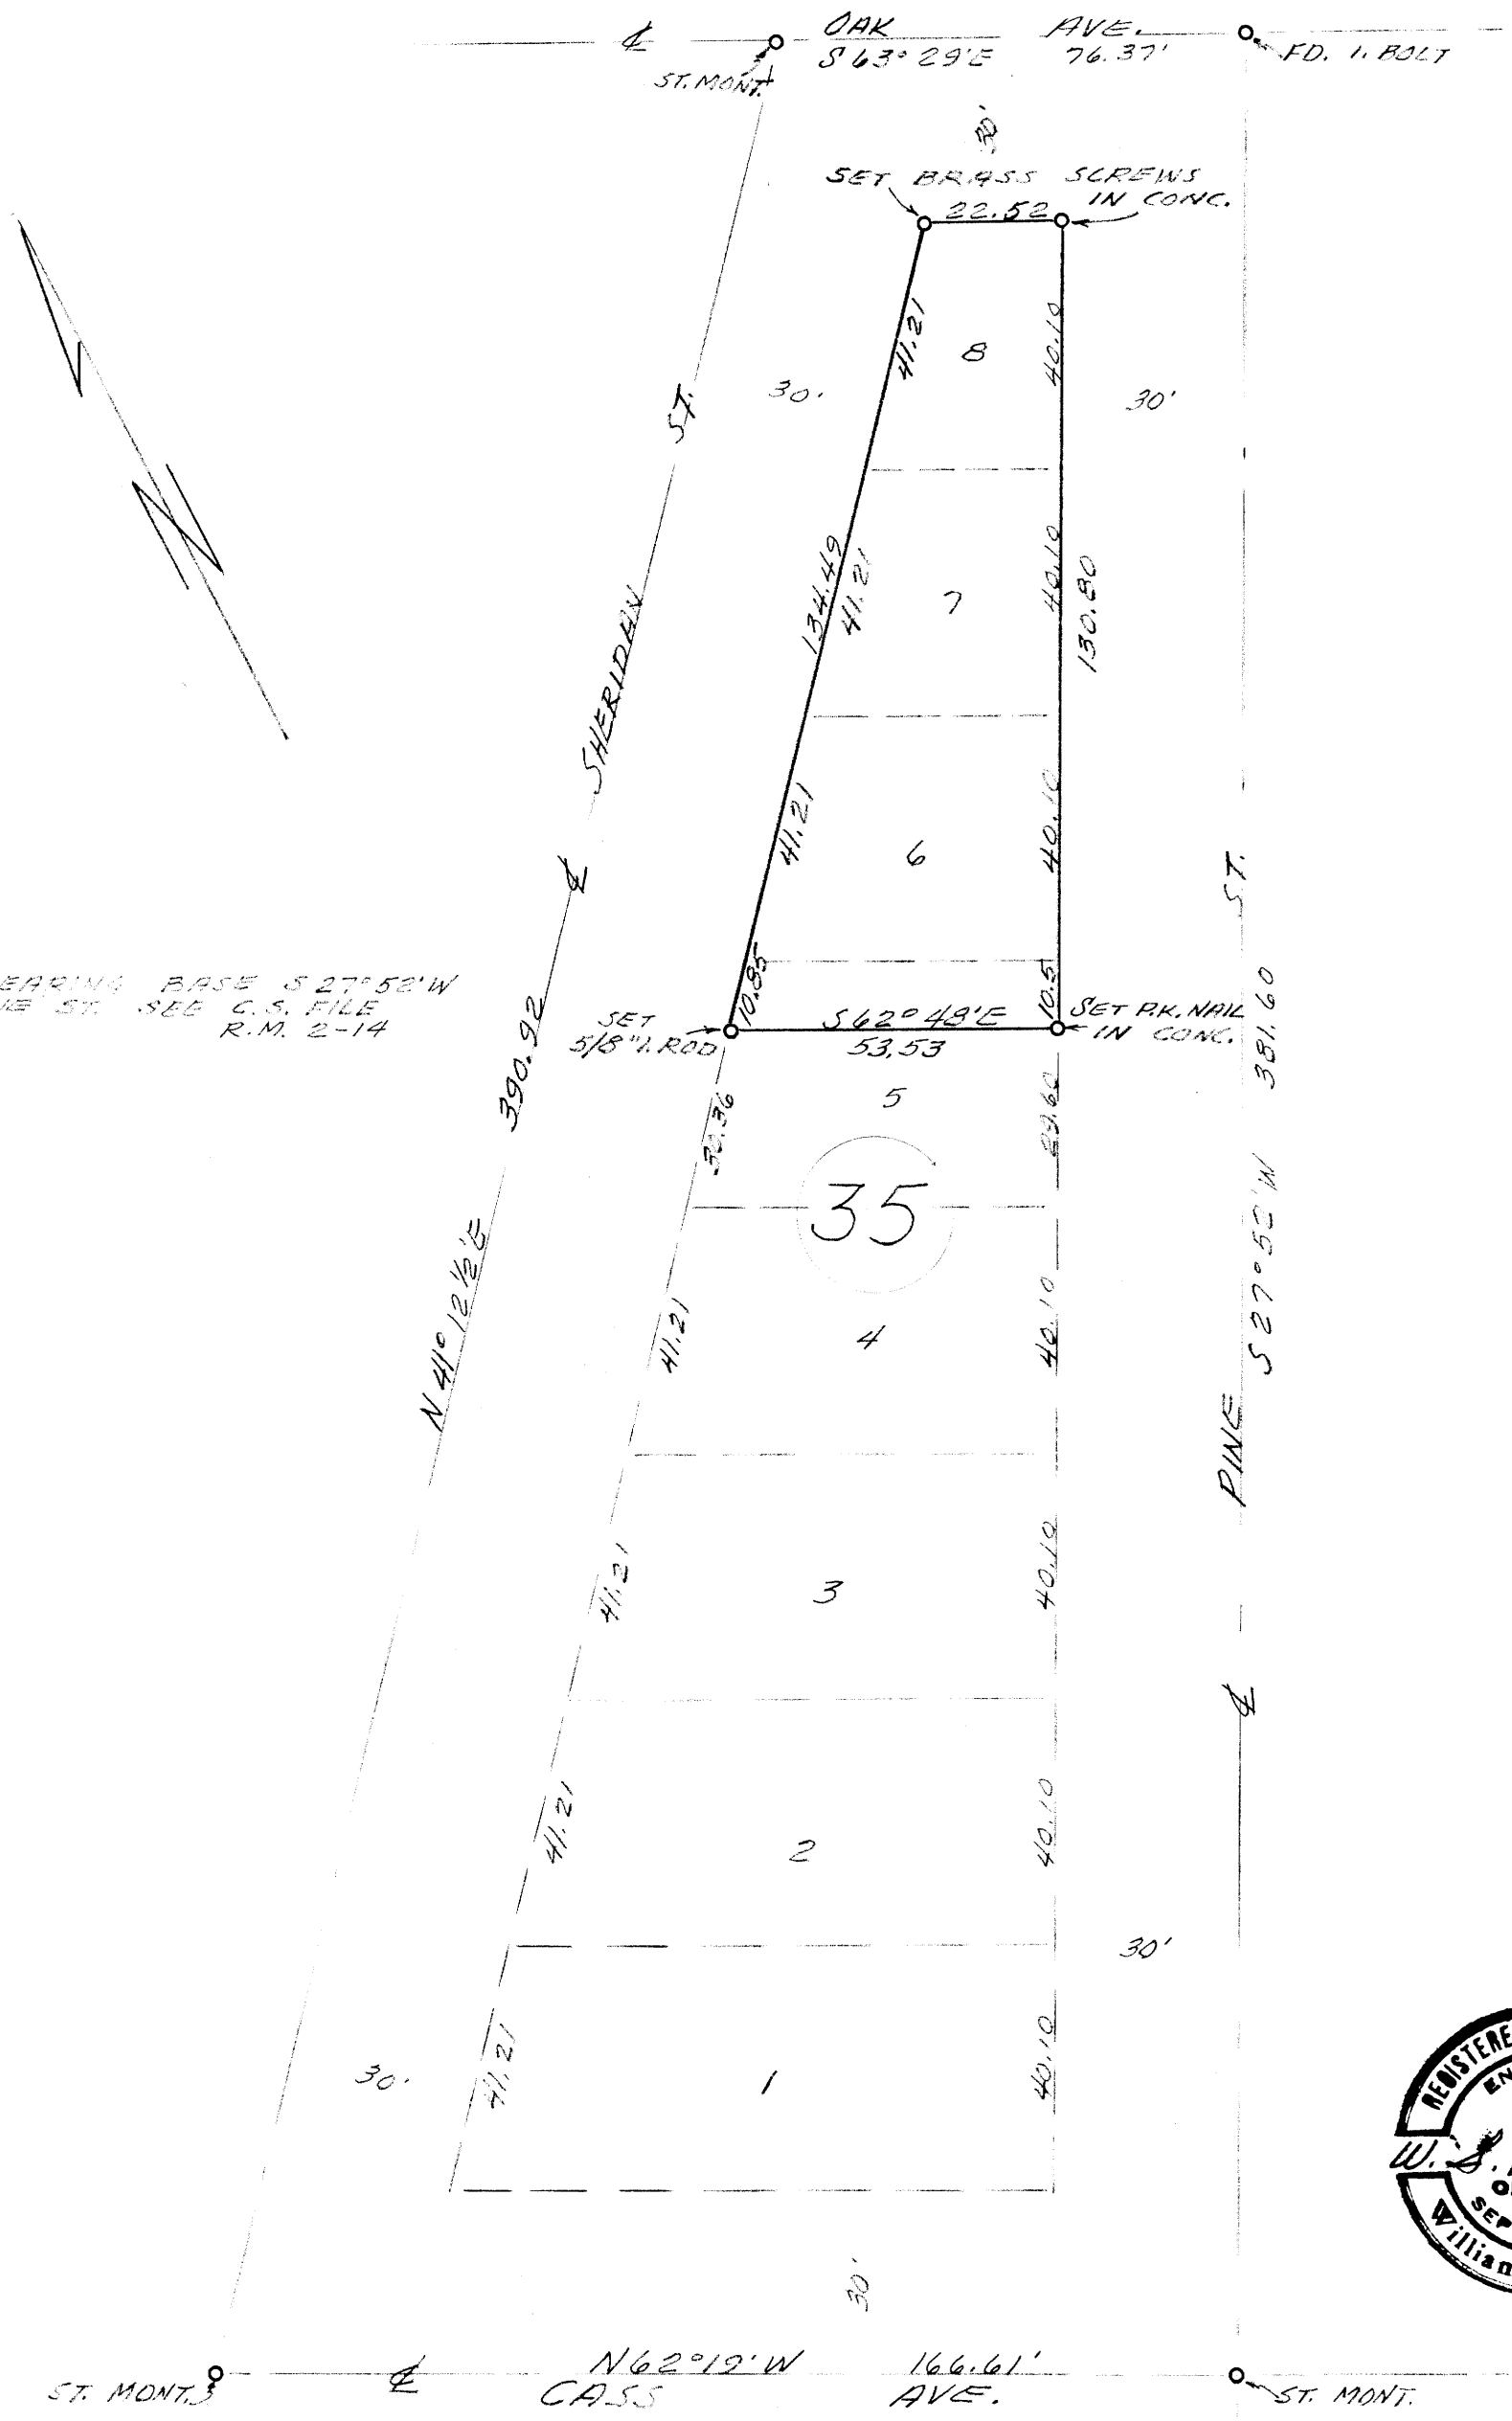

FILED
RECEIVED
NOV 5 1965
COUNTY SURVEYOR
DOUGLAS COUNTY, ORE.

REGISTERED PROFESSIONAL ENGINEER 2128 OREGON SEPT. 9, 1941 William S. Barnes

W. S. Barnes

FILE M30 P-61