M 30-63

FILED
RECEIVED
NOV 8 1965
COUNTY SURVEYOR
DOUGLAS COUNTY, ORE.

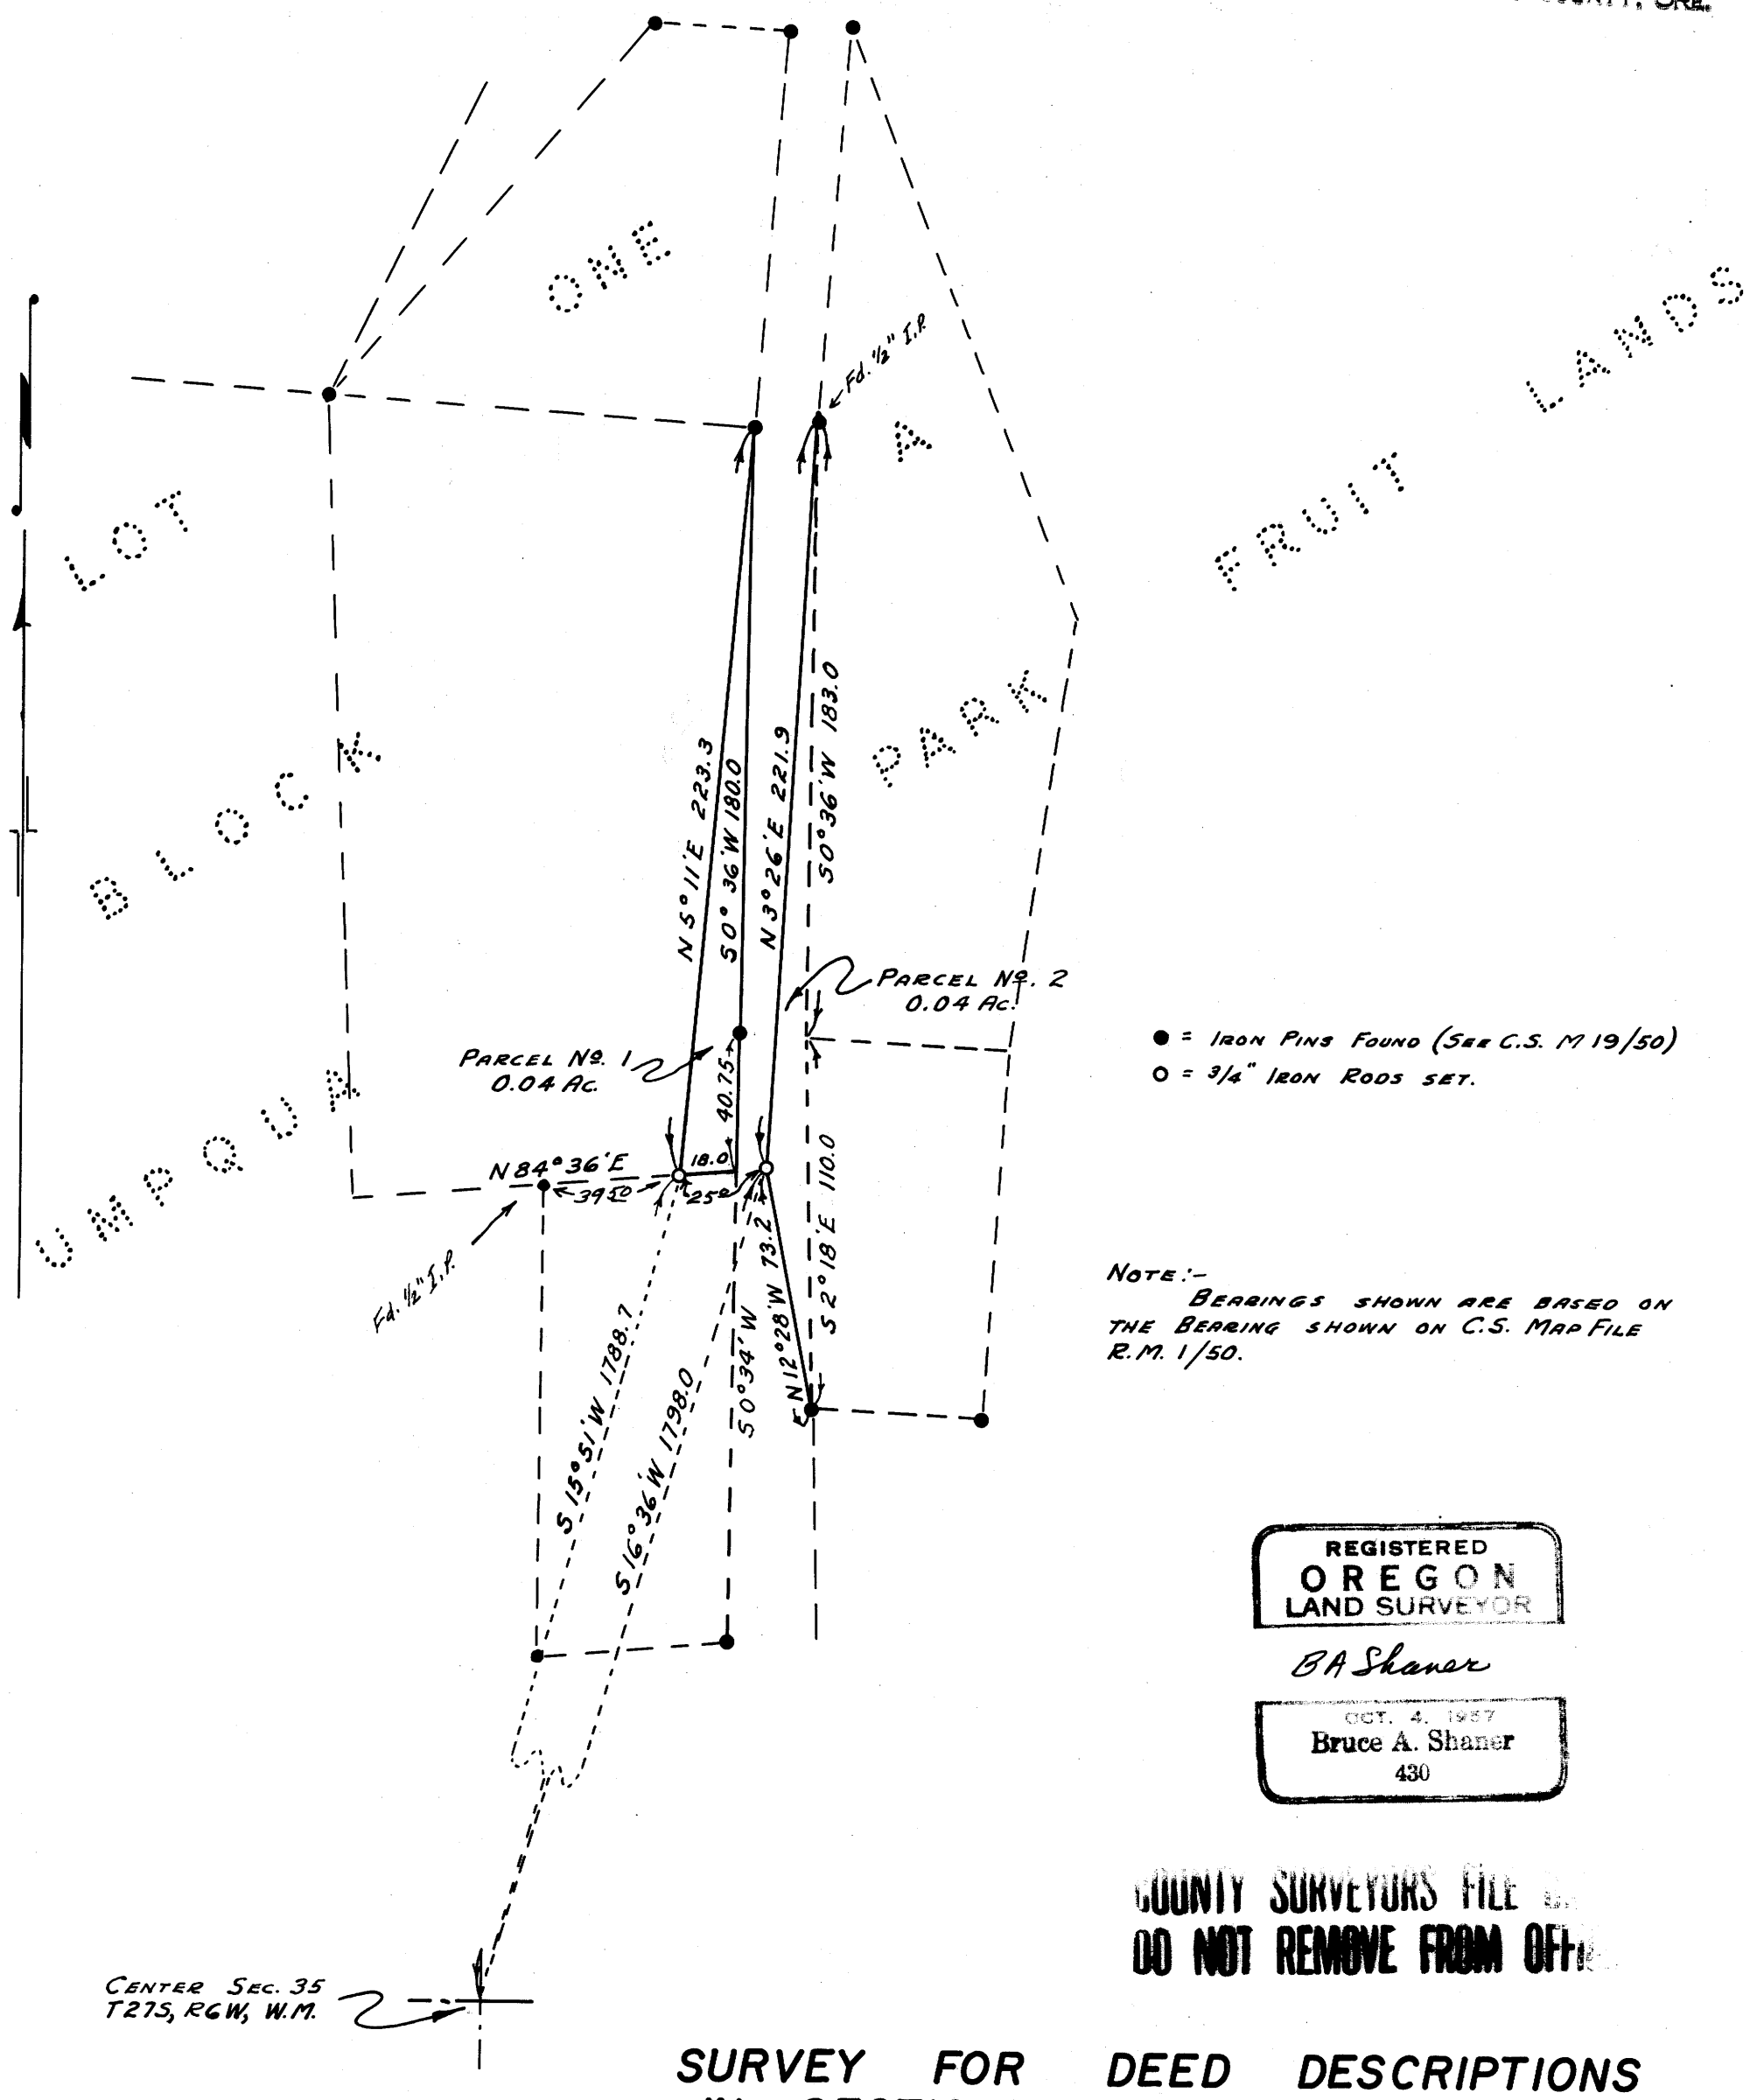

● = IRON PINS FOUND (SEE C.S. M 19/50)
○ = 3/4" IRON RODS SET.

NOTE:-
BEARINGS SHOWN ARE BASED ON THE BEARING SHOWN ON C.S. MAP FILE R.M. 1/50.

REGISTERED
OREGON
LAND SURVEYOR
BA Shaner
OCT. 4, 1967
Bruce A. Shaner
430

COUNTY SURVEYORS FILE
DO NOT REMOVE FROM OFFICE

SURVEY FOR DEED DESCRIPTIONS IN SECTION 35, T27S, R6W, W.M. DOUGLAS COUNTY, OREGON.

SURVEYED FOR W.H. Mc LAIN — NOV. 1965
SURVEYED BY BRUCE A. SHANER — SCALE 1" = 50'

MAP FILE M 30-63