M30 - 69

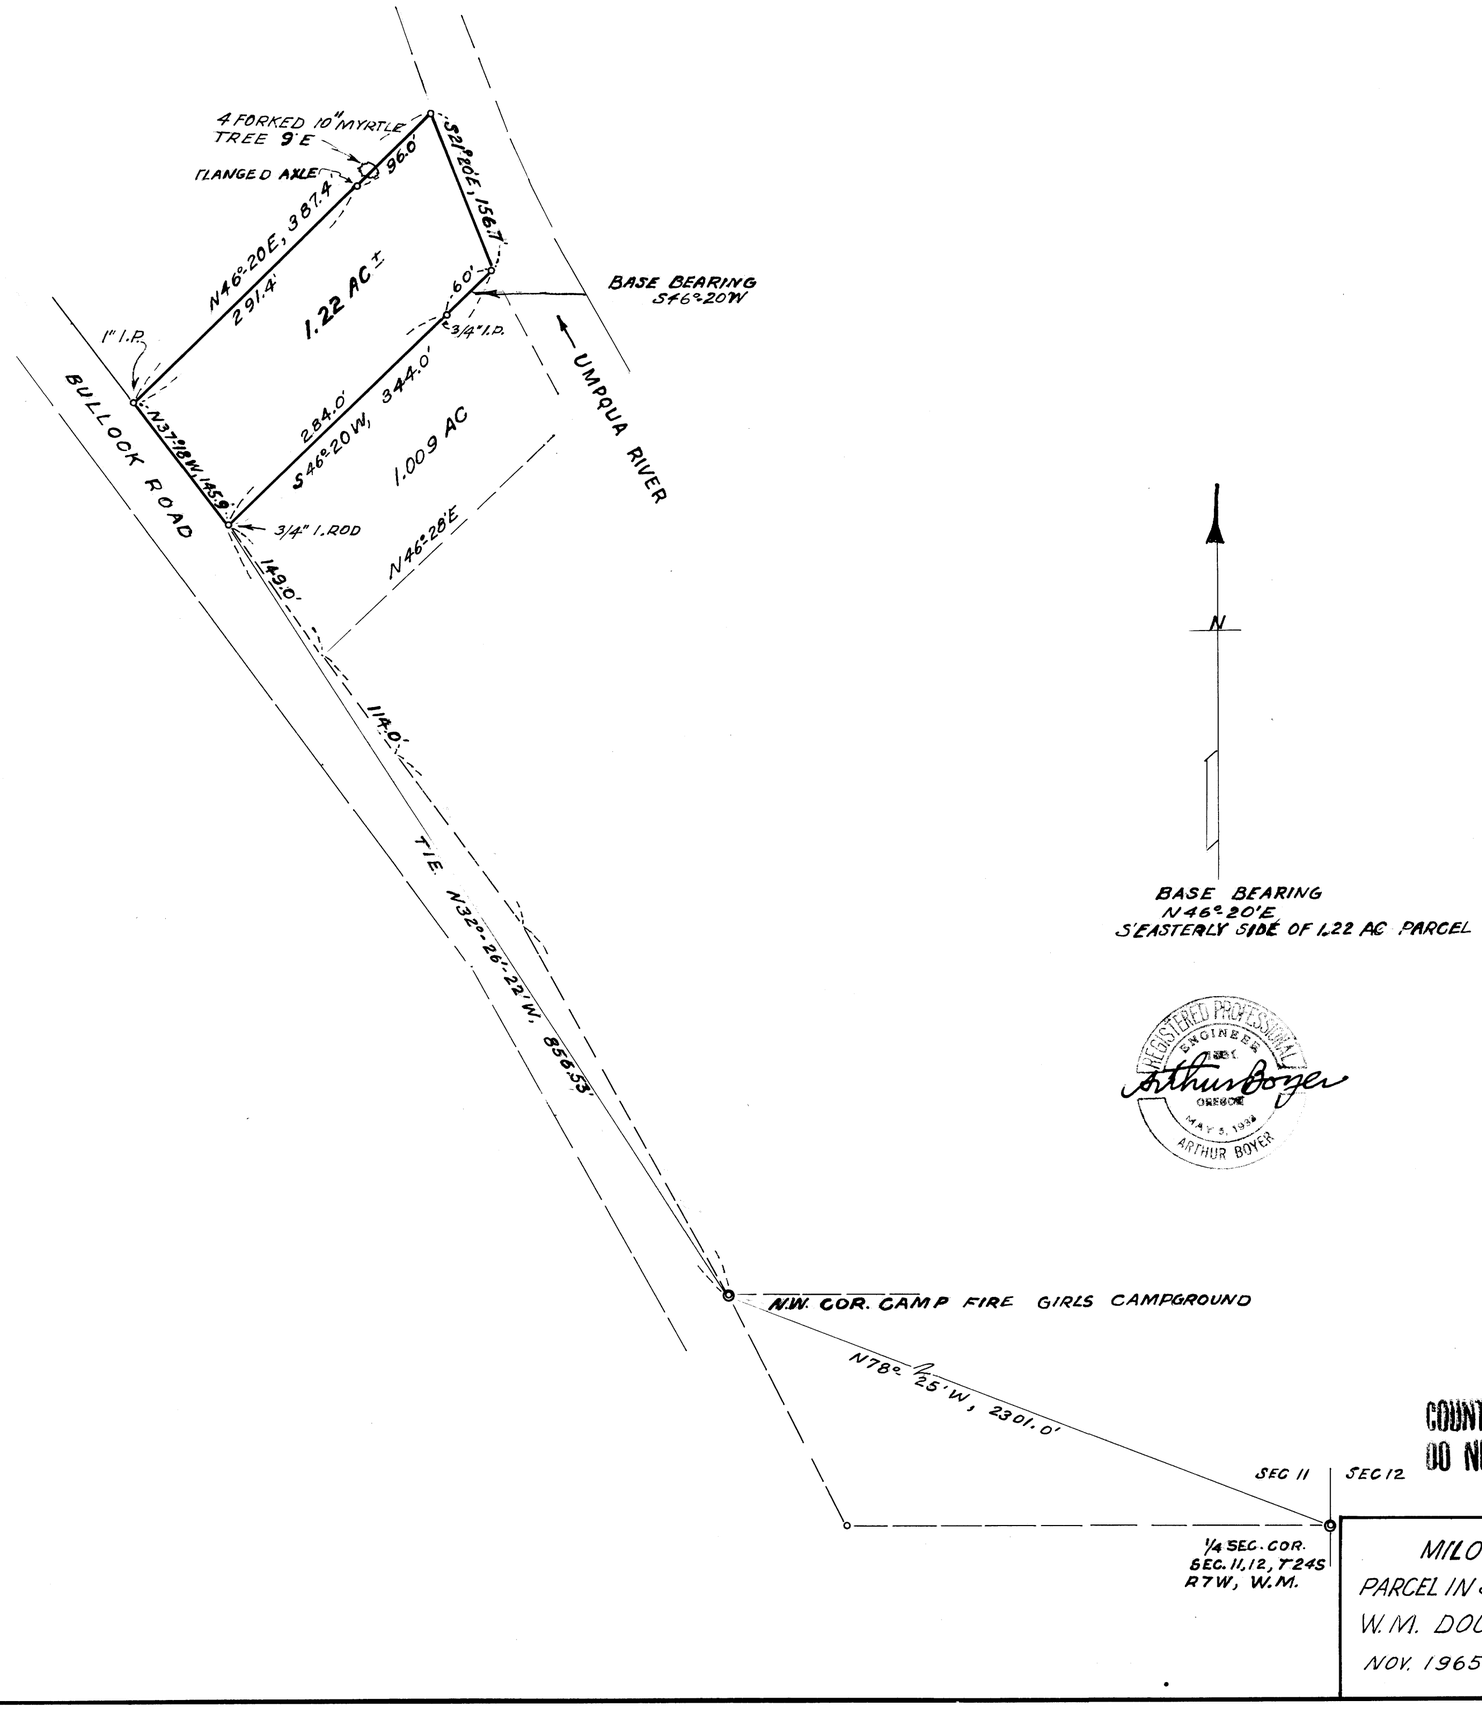

COUNTY SURVEYORS FILE DATA
DO NOT REMOVE FROM OFFICE

MILO BULLOCK
PARCEL IN SEC. 11; T24S; R7W;
W.M. DOUGLAS CO., ORE.
NOV. 1965 1" = 100'

FILED
RECEIVED
NOV 18 1965
COUNTY SURVEYOR
DOUGLAS COUNTY, ORE.

FILE NO. M30 - 69