M 30 - 73

COUNTY SURVEYORS FILE
DO NOT REMOVE FROM OFFICE

SECTS. 16 + 17, T.22S., R.5 W. W.M.

survey of area to be annexed to city of Drain, Oreg.

Scale 1" = 100' Nov. 17, 1965

R.A. Duncan Drain Oregon

FILED
RECEIVED
NOV 17 1965
COUNTY SURVEYOR
DOUGLAS COUNTY, ORE.

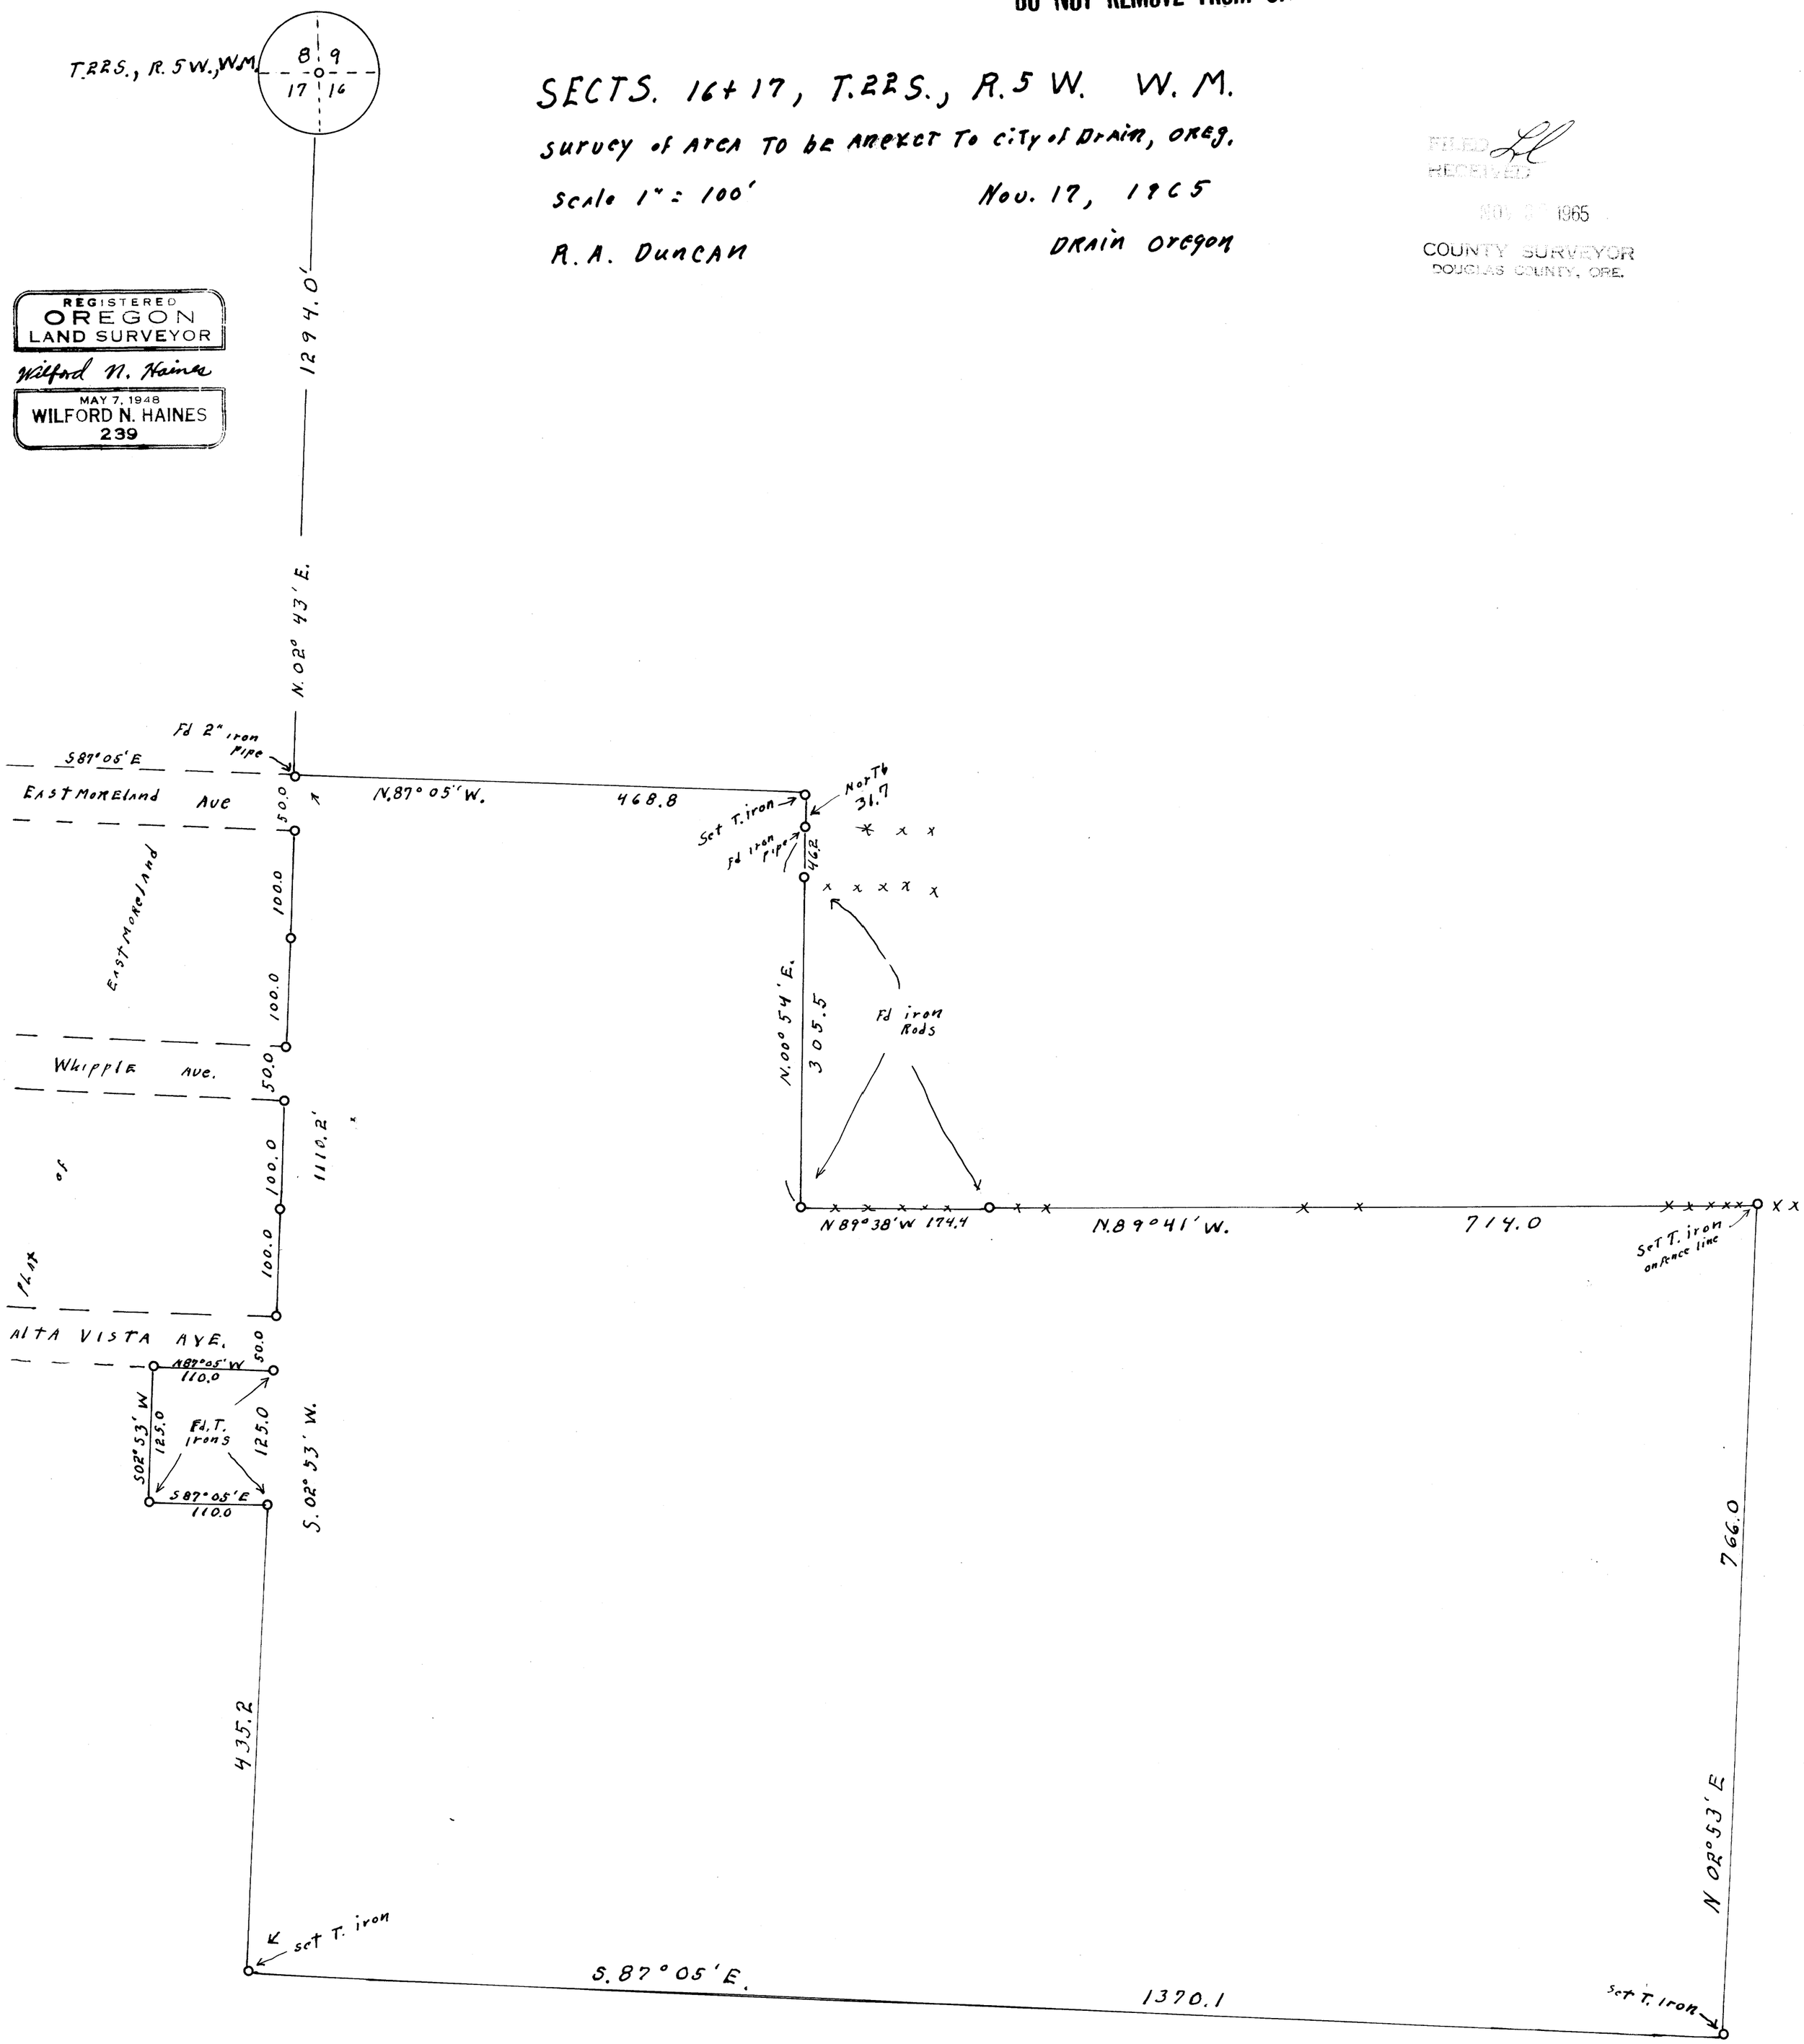

MAP FILE M 30 + 73