PROPERTY LINE SURVEY FOR HILTERBRANT & OLINGHOUSE AS PER COURT ORDER

[redacted] IN SECTION 5, T32S, R4W, W.M.

FILED
RECEIVED
MAR 21 1966
COUNTY SURVEYOR
DOUGLAS COUNTY, ORE.

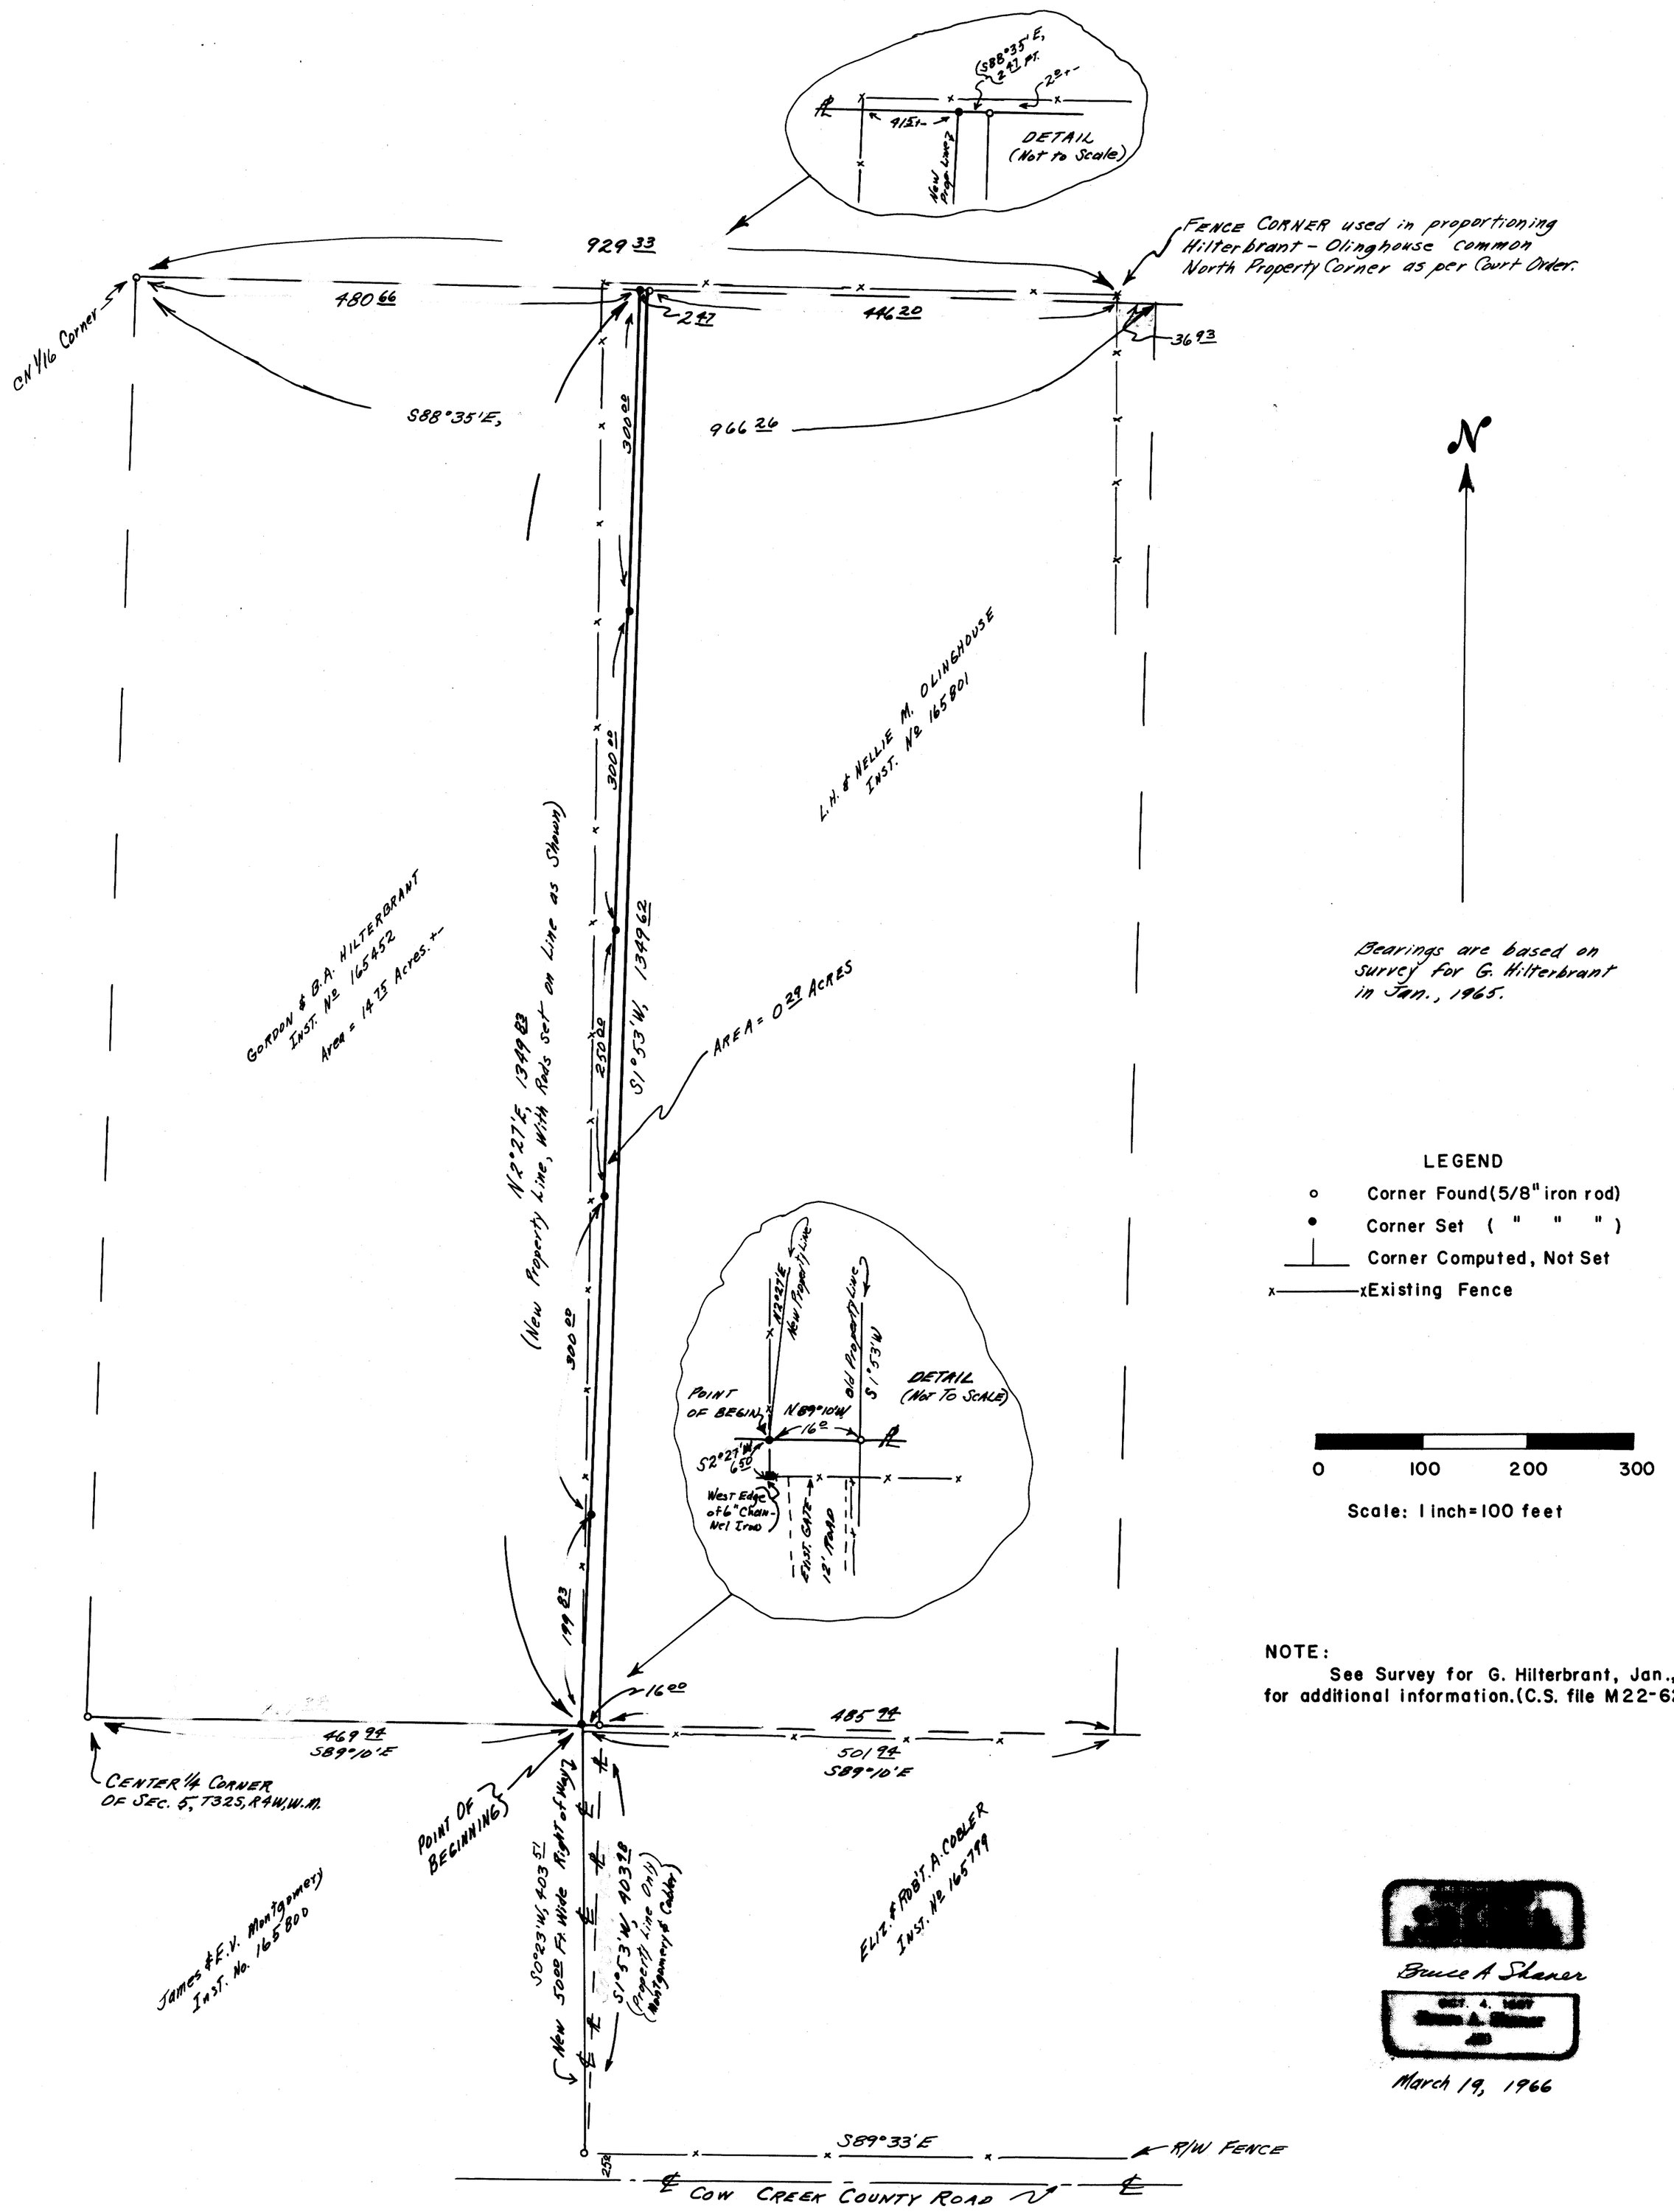

NOTE:
See Survey for G. Hilterbrant, Jan., 1965, for additional information. (C.S. file M22-62)

[redacted]
Bruce A Shaner
[redacted]
March 19, 1966

MAP FILE M 31 + 31