C.S. FILE 54/24
M. 31-39

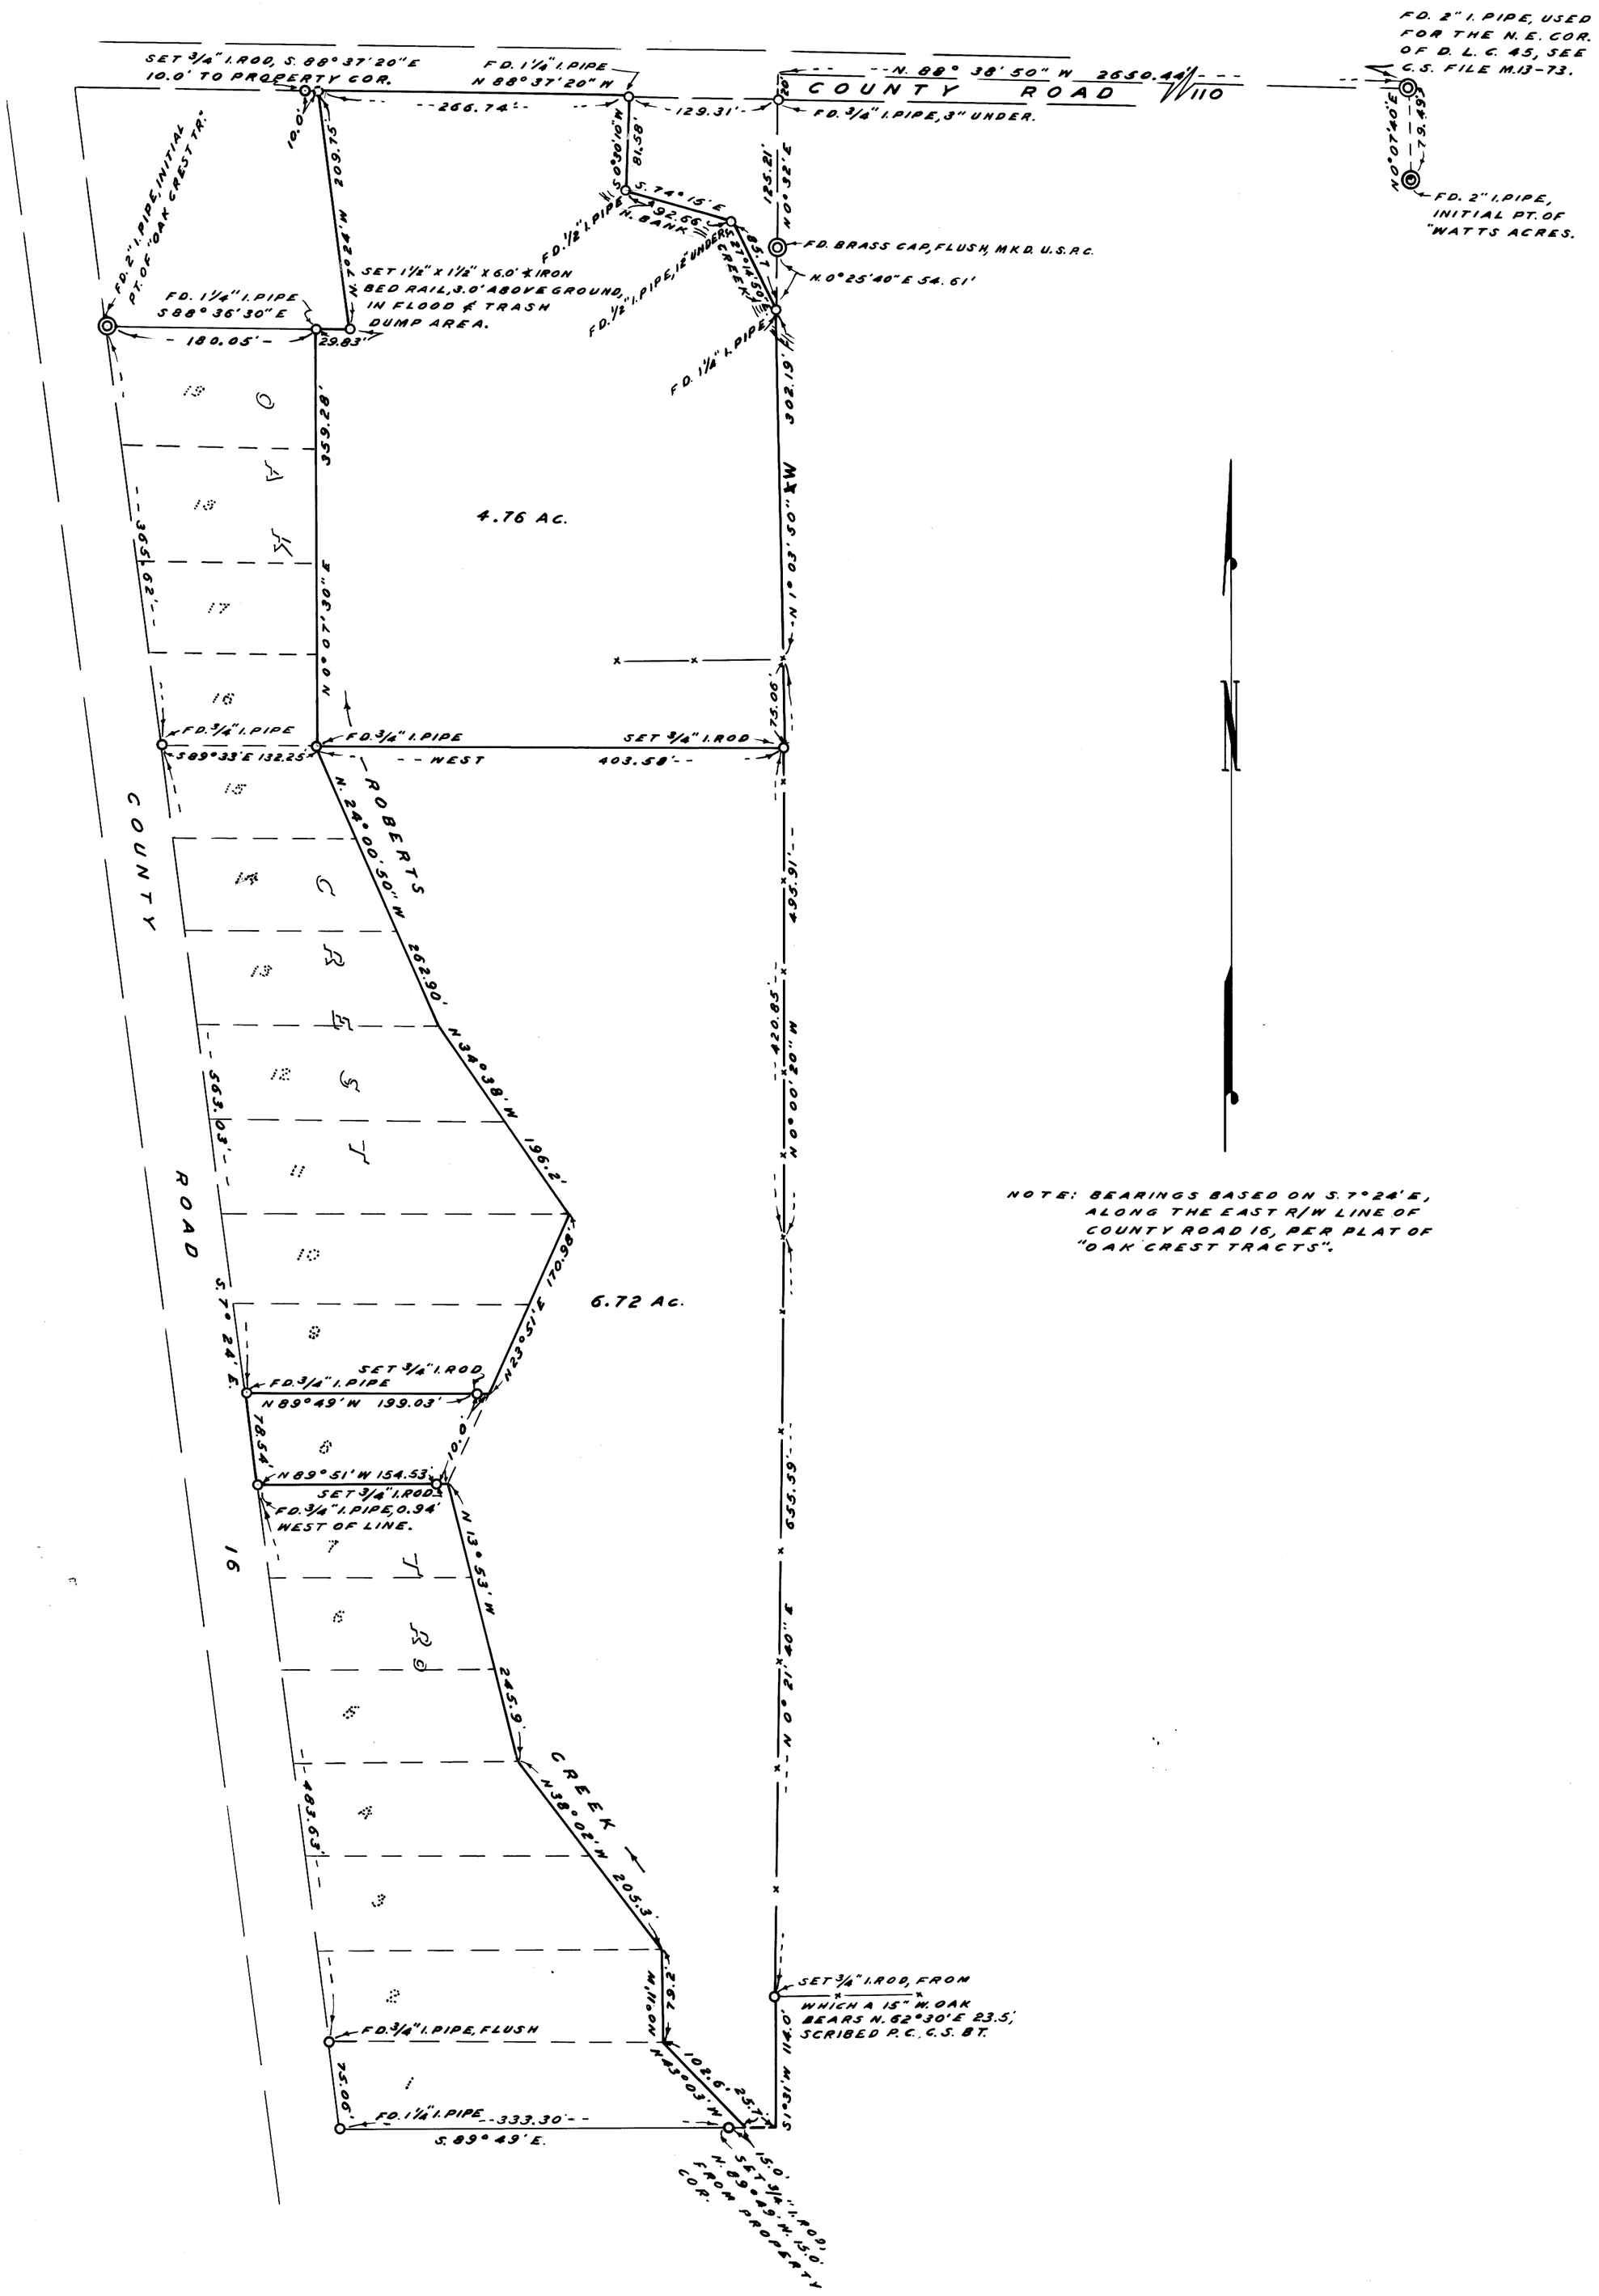

NOTE: BEARINGS BASED ON S. 7° 24' E, ALONG THE EAST R/W LINE OF COUNTY ROAD 16, PER PLAT OF "OAK CREST TRACTS".

COUNTY SURVEYORS FILE DATA
DO NOT REMOVE FROM OFFICE

COUNTY SURVEYOR'S OFFICE
DOUGLAS COUNTY, OREGON

SURVEY FOR DEED DESCRIPTION,
SECTION 11, T.28S., R.6 W., W.M.

REGISTERED
OREGON
LAND SURVEYOR
NOV. 6, 1953
JAMES W. BYRON
303

JAMES W. BYRON — COUNTY SURVEYOR
SURVEYED APRIL 12, 1966 — SCALE 1" = 100'
SURVEYED FOR P. PRESTON & DOUGLAS CO. PARK DEPT.

C.S. FILE 54/24
M 31-39