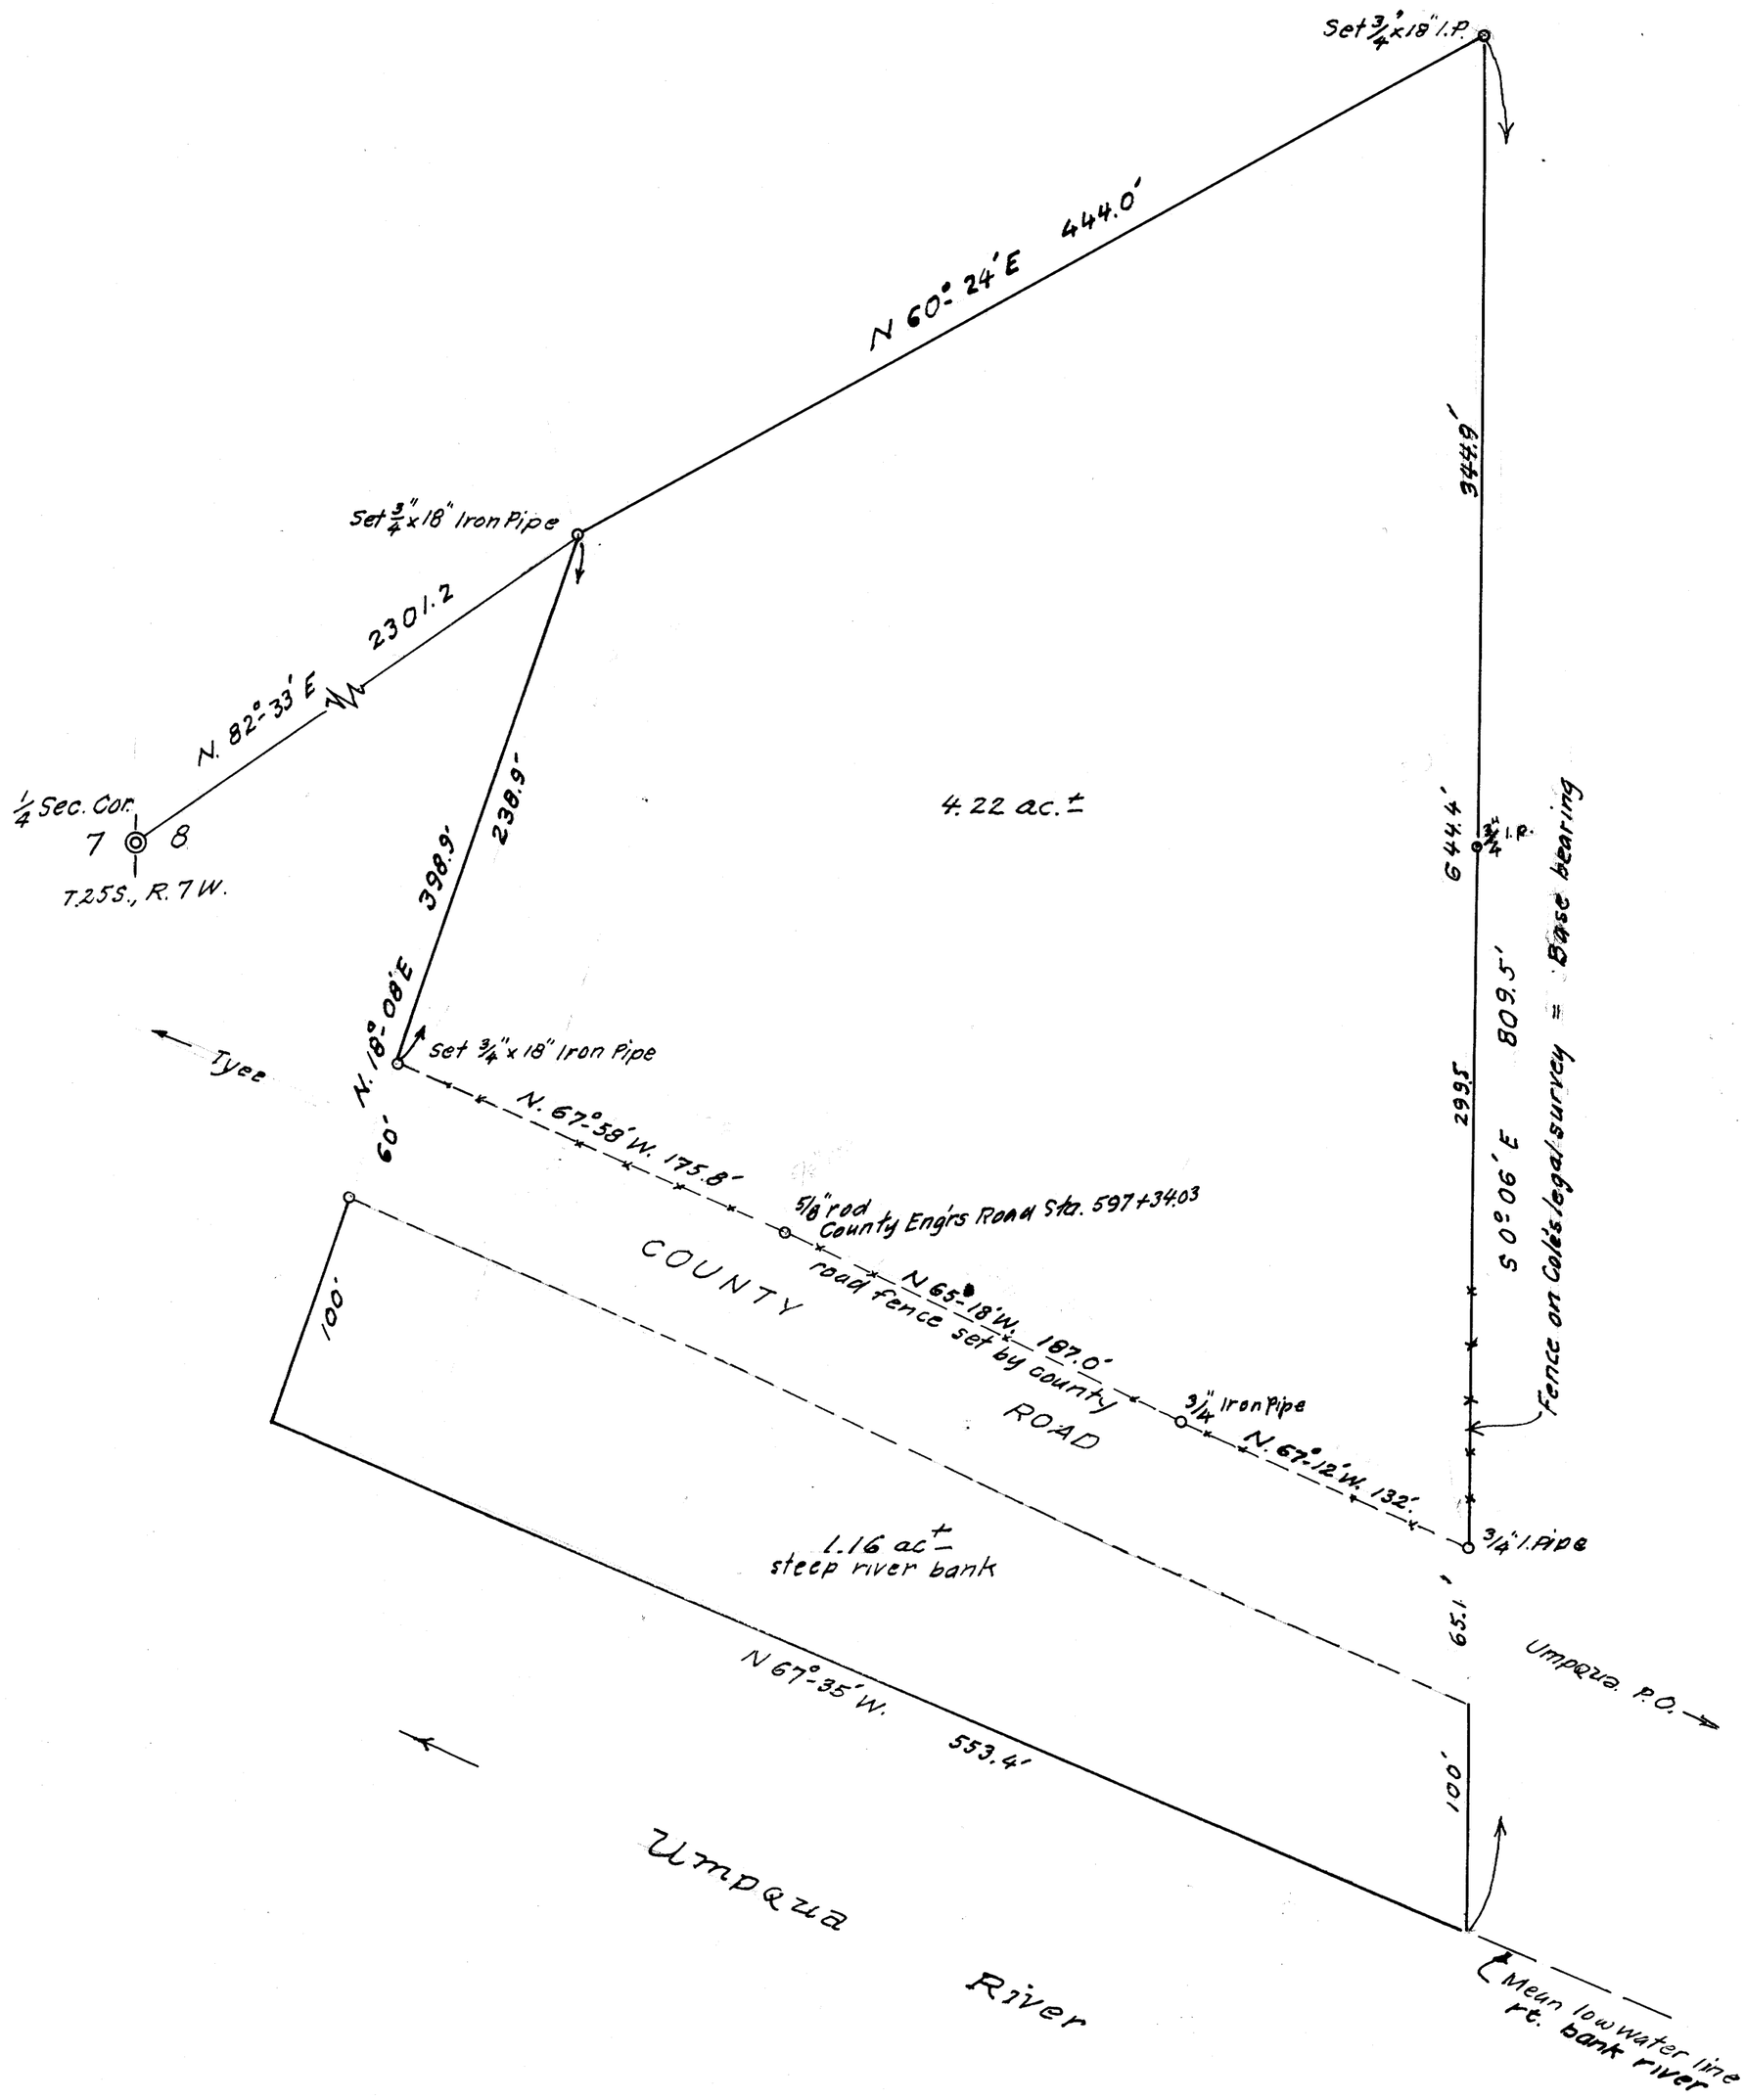

REGISTERED PROFESSIONAL ENGINEER 1981 OREGON MAY 5, 1933 ARTHUR BOYER

COUNTY SURVEYORS FILE DATA
DO NOT REMOVE FROM OFFICE

FILED
RECEIVED
MAY 5 1966
COUNTY SURVEYOR
DOUGLAS COUNTY, ORE.

ORVILLE JOHNSTONE TO HAROLD POWELL ET. UX.
IN W½ SEC. 8, T.25S; R.7W; W.M.
APR. 1966 1"=60 ft.

NOT POSTED

MAP FILE M-31 P-53

MAP FILE M-31 P-53