COUNTY SURVEYORS FILE DATA
DO NOT REMOVE FROM OFFICE

M 31 - 63

NURSING HOME SITE AT GARDEN VALLEY SHOPPING CENTER
SEC. 12, T 27 S, R 6 W. W. M.

ENGINEER — W. S. BARNES DEC. 1965

SCALE 1" = 60'

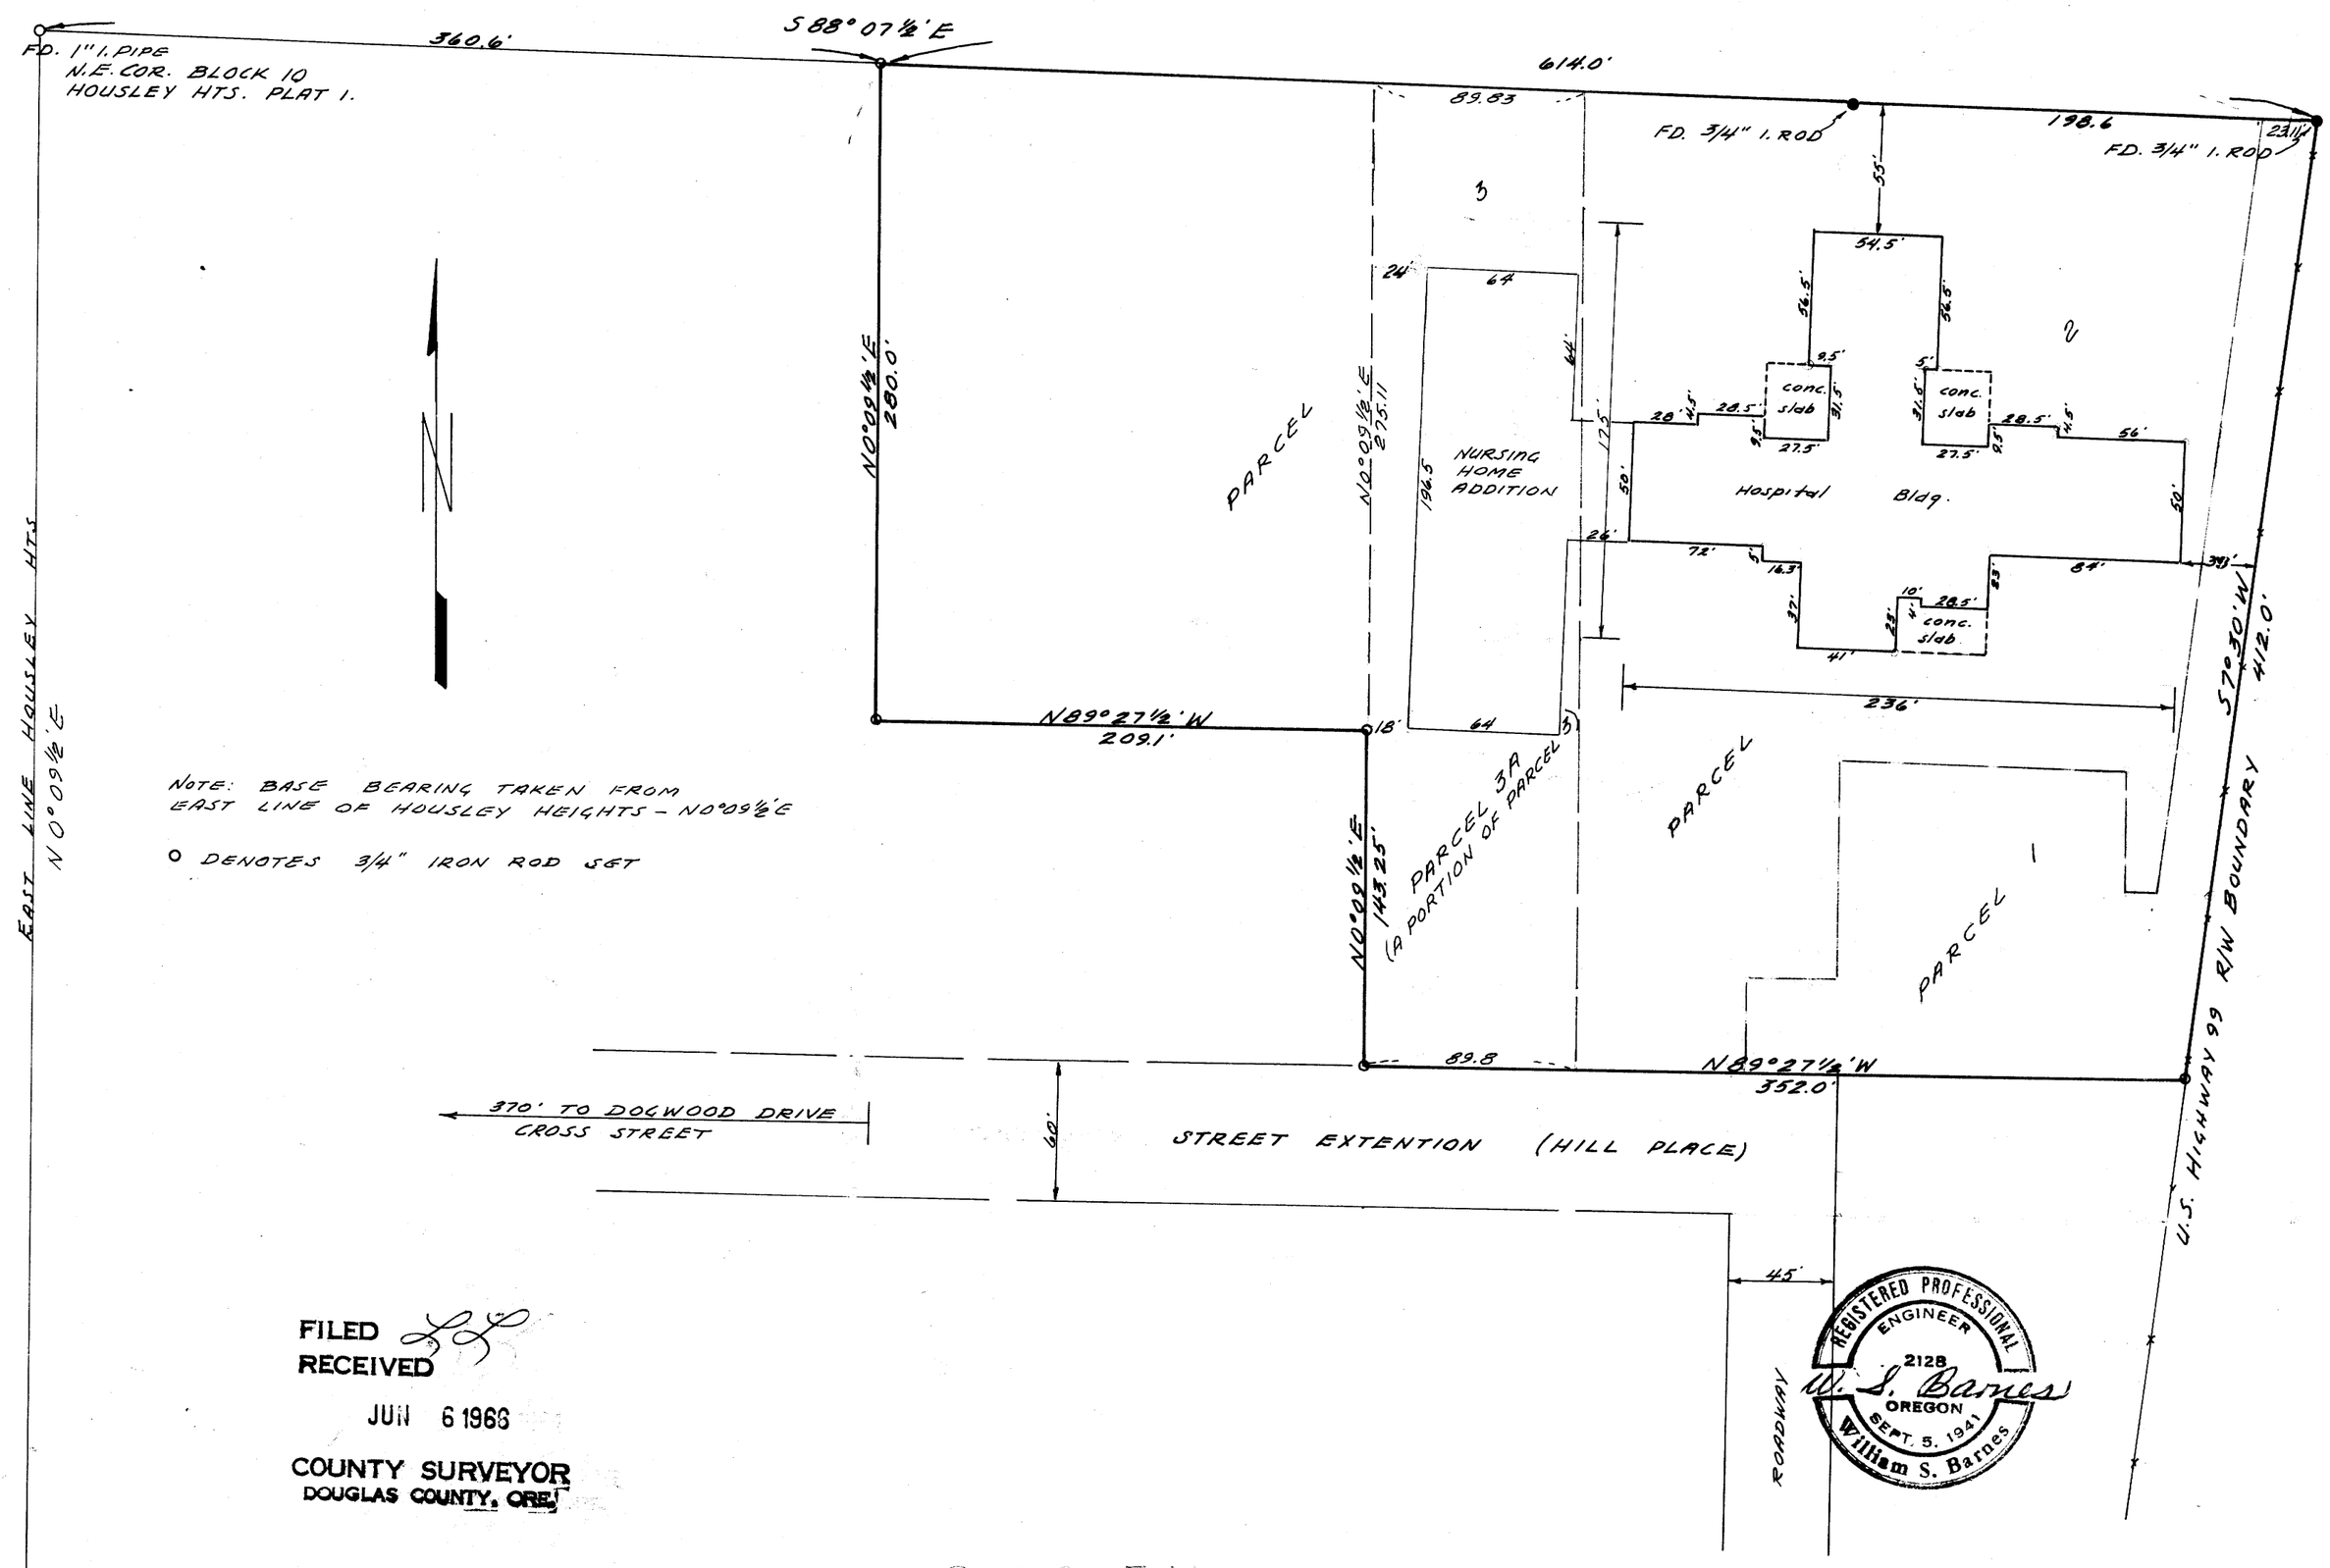

FILED
RECEIVED
JUN 6 1966
COUNTY SURVEYOR
DOUGLAS COUNTY, ORE.

MAP FILE M 31 - 63

PLATTED JW.S.