MAP FILE M-31 P-76

COUNTY SURVEYORS FILE DATA
DO NOT REMOVE FROM OFFICE

SURVEY IN SEC. 6, T26S, R5W. W.M.

SURVEYED FOR - K.W. KNECHTEL
SURVEYED BY - W.S. BARNES

JULY 1966
SCALE 1"=200'

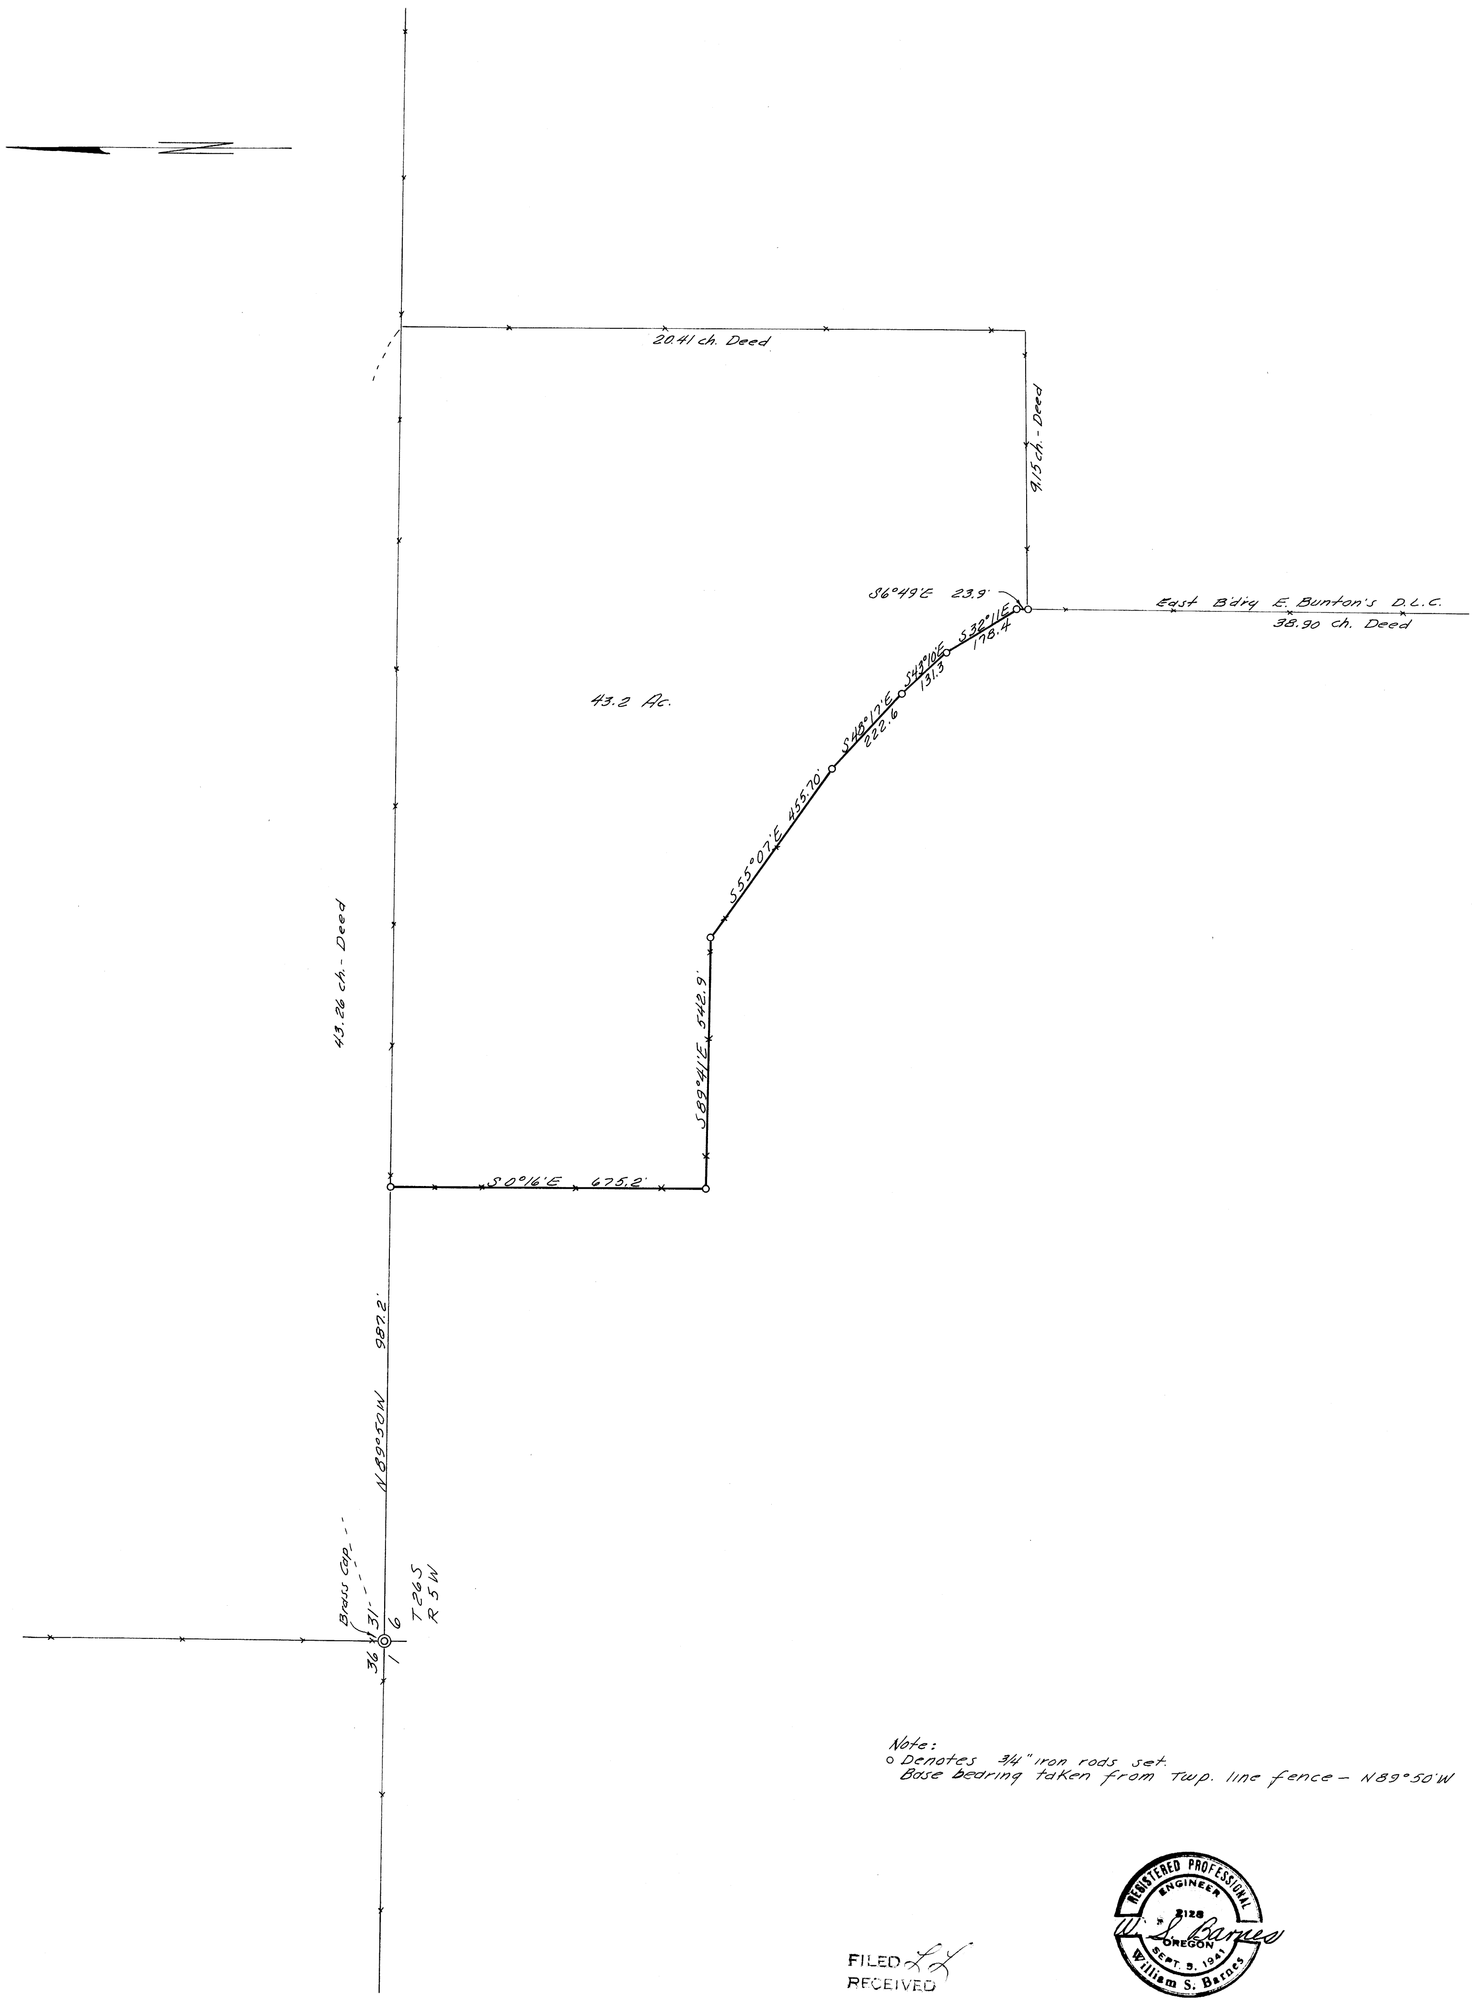

Note:
o Denotes 3/4" iron rods set.
Base bearing taken from Twp. line fence - N89°50'W

REGISTERED PROFESSIONAL ENGINEER
3128
OREGON
SEPT. 9, 1941
William S. Barnes

FILED
RECEIVED
JUL 20 1966
COUNTY SURVEYOR
DOUGLAS COUNTY, ORE.

MAP FILE M-31 P-76