MAP FILE M32 # 13

COUNTY SURVEYORS FILE DATA
DO NOT REMOVE FROM OFFICE

SURVEY IN LOTS 3, 4 & 5, PLAT "L", S. L. & W. CO. DOUGLAS COUNTY, ORE.

ENGINEER - W. S. BARNES
FOR - BOB CRAWFORD

SCALE 1" = 30'

AUG. 1966

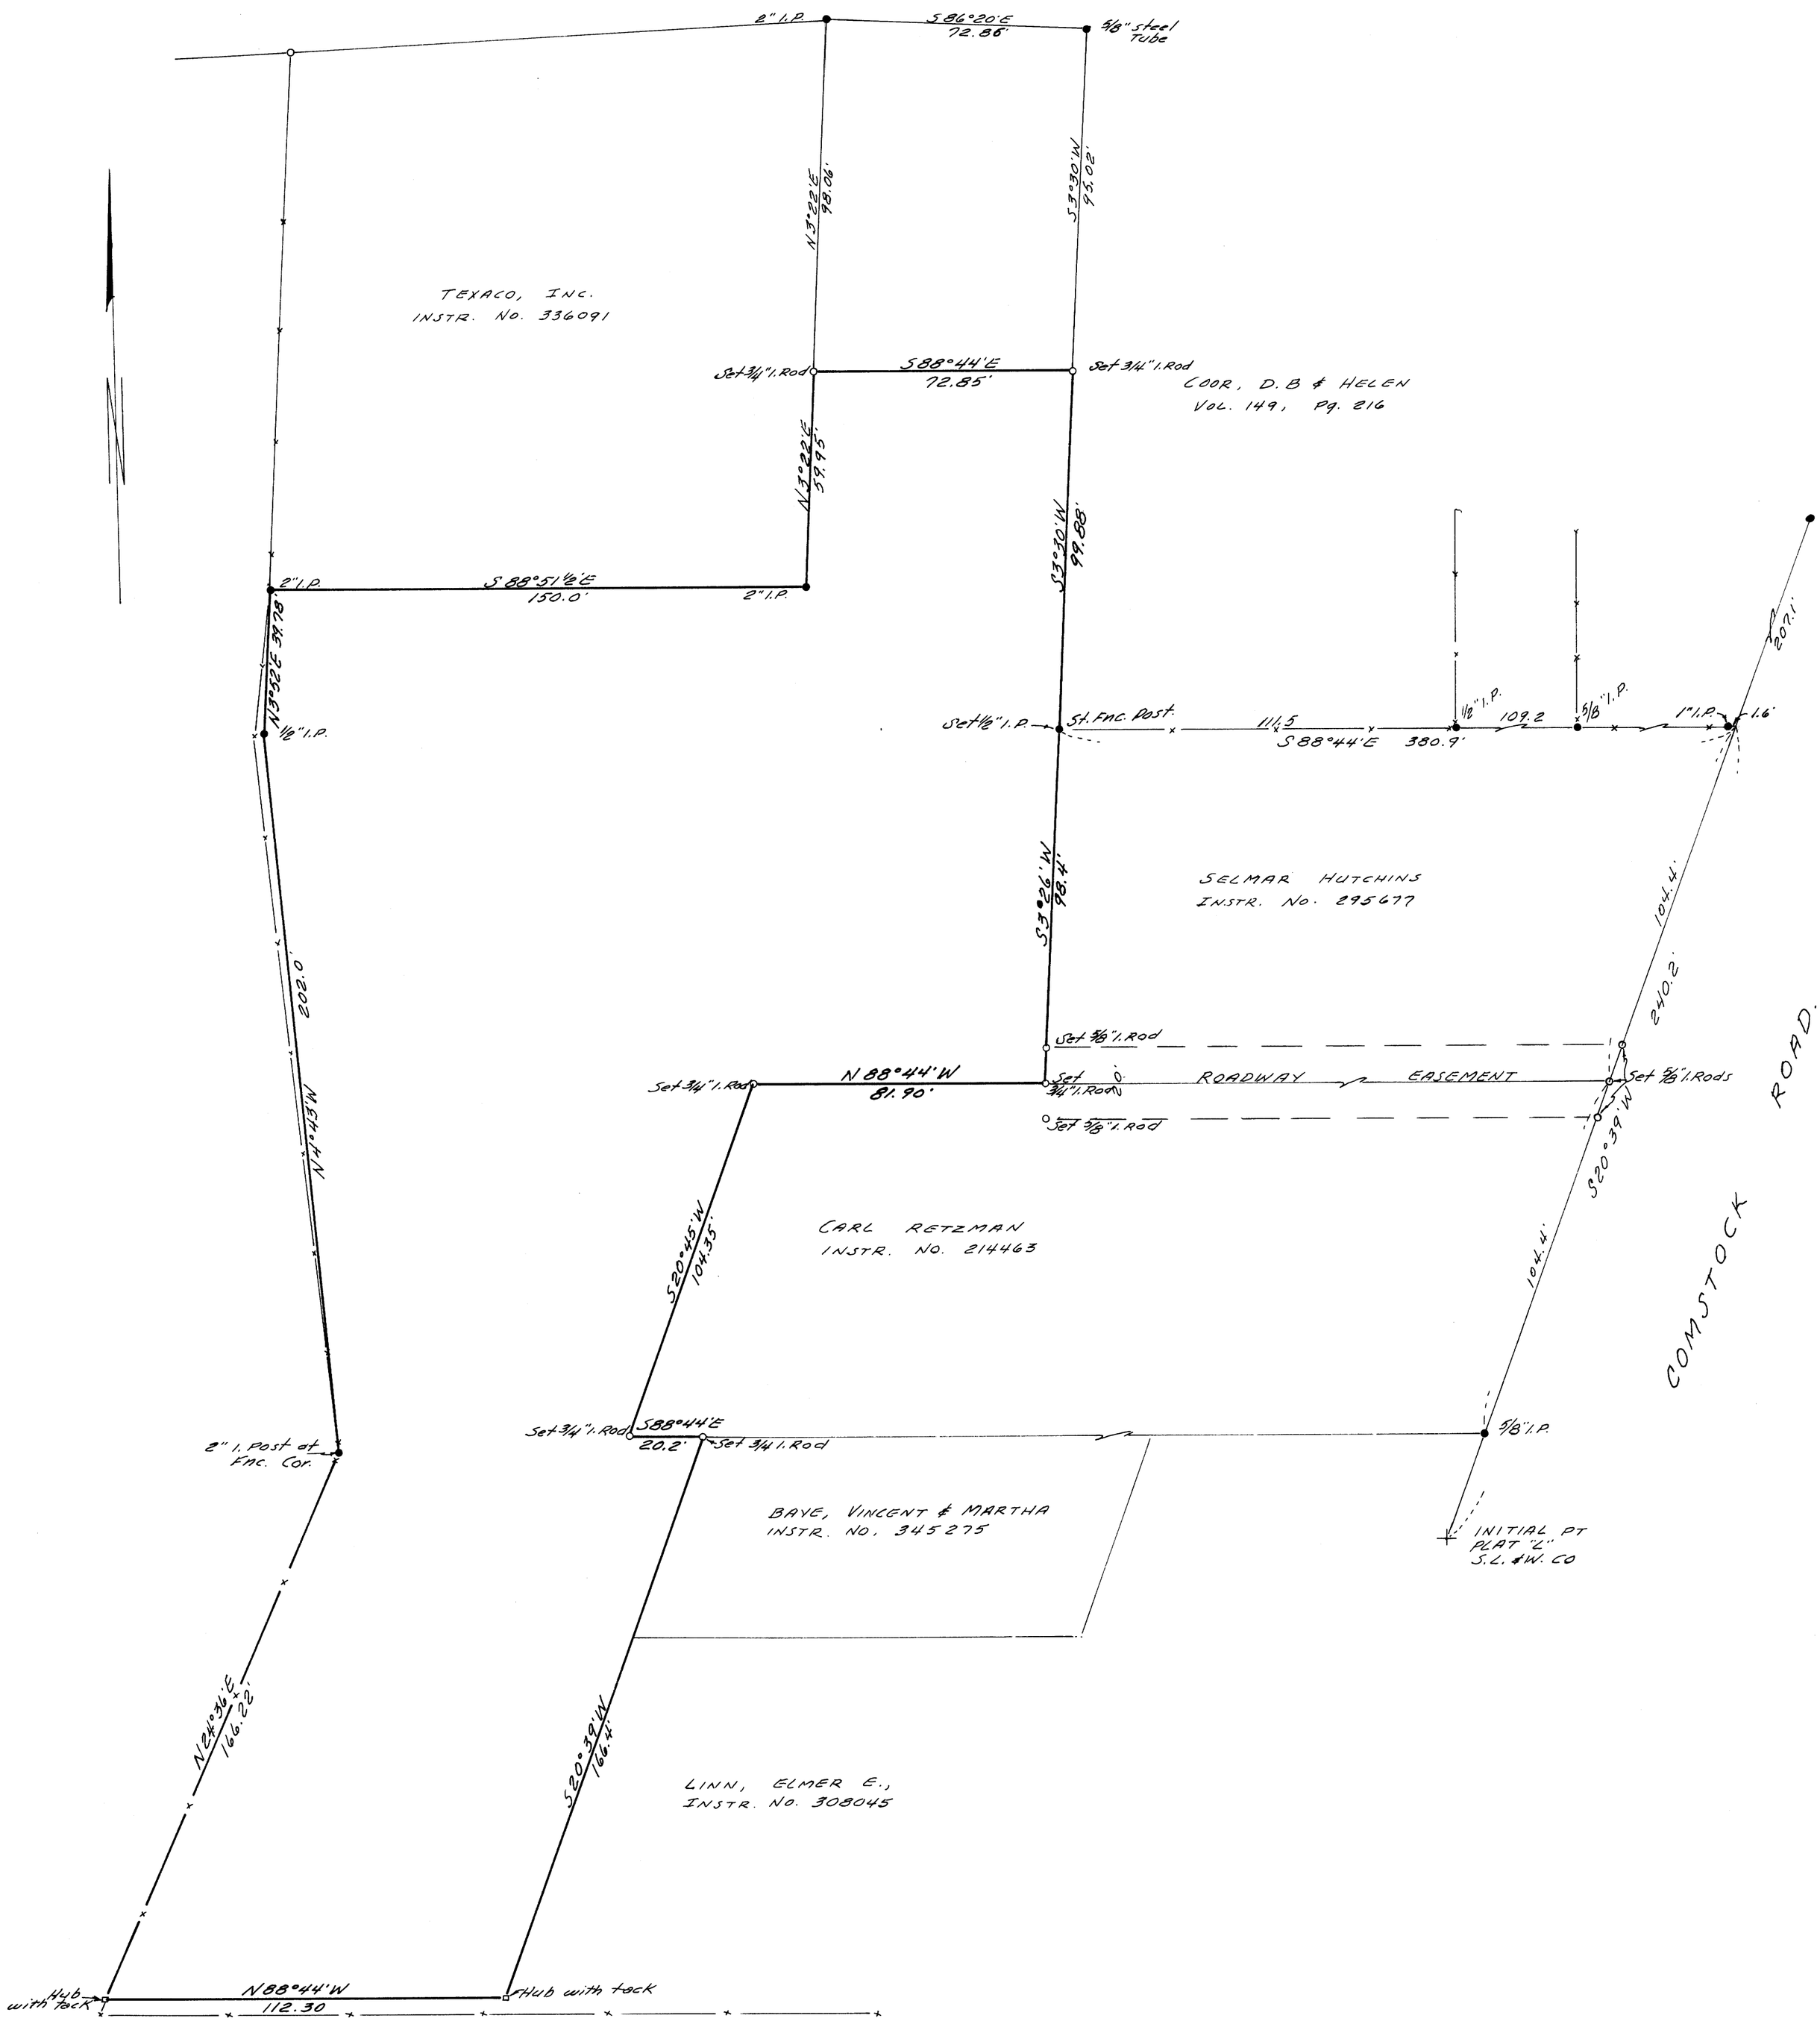

Note: Base bearing taken from south lot line of Coor property - S 88°44'E.

- ● Denotes monuments found.
- ○ " " set.

FILED
RECEIVED
AUG 25 1966
COUNTY SURVEYOR
DOUGLAS COUNTY, ORE.

REGISTERED PROFESSIONAL ENGINEER
2128
OREGON
SEPT. 5, 1941
William S. Barnes

MAP FILE M32 # 13