COUNTY SURVEYORS FILE DATA
DO NOT REMOVE FROM OFFICE

SURVEY FOR JUNE CAPE & DOUGLAS SHORT
SECTIONS 9, 15, 16, 21 & 22 T 26S, R5W, W.M.

EIMSTAD & ASSOCIATES
1717 WASHINGTON EUGENE
SEPTEMBER 1966
SCALE
1 INCH = 600 FEET

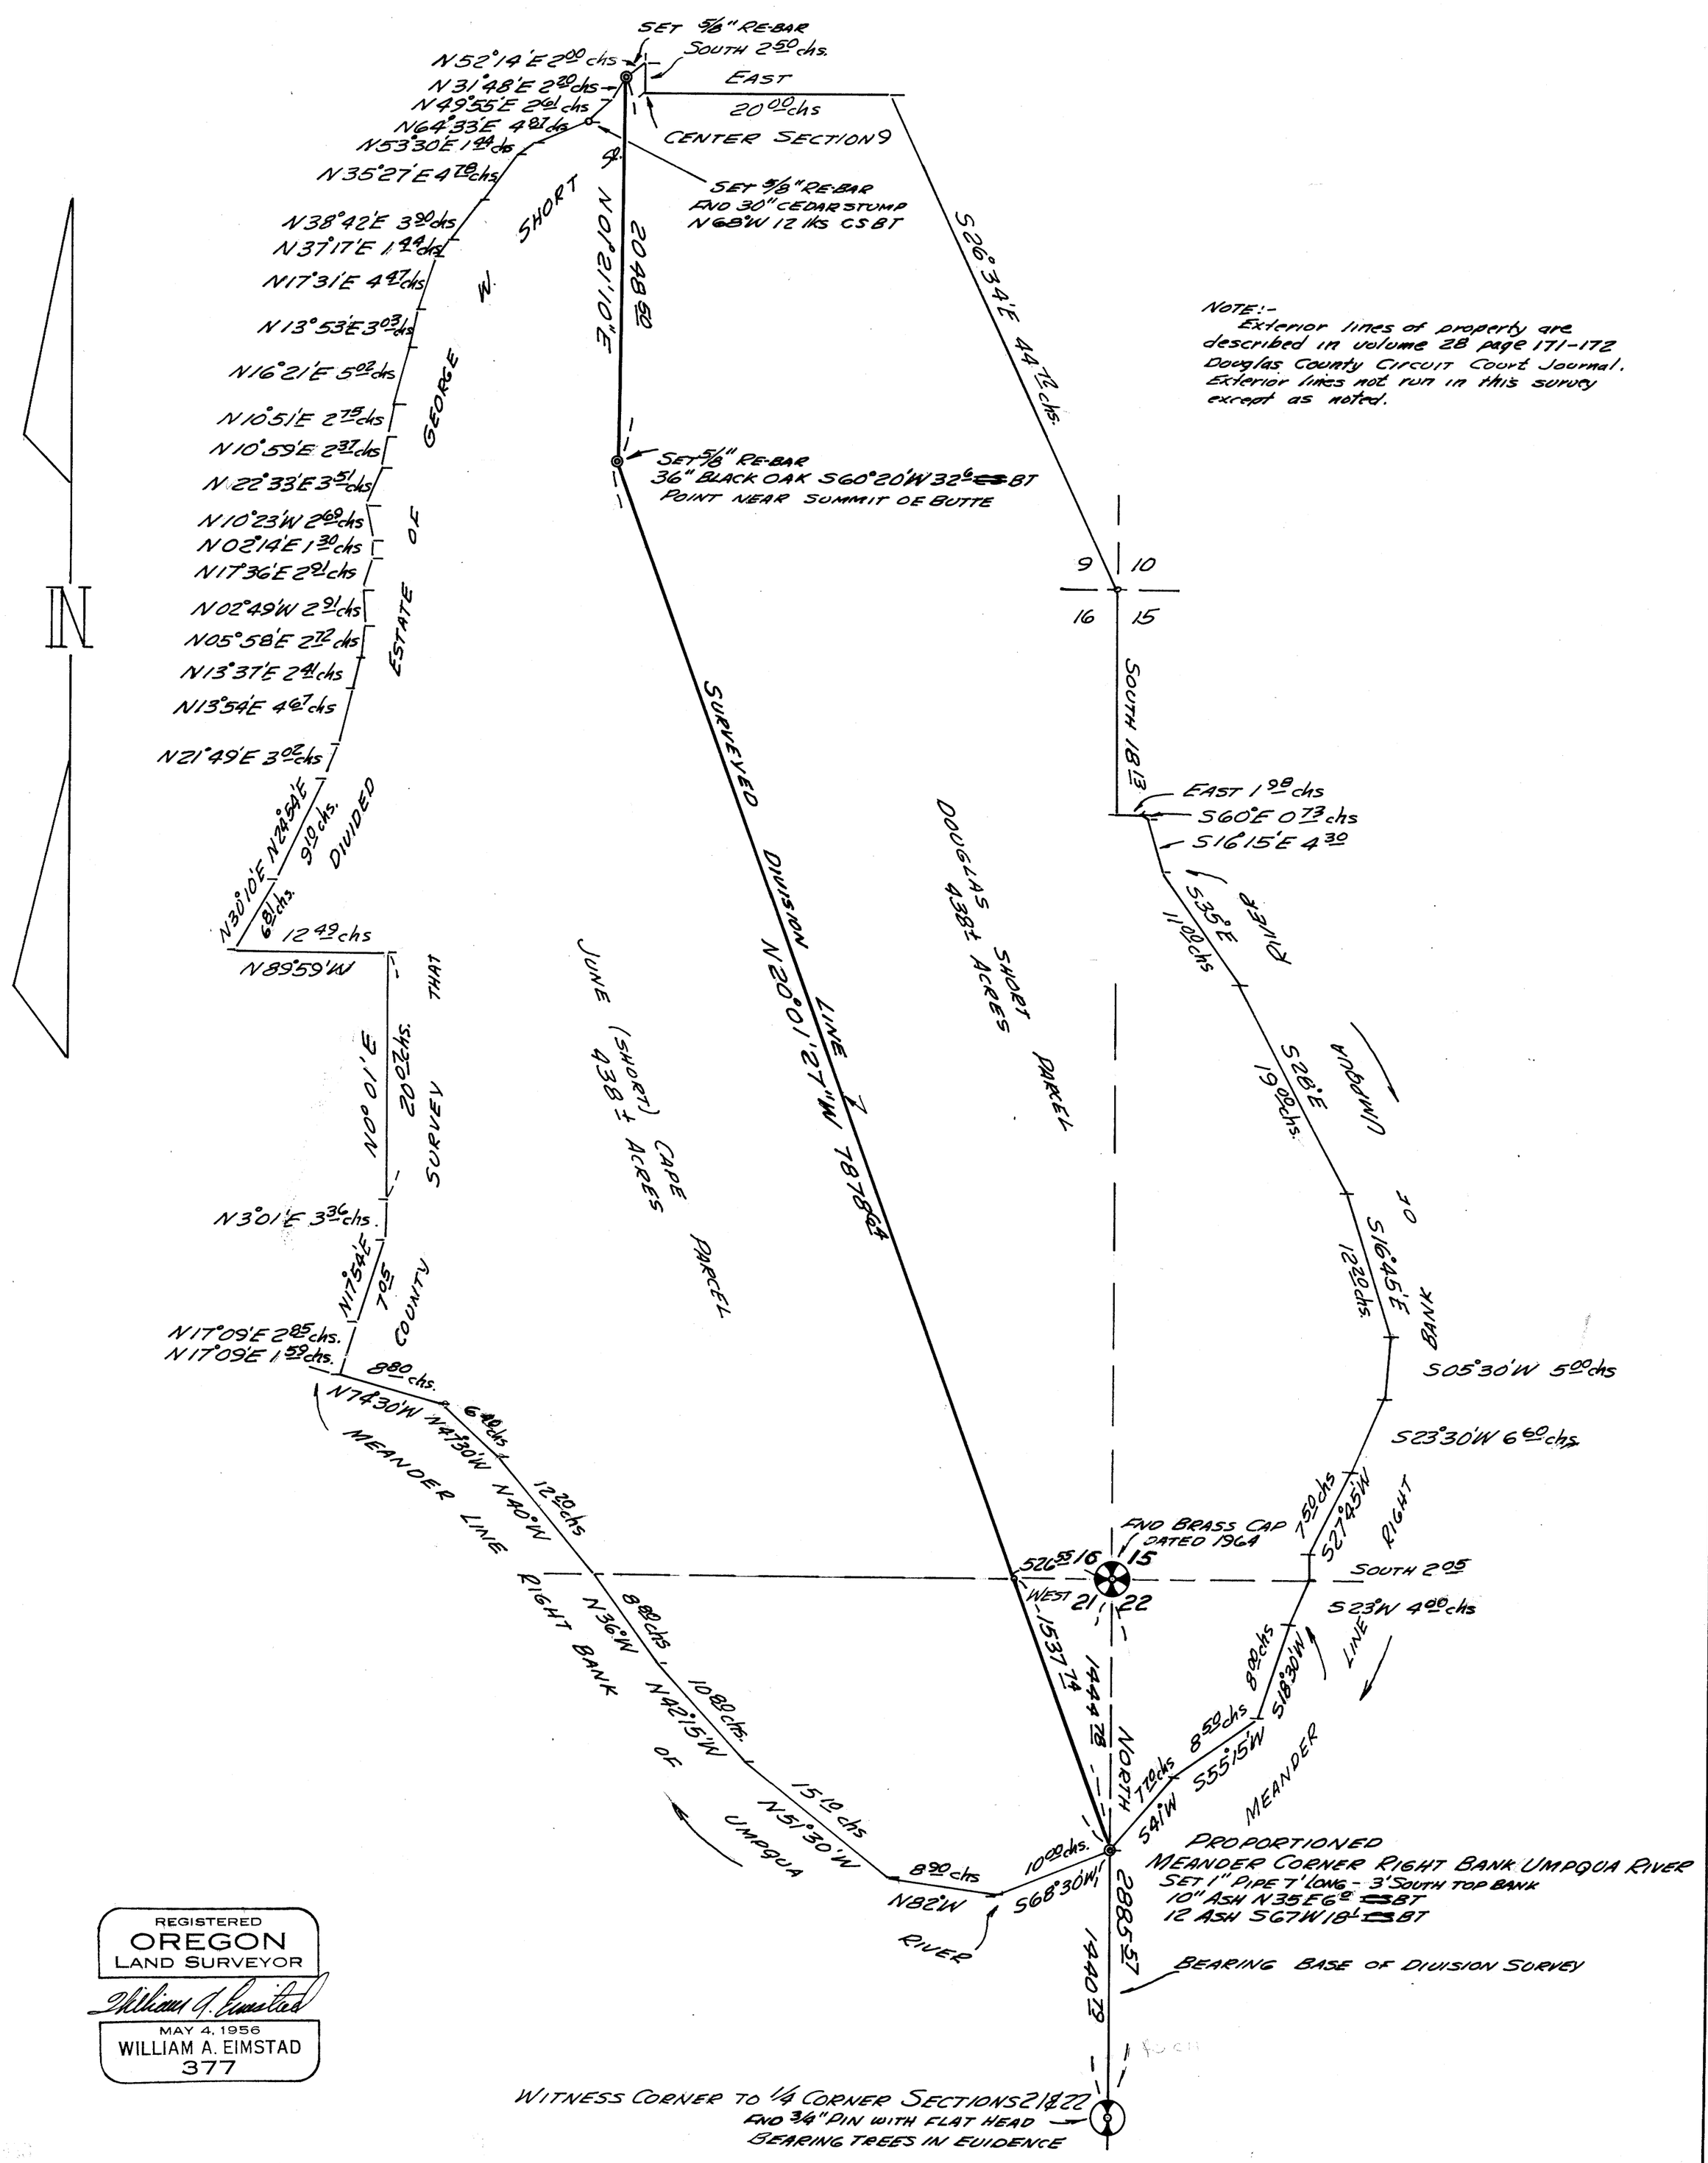

NOTE:-
Exterior lines of property are described in volume 28 page 171-172 Douglas County Circuit Court Journal. Exterior lines not run in this survey except as noted.

REGISTERED
OREGON
LAND SURVEYOR
William A. Eimstad
MAY 4, 1956
WILLIAM A. EIMSTAD
377

FILED
RECEIVED
OCT 2 1966
COUNTY SURVEYOR
DOUGLAS COUNTY, ORE.

MAP FILE M 32 p 30