MAP FILE M32 F 33

COUNTY SURVEYORS FILE DATA
DO NOT REMOVE FROM OFFICE

A SURVEY TO ESTABLISH PROP. CORS.
IN S14 T26S R5W W.M. DOUGLAS CO. ORE.

SURVEYED FOR ROSEBURG REALTY & INS. CO., OCT 12, 1966
SURVEYED BY DON E. GARRETT SCALE 1"=200'

REGISTERED
OREGON
LAND SURVEYOR
Don E. Garrett
JULY 14, 1961
DON E. GARRETT
544

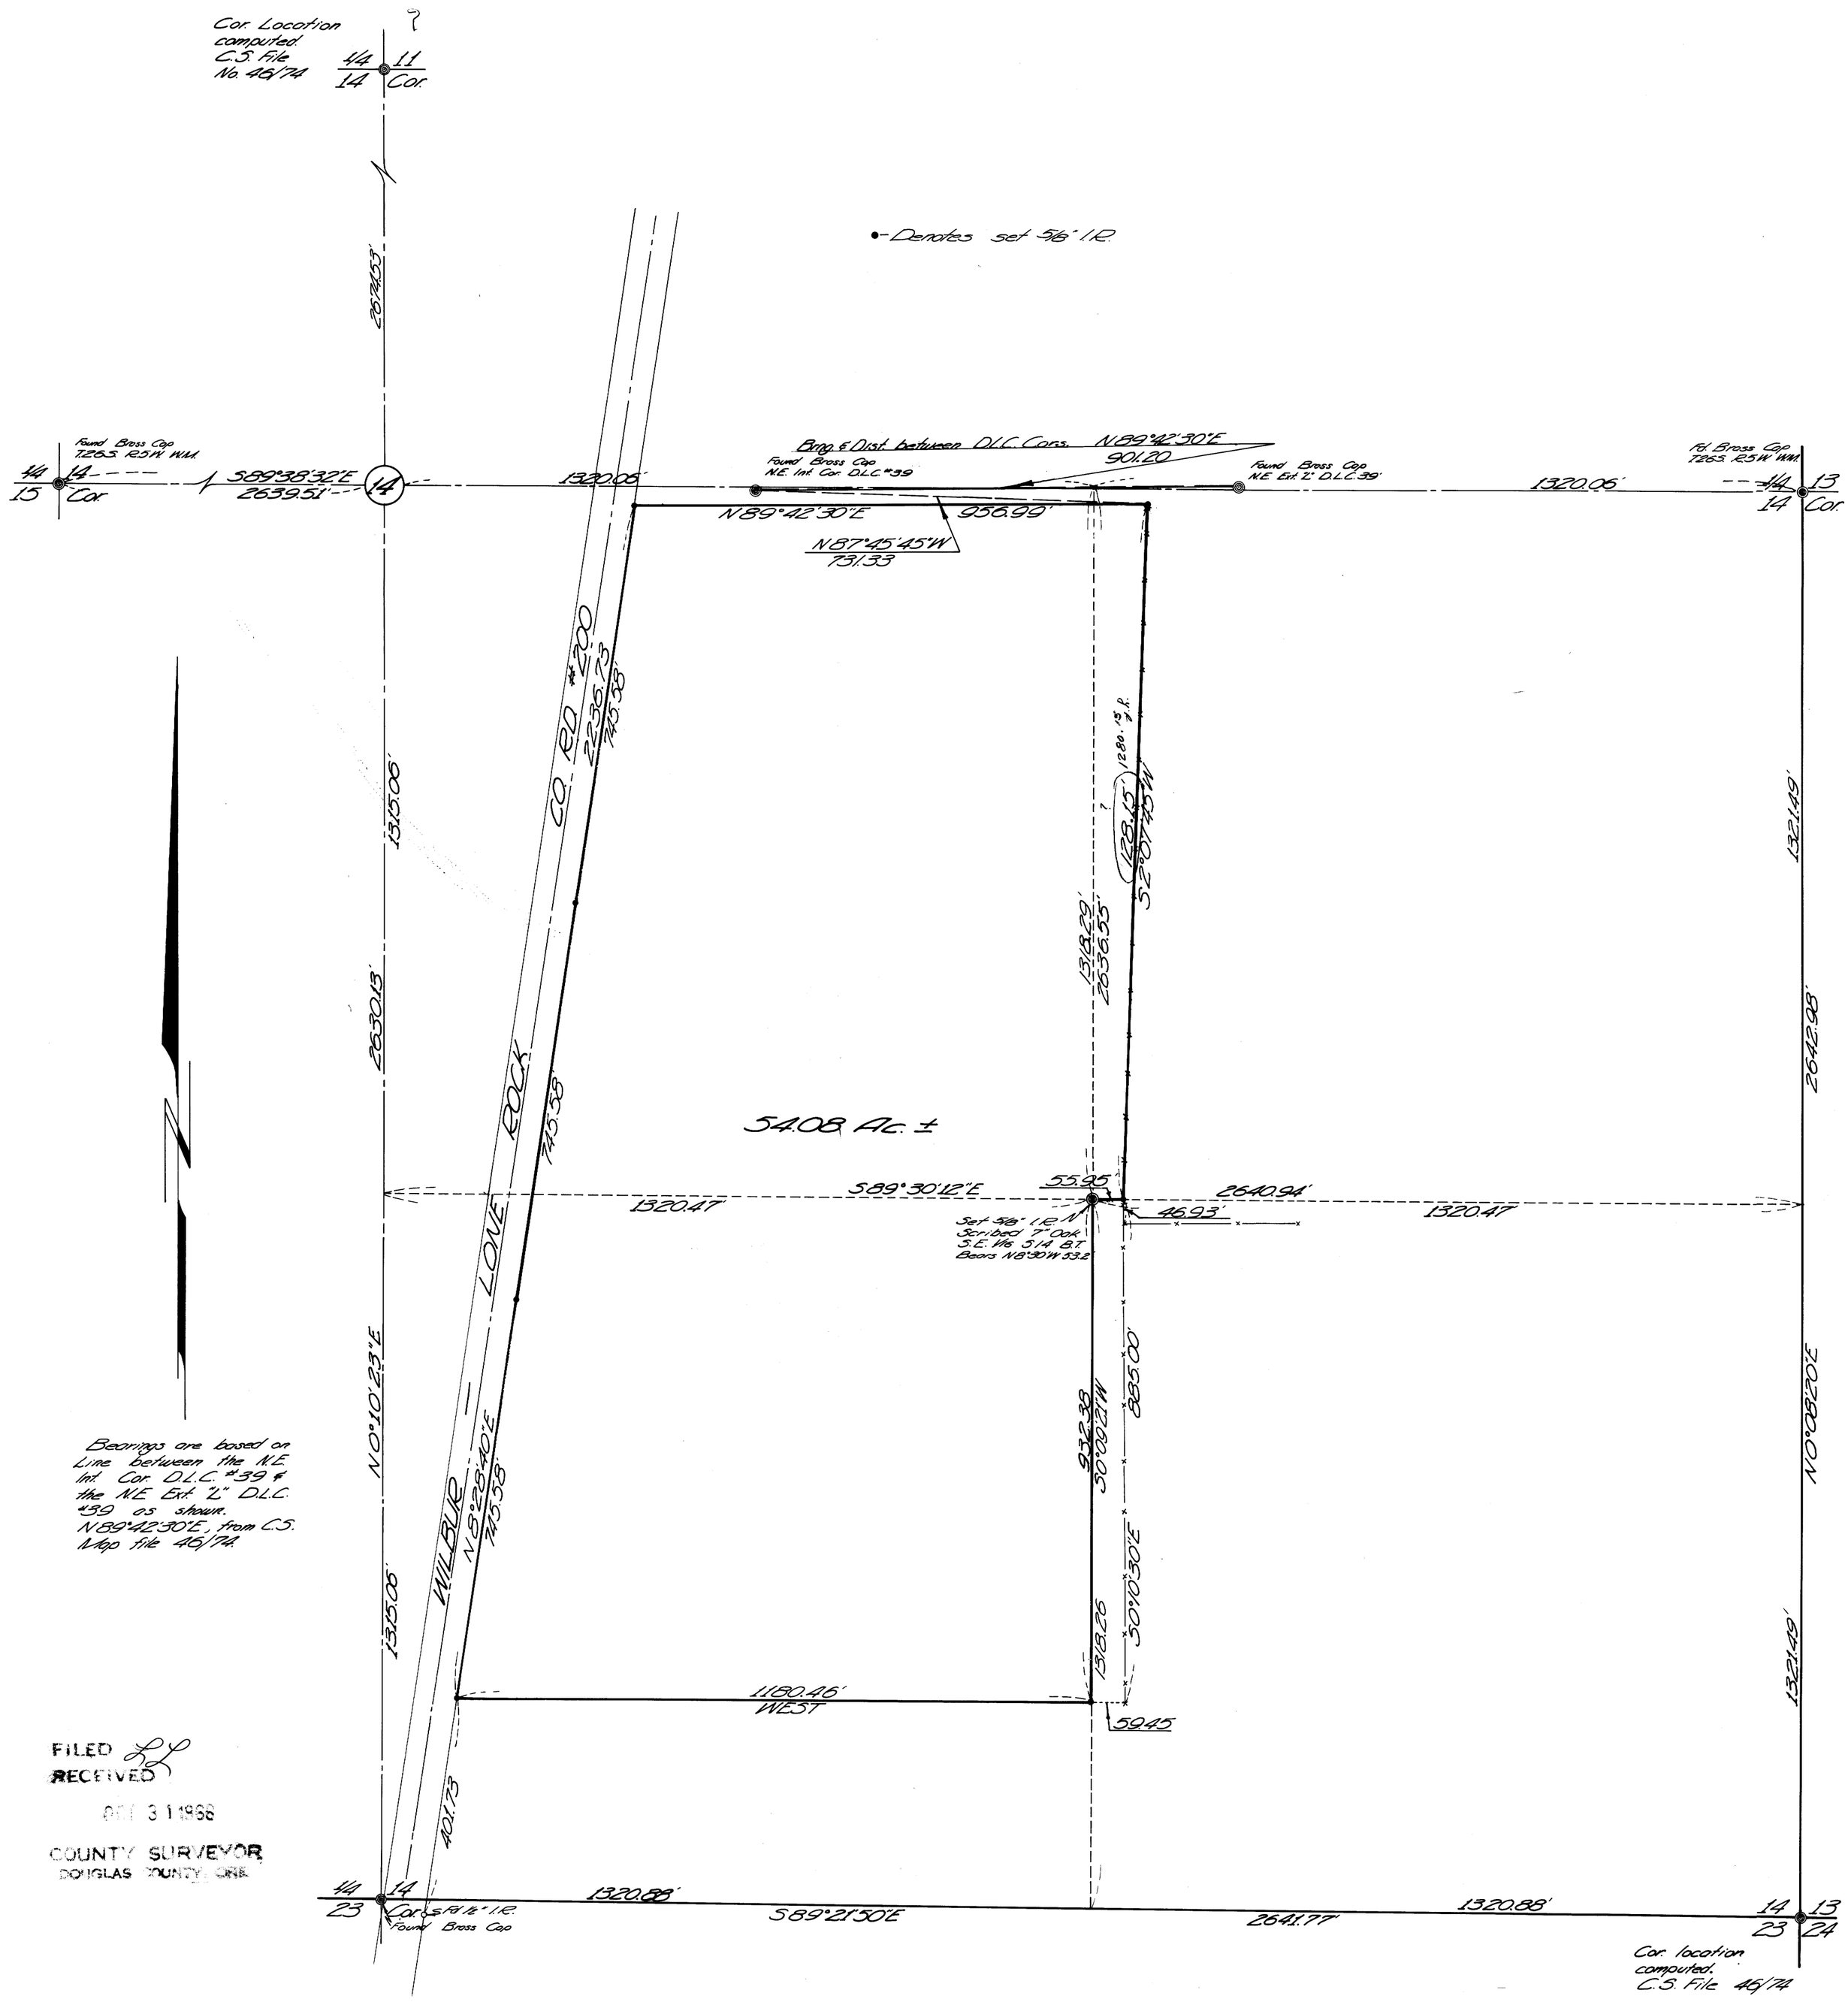

Bearings are based on Line between the N.E. Int. Cor. D.L.C. #39 & the N.E. Ext. "L" D.L.C. #39 as shown. N89°42'30"E, from C.S. Map file 46/74.

FILED
RECEIVED
OCT 3 1 1966
COUNTY SURVEYOR
DOUGLAS COUNTY, ORE.

MAP FILE M32 F 33