F.B. H-8
MAP FILE M32 P 34

SECT 33, T. 20 S., R 6 W W.M

Scale: 1" = 500'

Oct. 1966

Woolley Logging Co.

Drain Oreg.

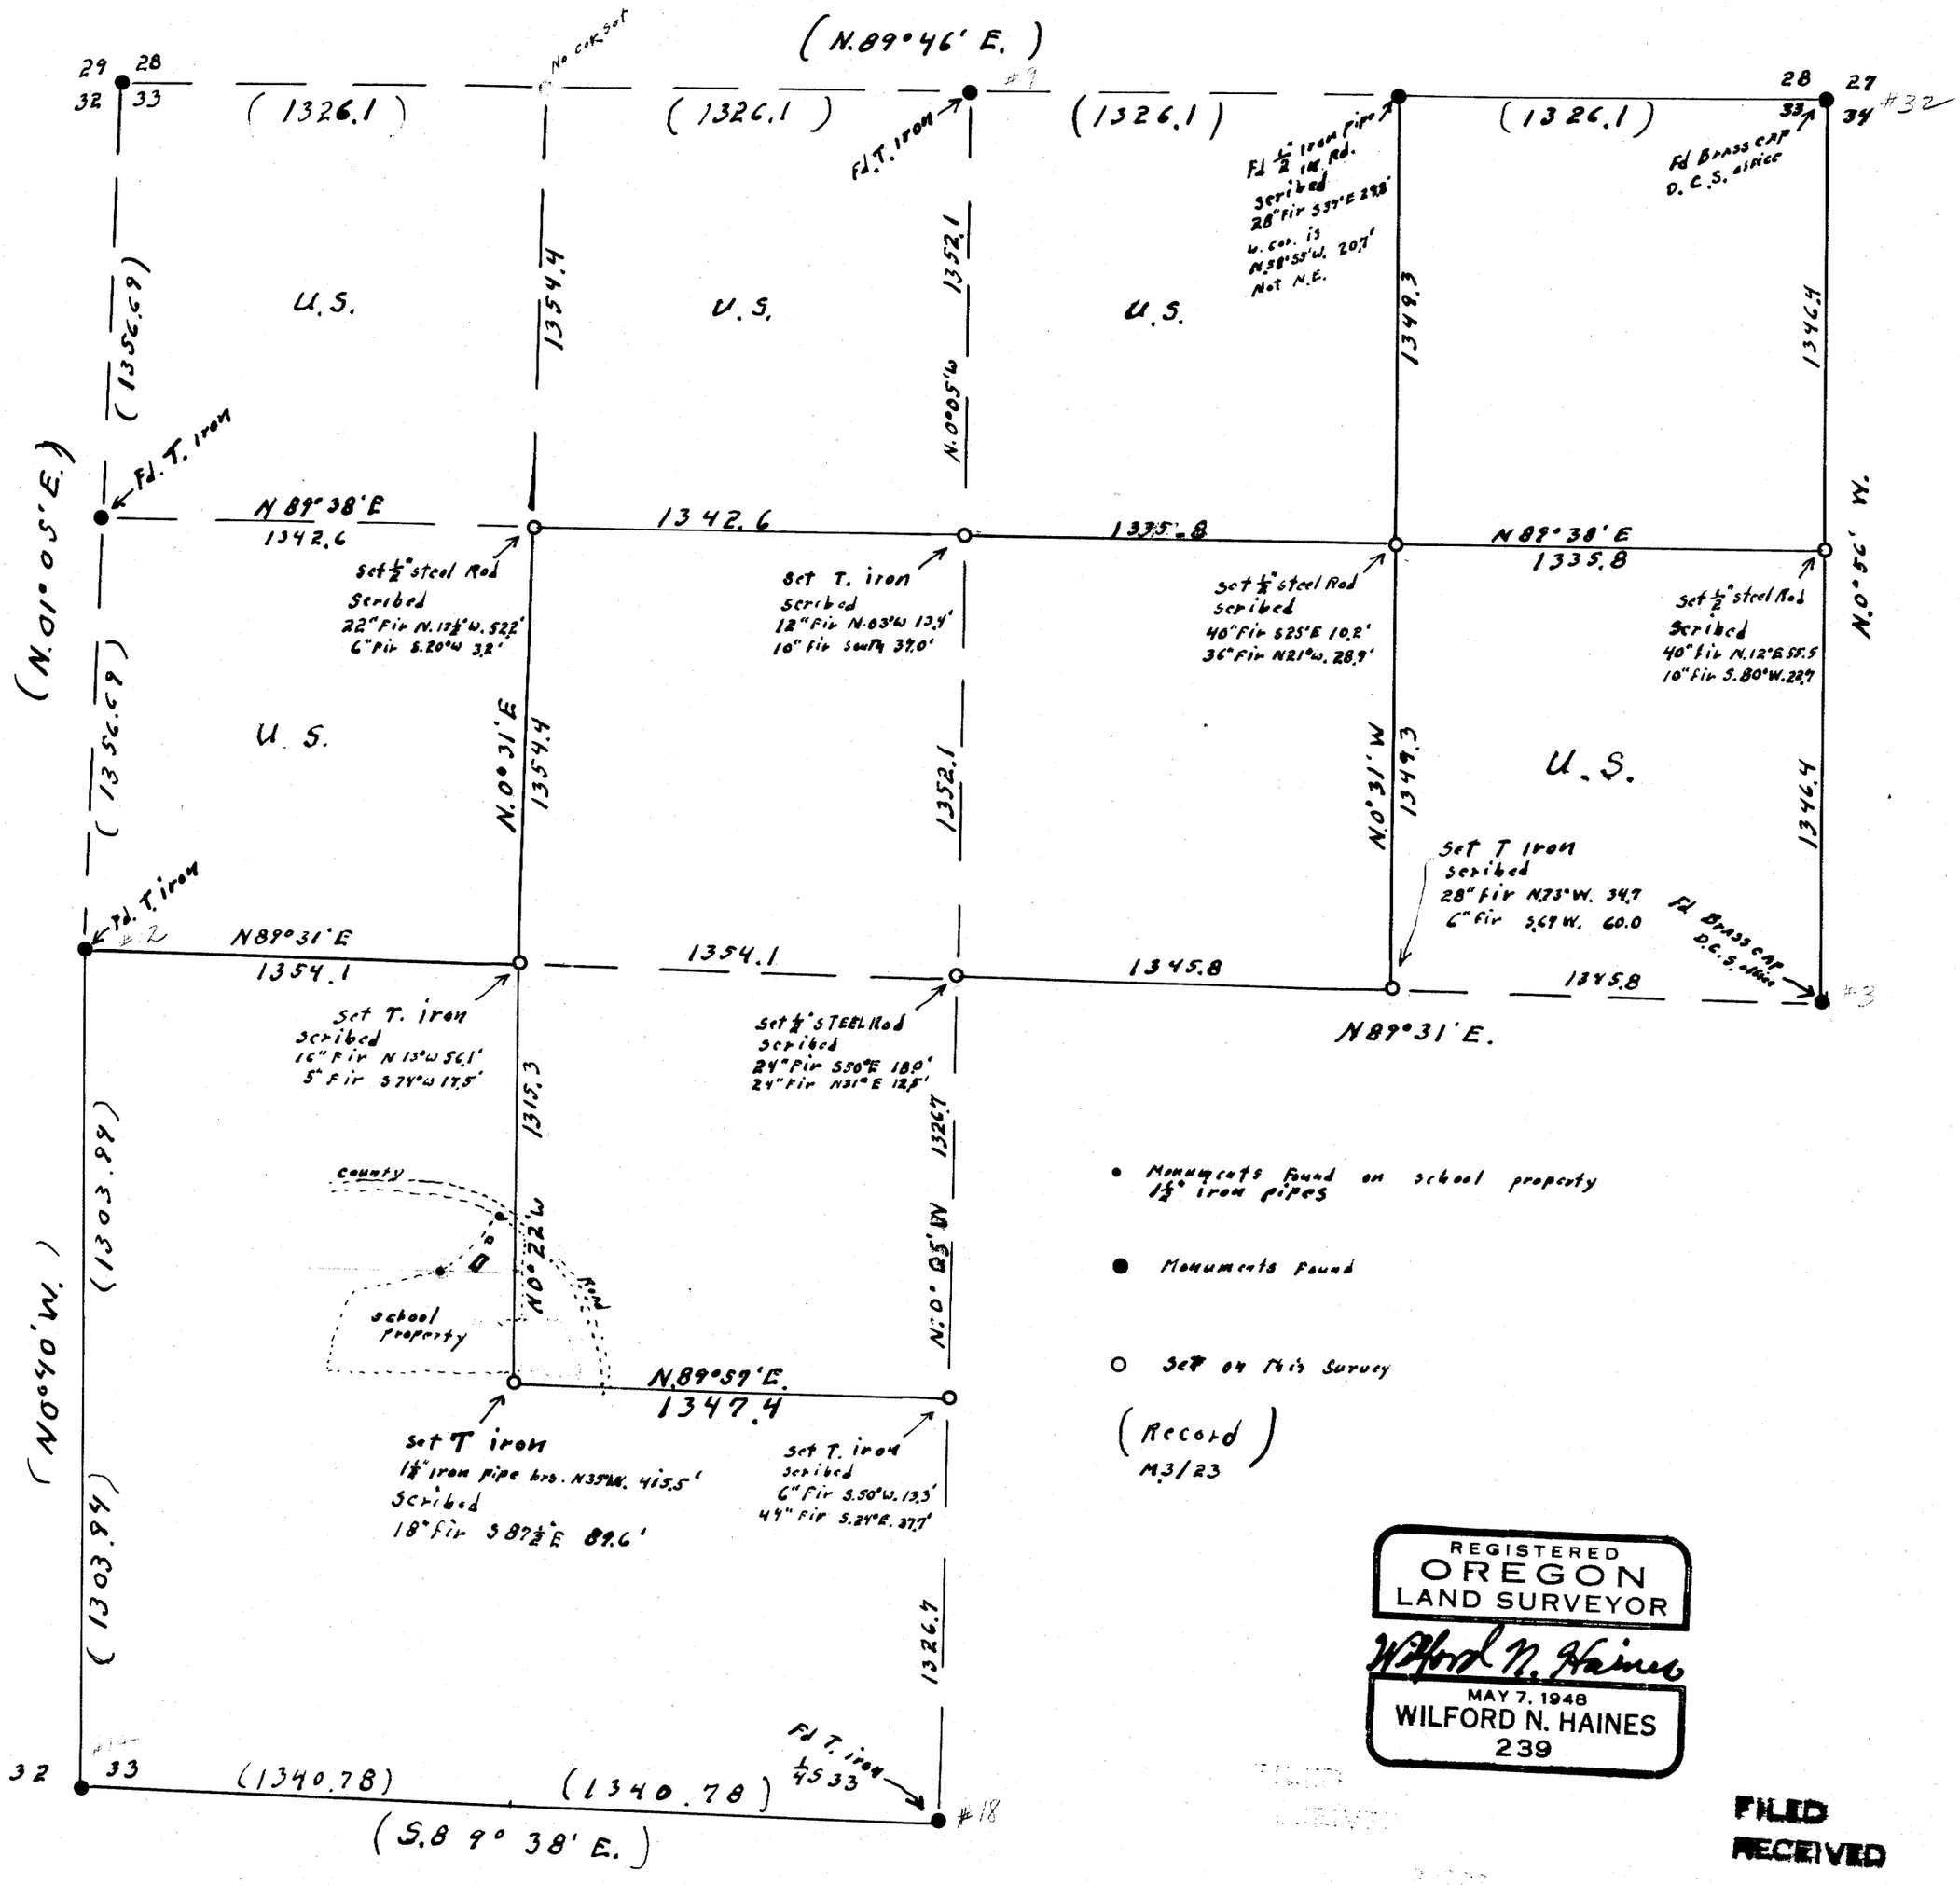

• Monuments found on school property 1½" iron pipes

● Monuments found

○ Set on this Survey

(Record)
M.3/23

REGISTERED
OREGON
LAND SURVEYOR
Wilford N. Haines
MAY 7, 1948
WILFORD N. HAINES
239

FILED
RECEIVED
NOV 3 1966
COUNTY SURVEYOR
DOUGLAS COUNTY, ORE.

F.B. H-8
MAP FILE M 32 P 34

2