[redacted]

SECT. 15, T. 22 S., R. 6 W. W.M.

LEWIS M. + BERNICE D. JOHNSRUD DRAIN, OREGON

SCALE: 1" = 400' DEC. 3, 1966

REGISTERED
OREGON
LAND SURVEYOR
Wilford N Haines
MAY 7, 1948
WILFORD N. HAINES
239

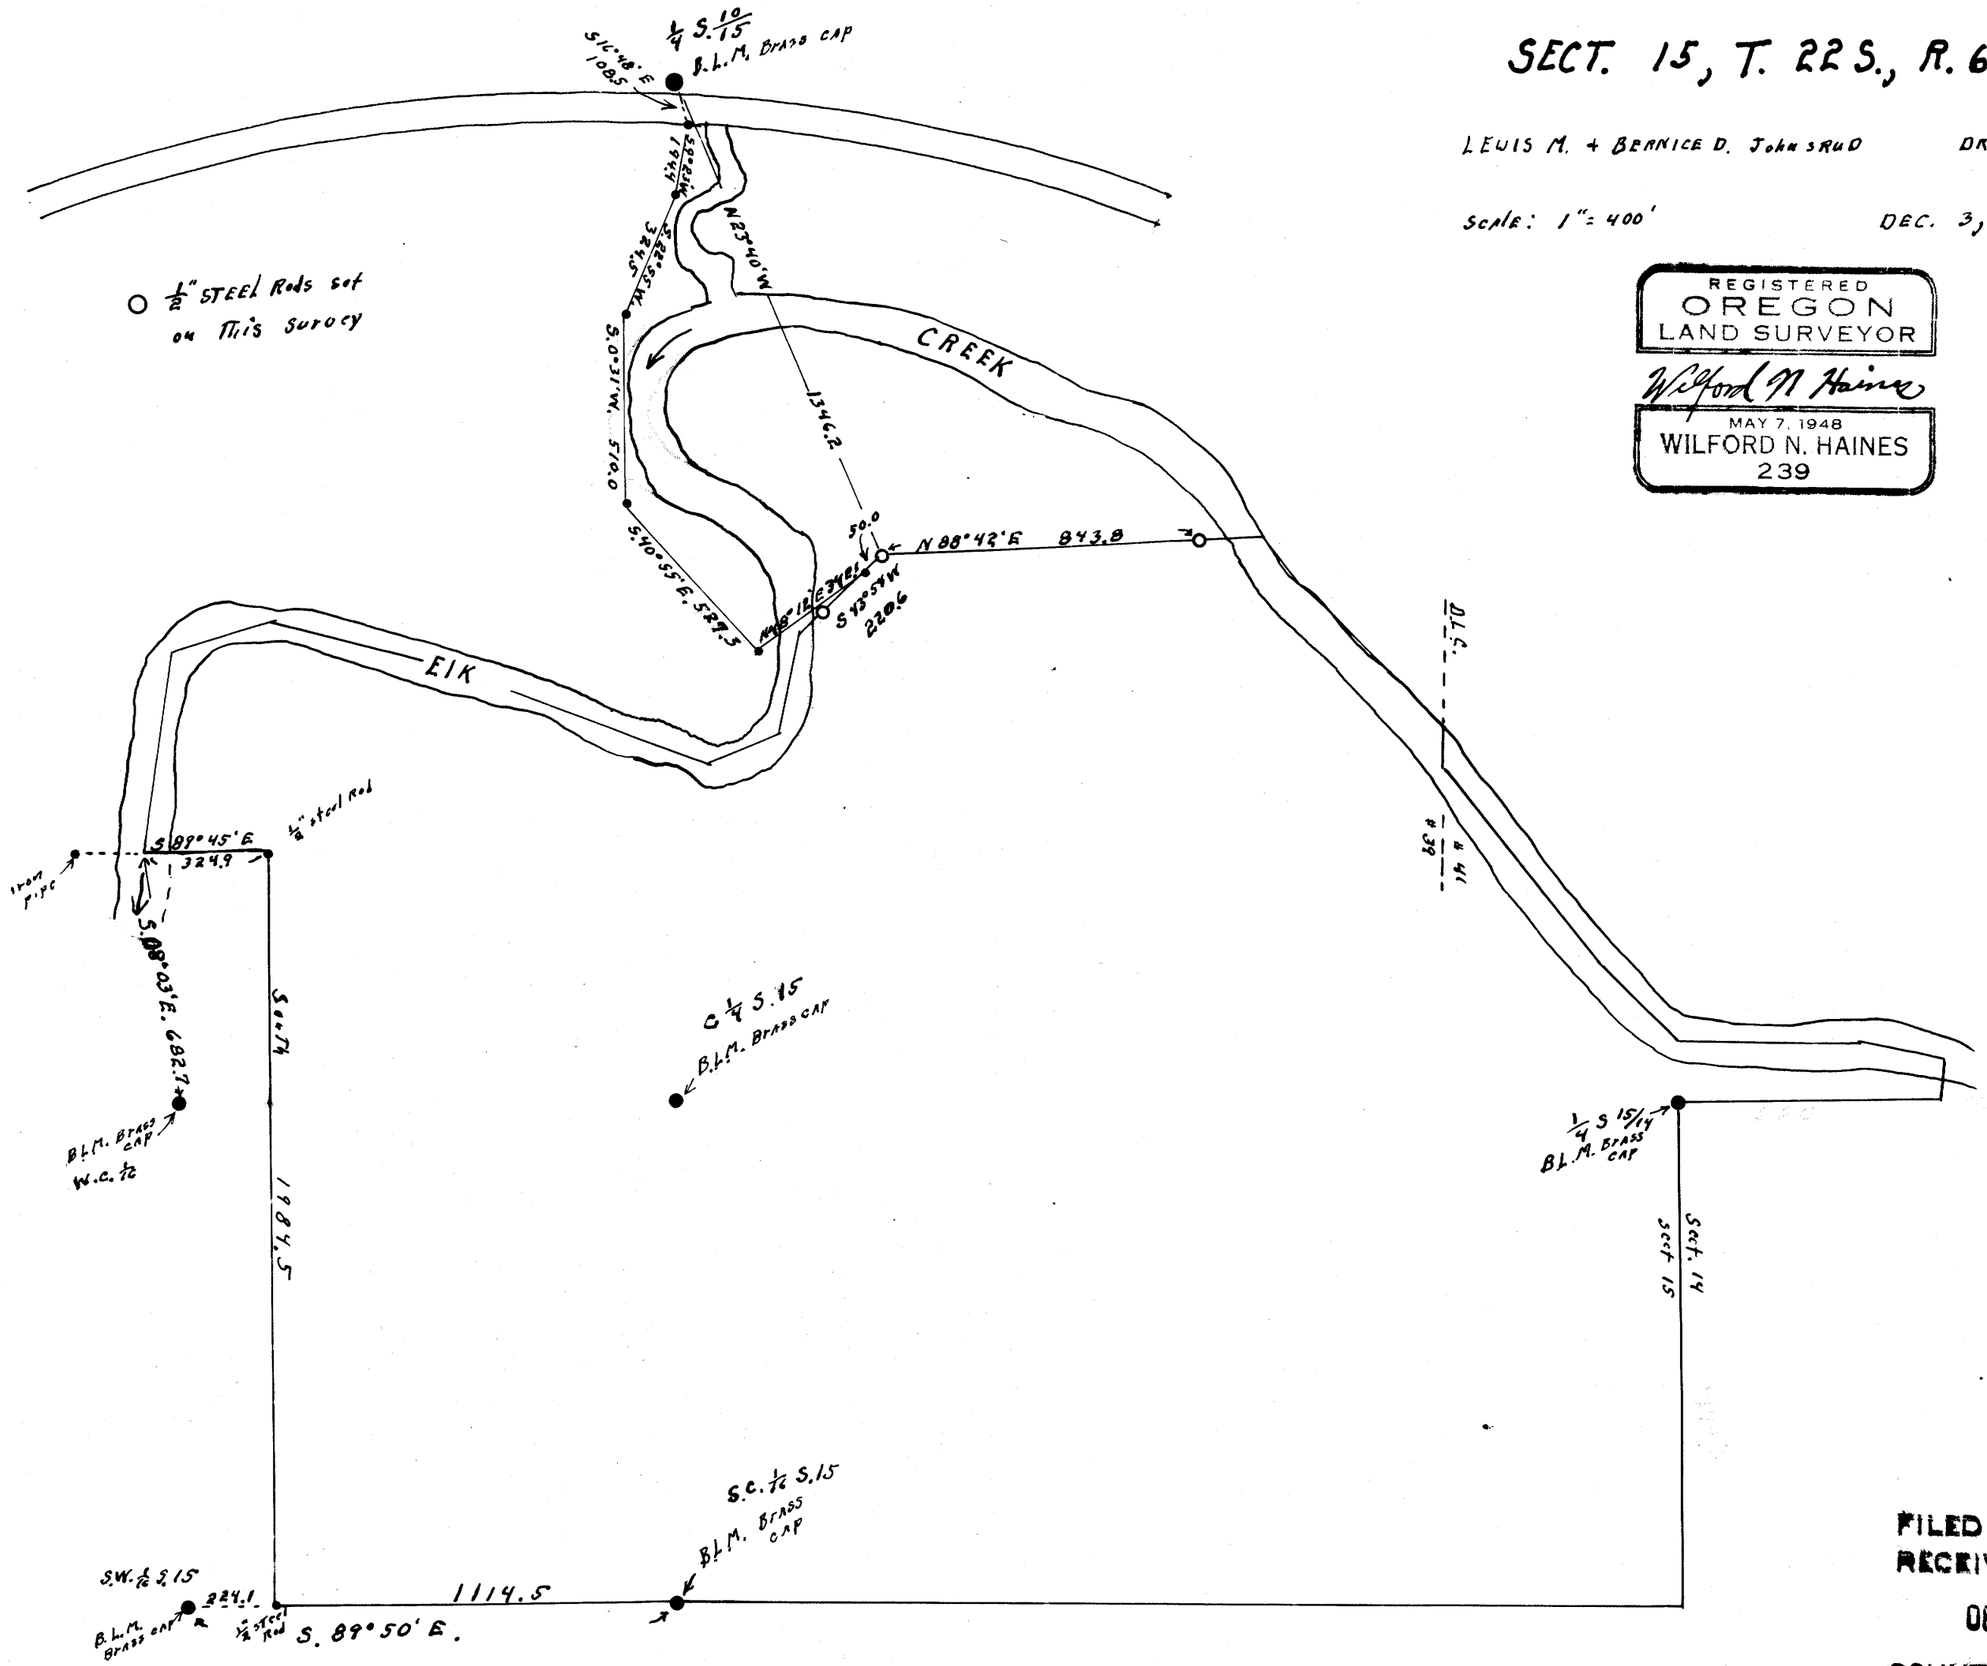

FILED
RECEIVED
DEC 15 1966
COUNTY SURVEYOR
DOUGLAS COUNTY, ORE.

MAP FILE M 32 P. 39

MAP FILE M 32 P. 39