COUNTY SURVEYORS FILE DATA
DO NOT REMOVE FROM OFFICE

SURVEY FOR DEED DESCRIPTION

SECTION 9, T.27 S., R.6 W.W.M.

FOR ELVIN WOODS & DUANE SUTTON

BY BAUGHMAN SURVEYING SERVICE

SCALE 1" = 100' JANUARY 12, 1967

- SET 3/4" I.ROD
- FD. 5/8" I.ROD WITH CAP

REGISTERED
OREGON
LAND SURVEYOR
Glenn S. Baughman
JULY 14, 1961
GLENN S. BAUGHMAN
536

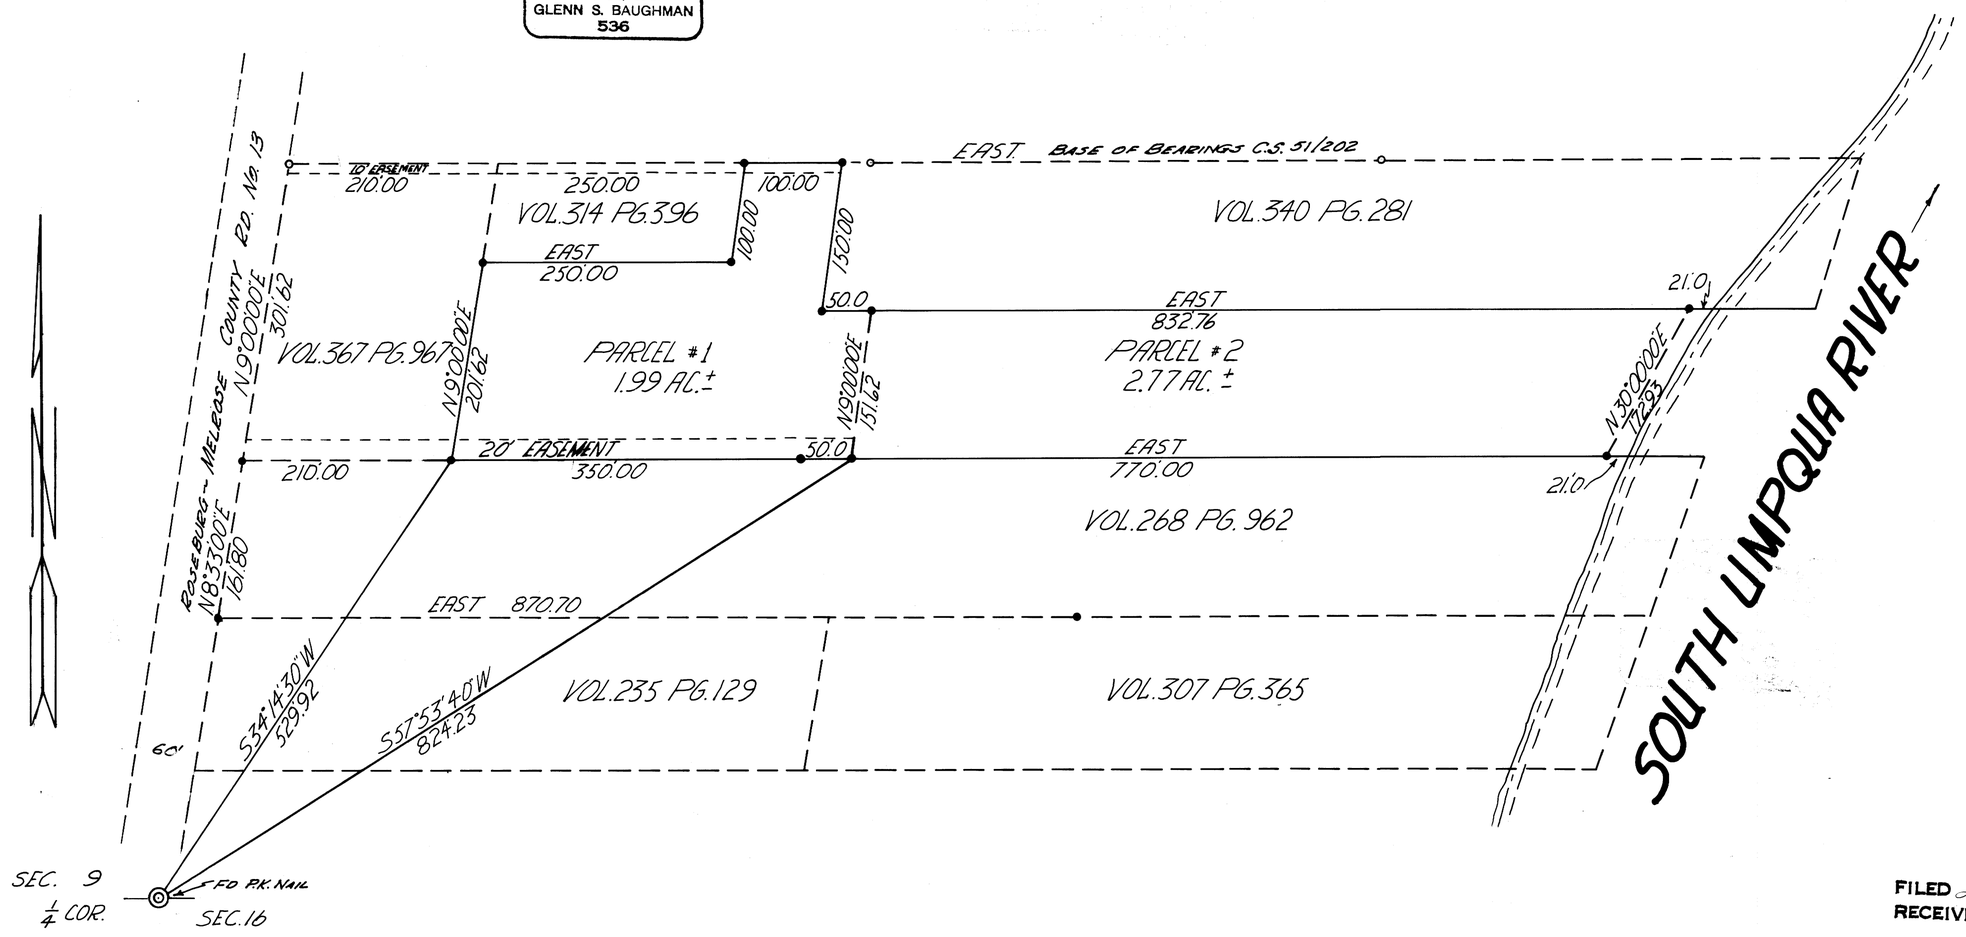

FILED
RECEIVED
JAN 16 1967
COUNTY SURVEYOR
DOUGLAS COUNTY, ORE.

MAP FILE M32 F.49
MAP FILE M32 F.49
SEE ALSO M 34-27