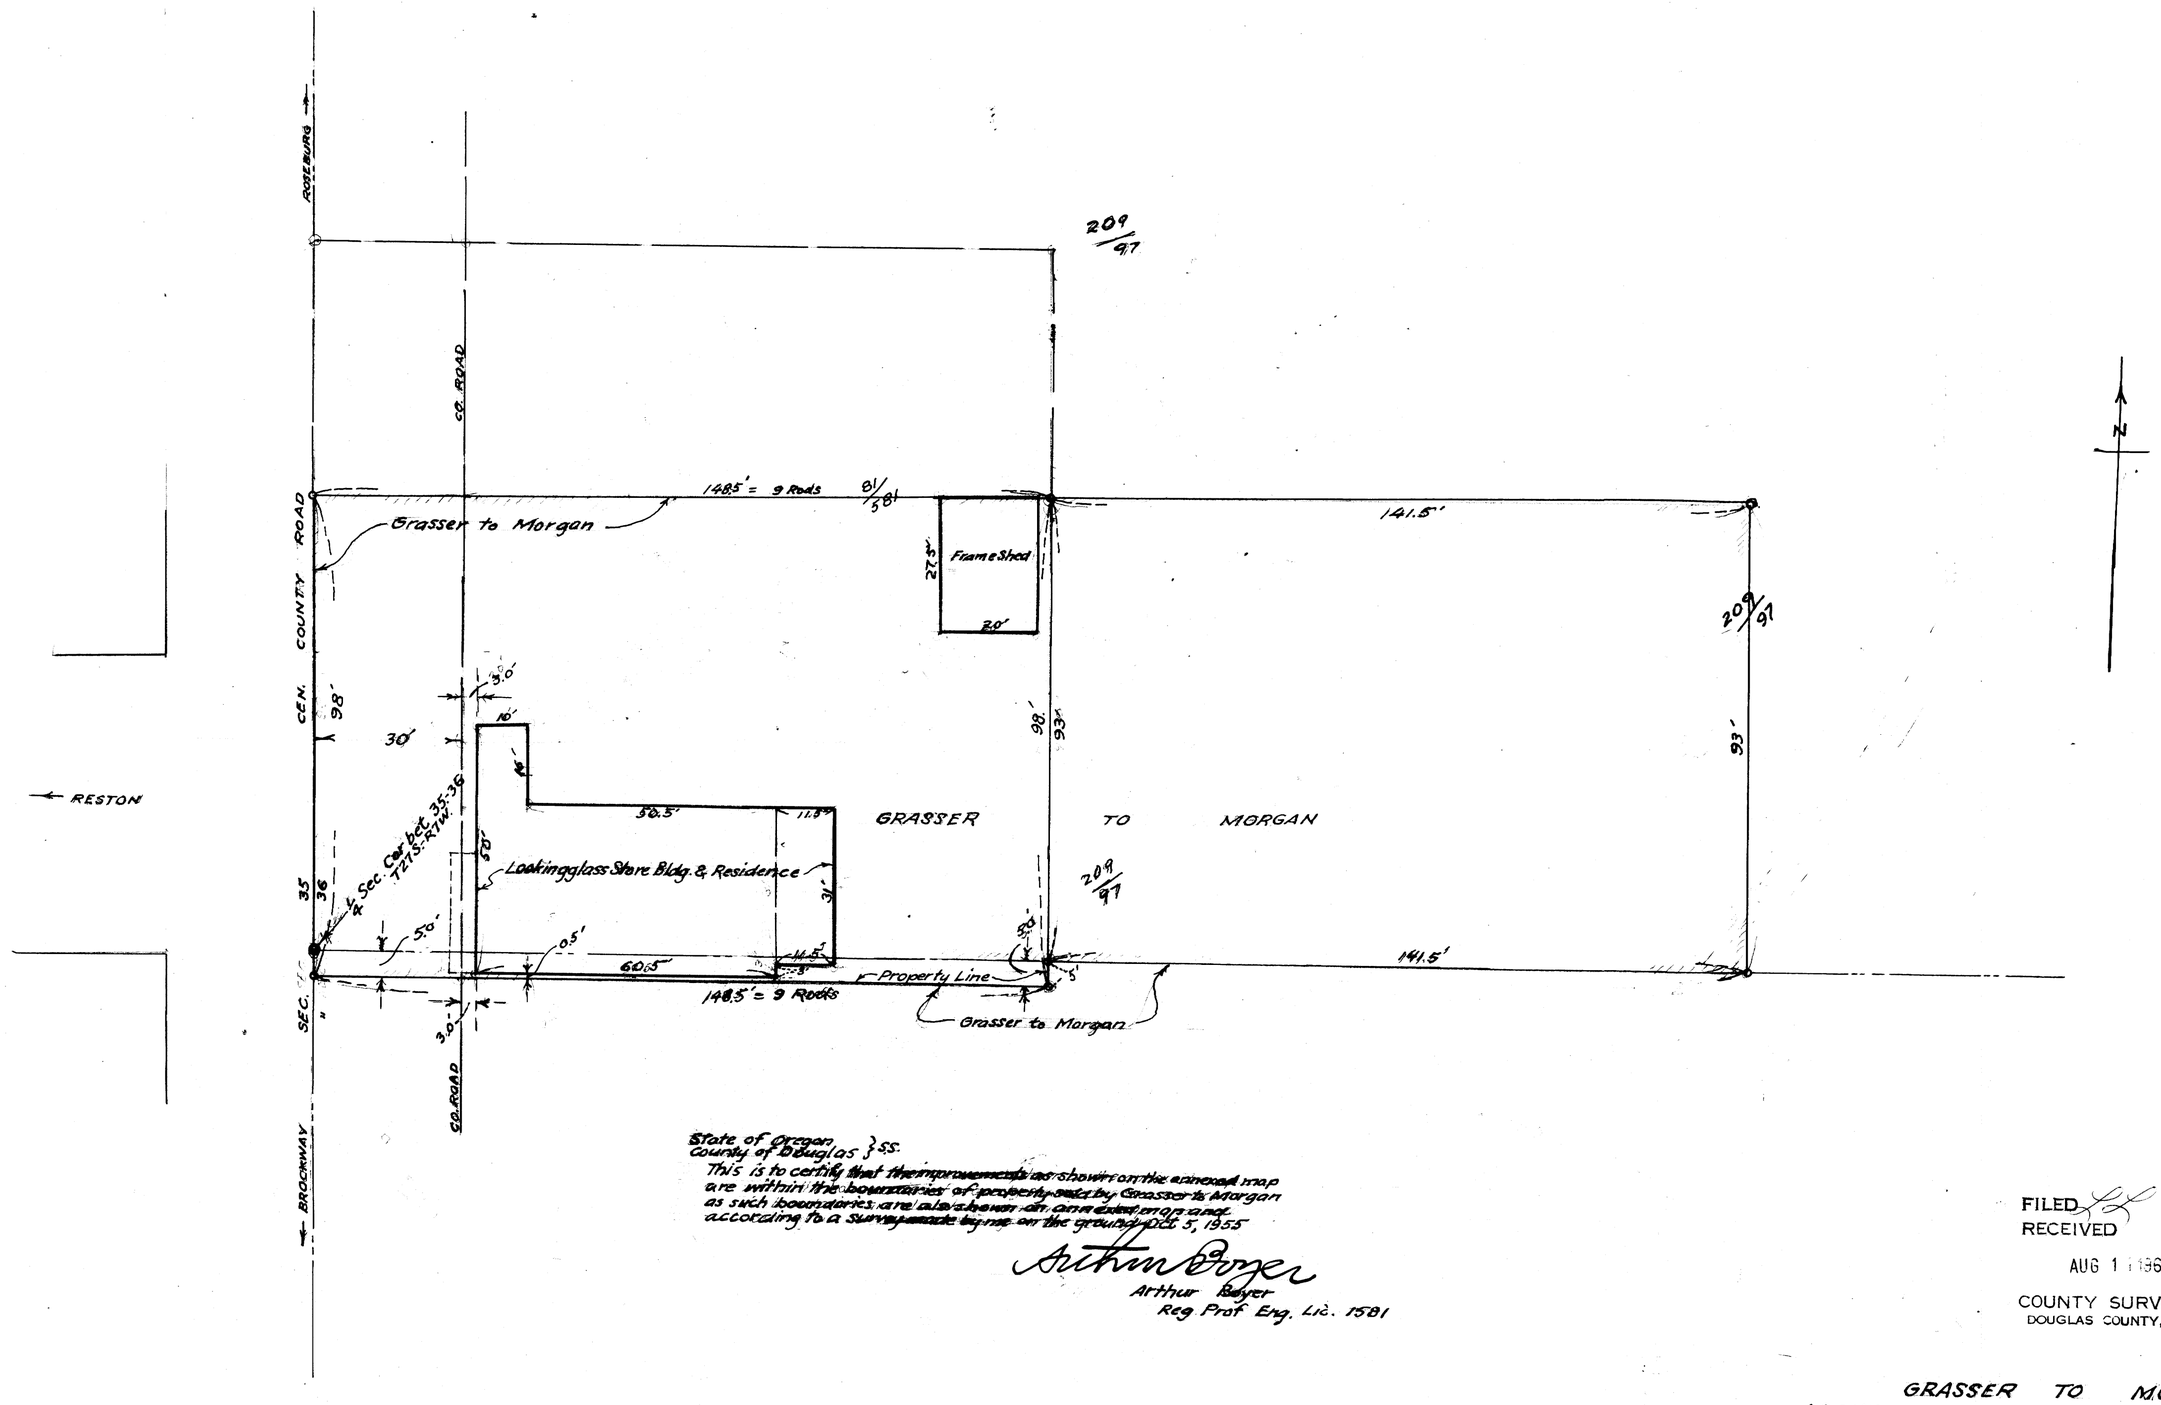

State of Oregon
County of Douglas } ss.

This is to certify that the improvements as shown on the annexed map are within the boundaries of property sold by Grasser to Morgan as such boundaries are also shown on an annexed map and according to a survey made by me on the ground Oct. 5, 1955

Arthur Boyer
Arthur Boyer
Reg. Prof. Eng. Lic. 1581

FILED
RECEIVED
AUG 1 1 1966
COUNTY SURVEYOR
DOUGLAS COUNTY, ORE.

GRASSER TO MORGAN
LOOKINGGLASS STORE BUILDINGS & ACREAGE
IN SEC. 36, T27S; R7W: WILLAMETTE MER.
OCT. 1955 JKB. 1" = 20 ft.

COUNTY SURVEYORS FILE DATA
DO NOT REMOVE FROM OFFICE

MAP FILE M32-5