M32-55

COUNTY SURVEYORS FILE DATA
DO NOT REMOVE FROM OFFICE

SURVEY IN SECTION 16, T. 27 S., R. 6 W., W.M.
SURVEYED FOR RAY GRAVES
SURVEYED BY R. H. GEE JANUARY, 1967
SCALE 1" = 200'

S W ¼

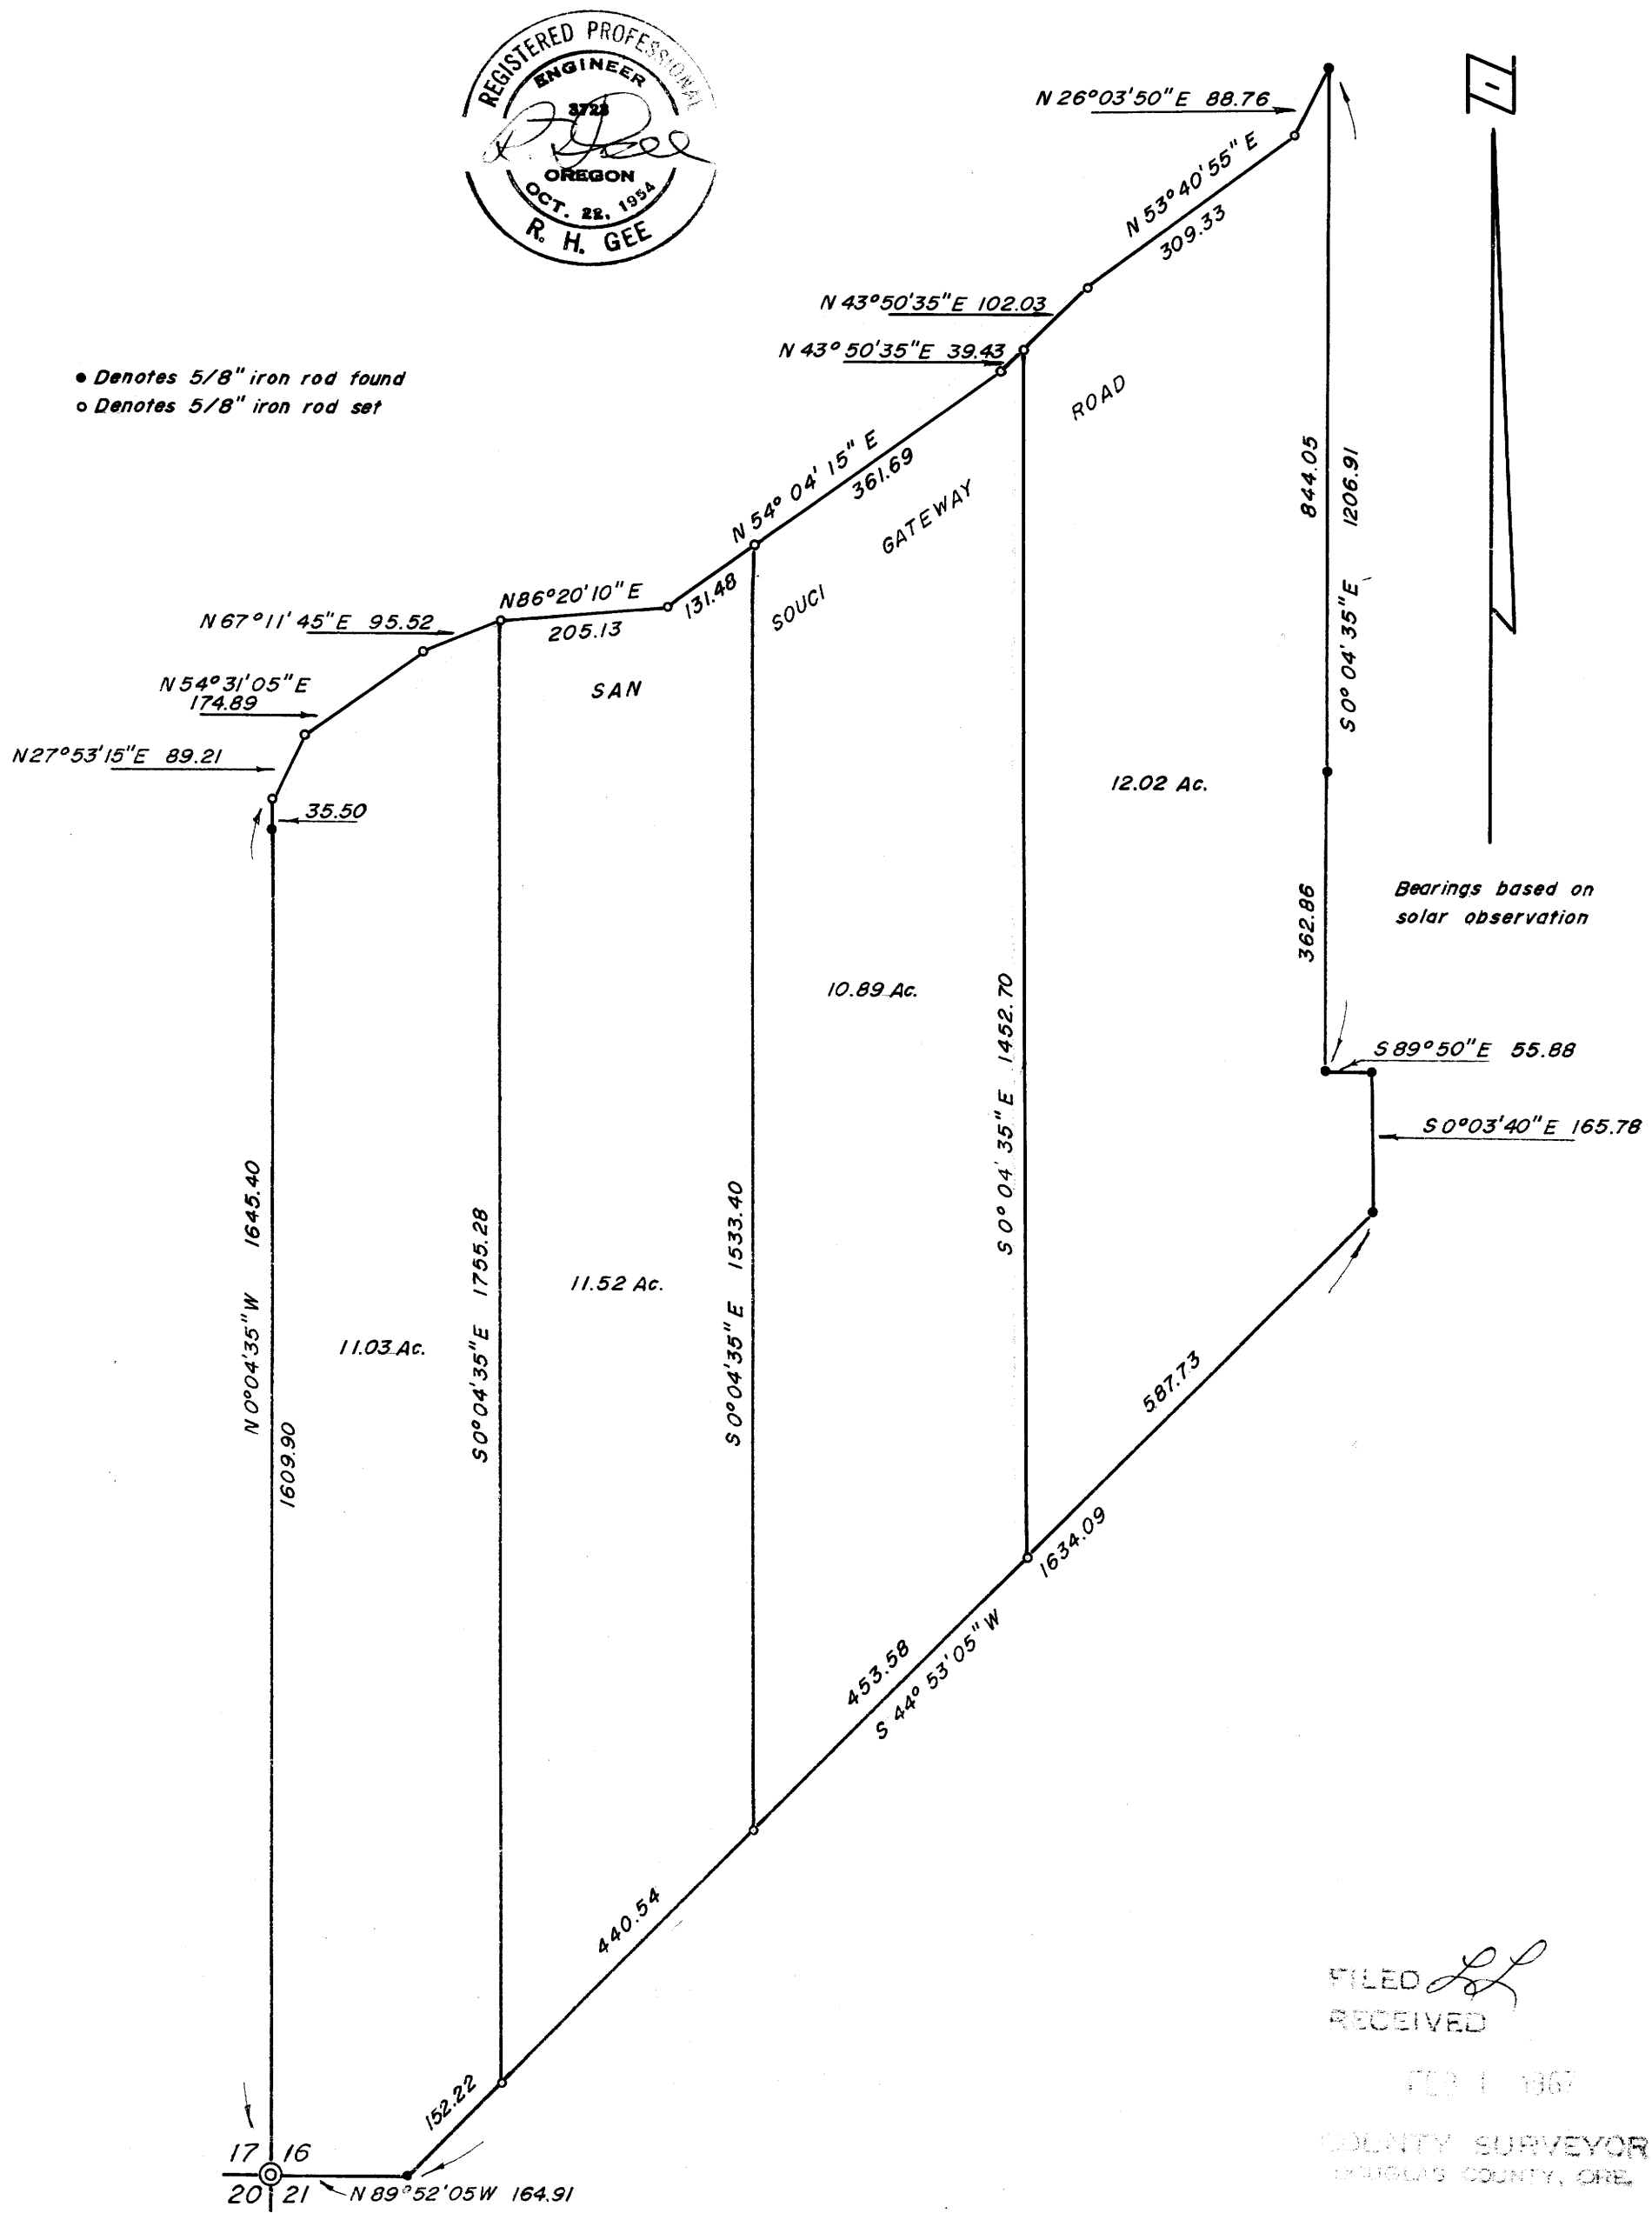

M32-55