M32-56

COUNTY SURVEYORS FILE
DO NOT REMOVE FROM OFFICE

REGISTERED
OREGON
LAND SURVEYOR
Don E. Garrett
JULY 14, 1961
DON E. GARRETT
544

FILED
RECEIVED
FEB 2 1967
COUNTY SURVEYOR
DOUGLAS COUNTY, ORE.

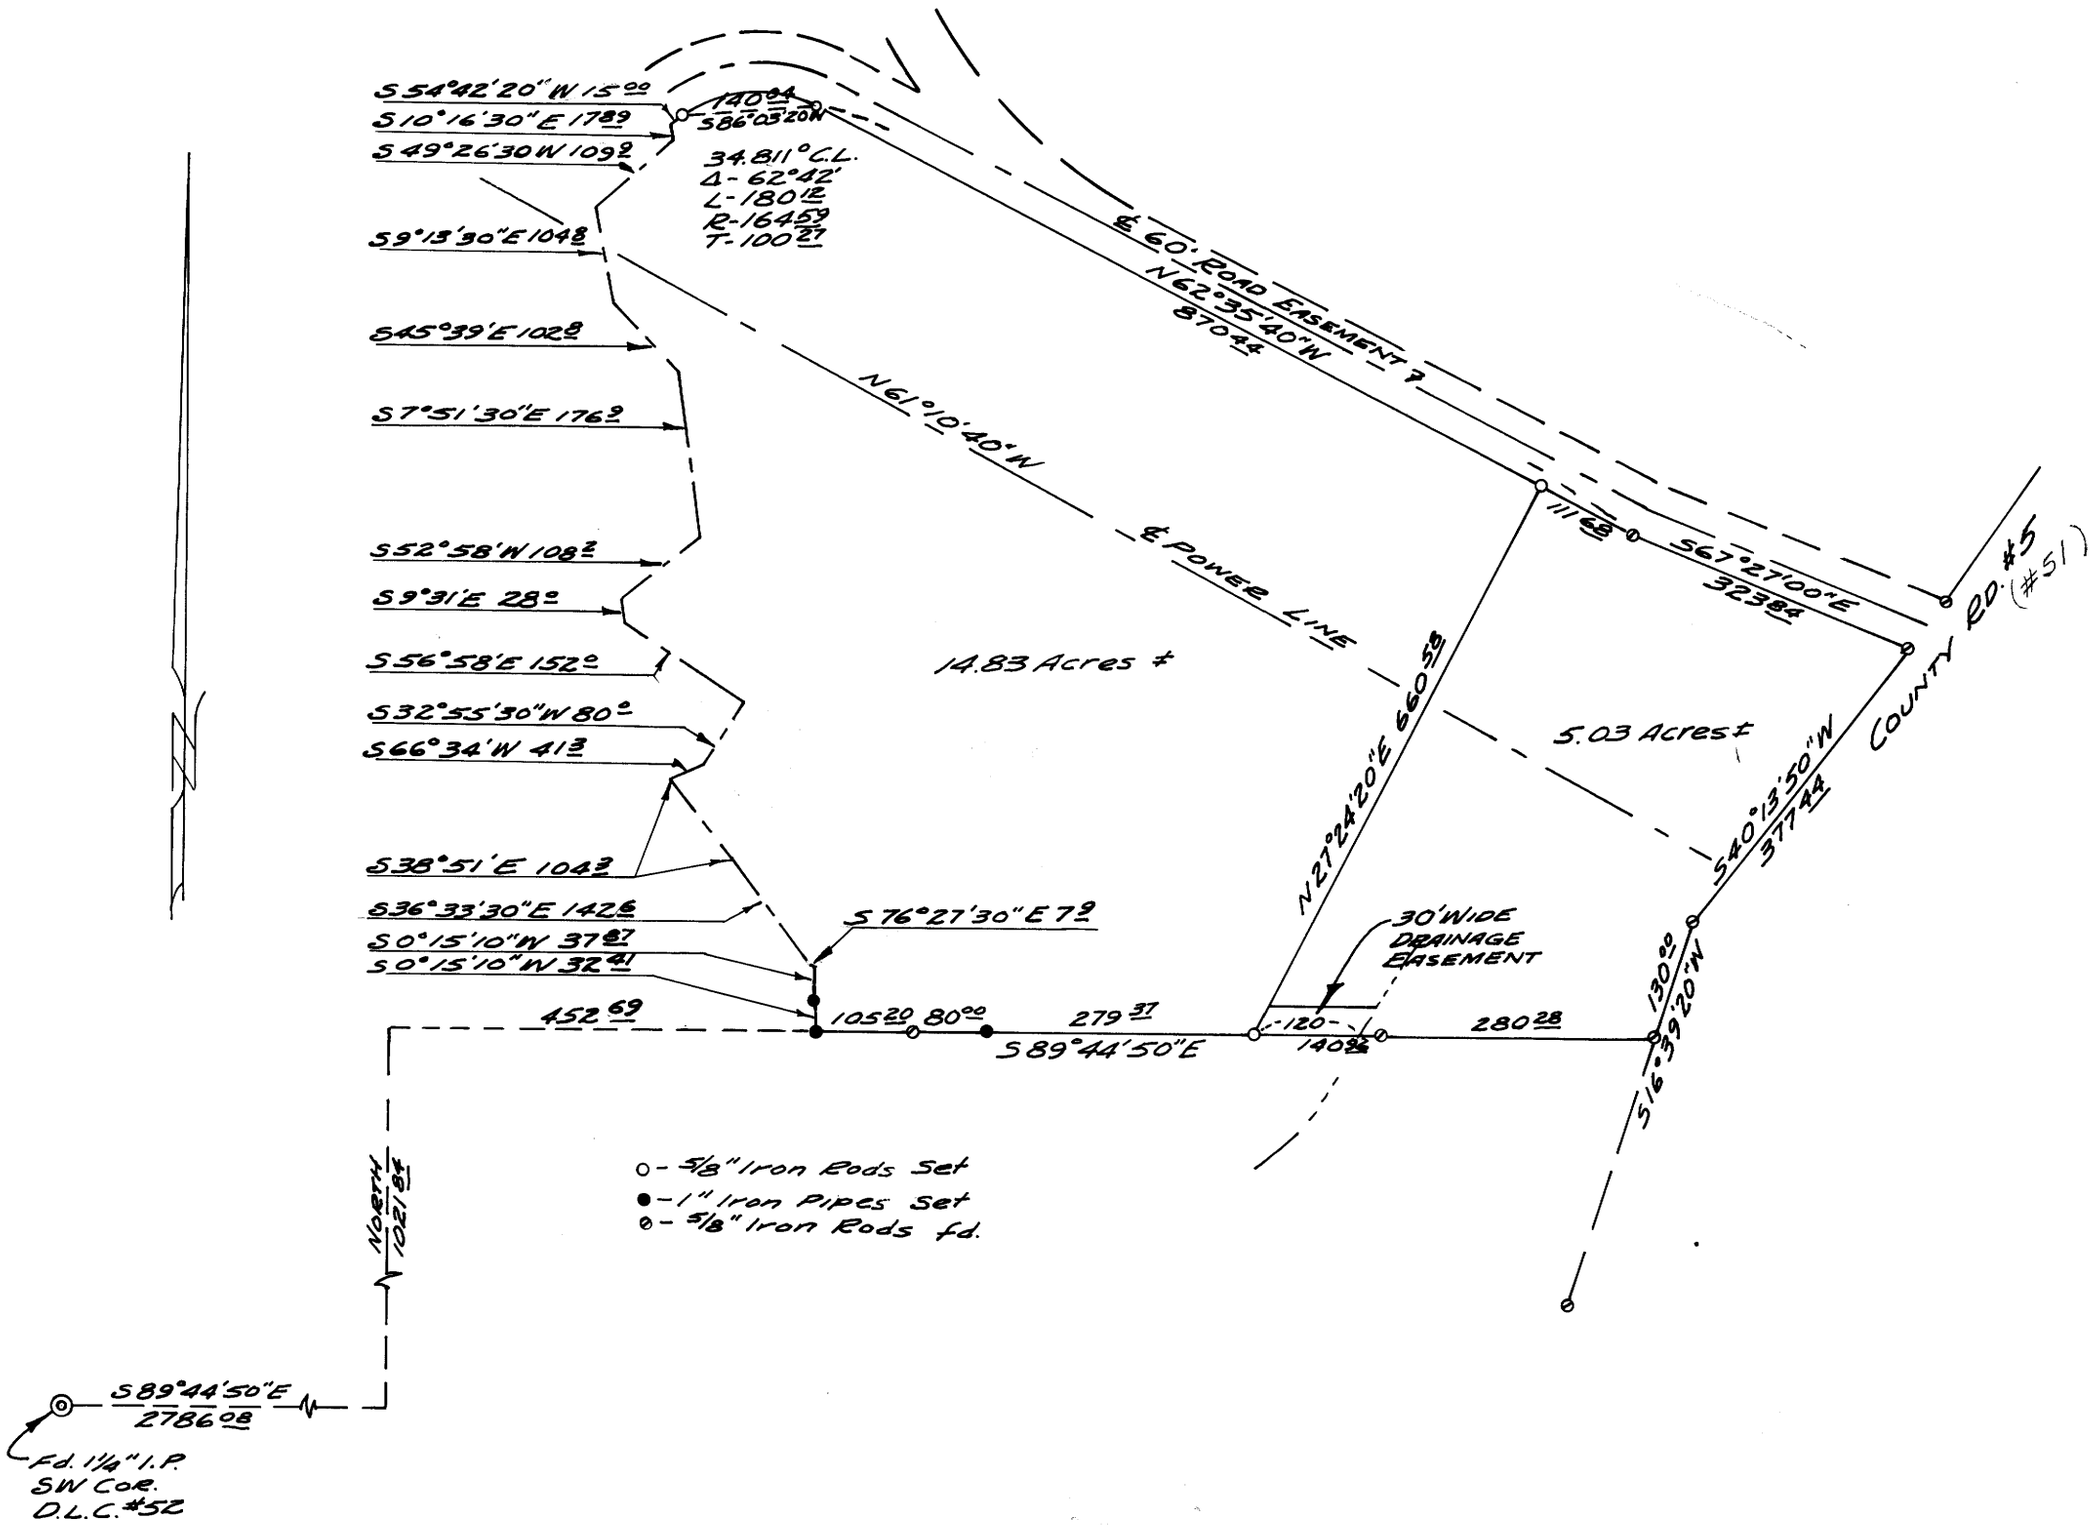

A SURVEY FOR PROPERTY DESCRIPTION

IN D.L.C. NO. 52 T27S, R7WWM
SURVEYED FOR HAYWARD REED BY DON E. GARRETT
JAN. 1967 SCALE- 1" = 200'
NW ¼ OF NW ¼ S 28

P

MAP FILE M 32 - 56