MAP FILE M 32 - 1 - 52

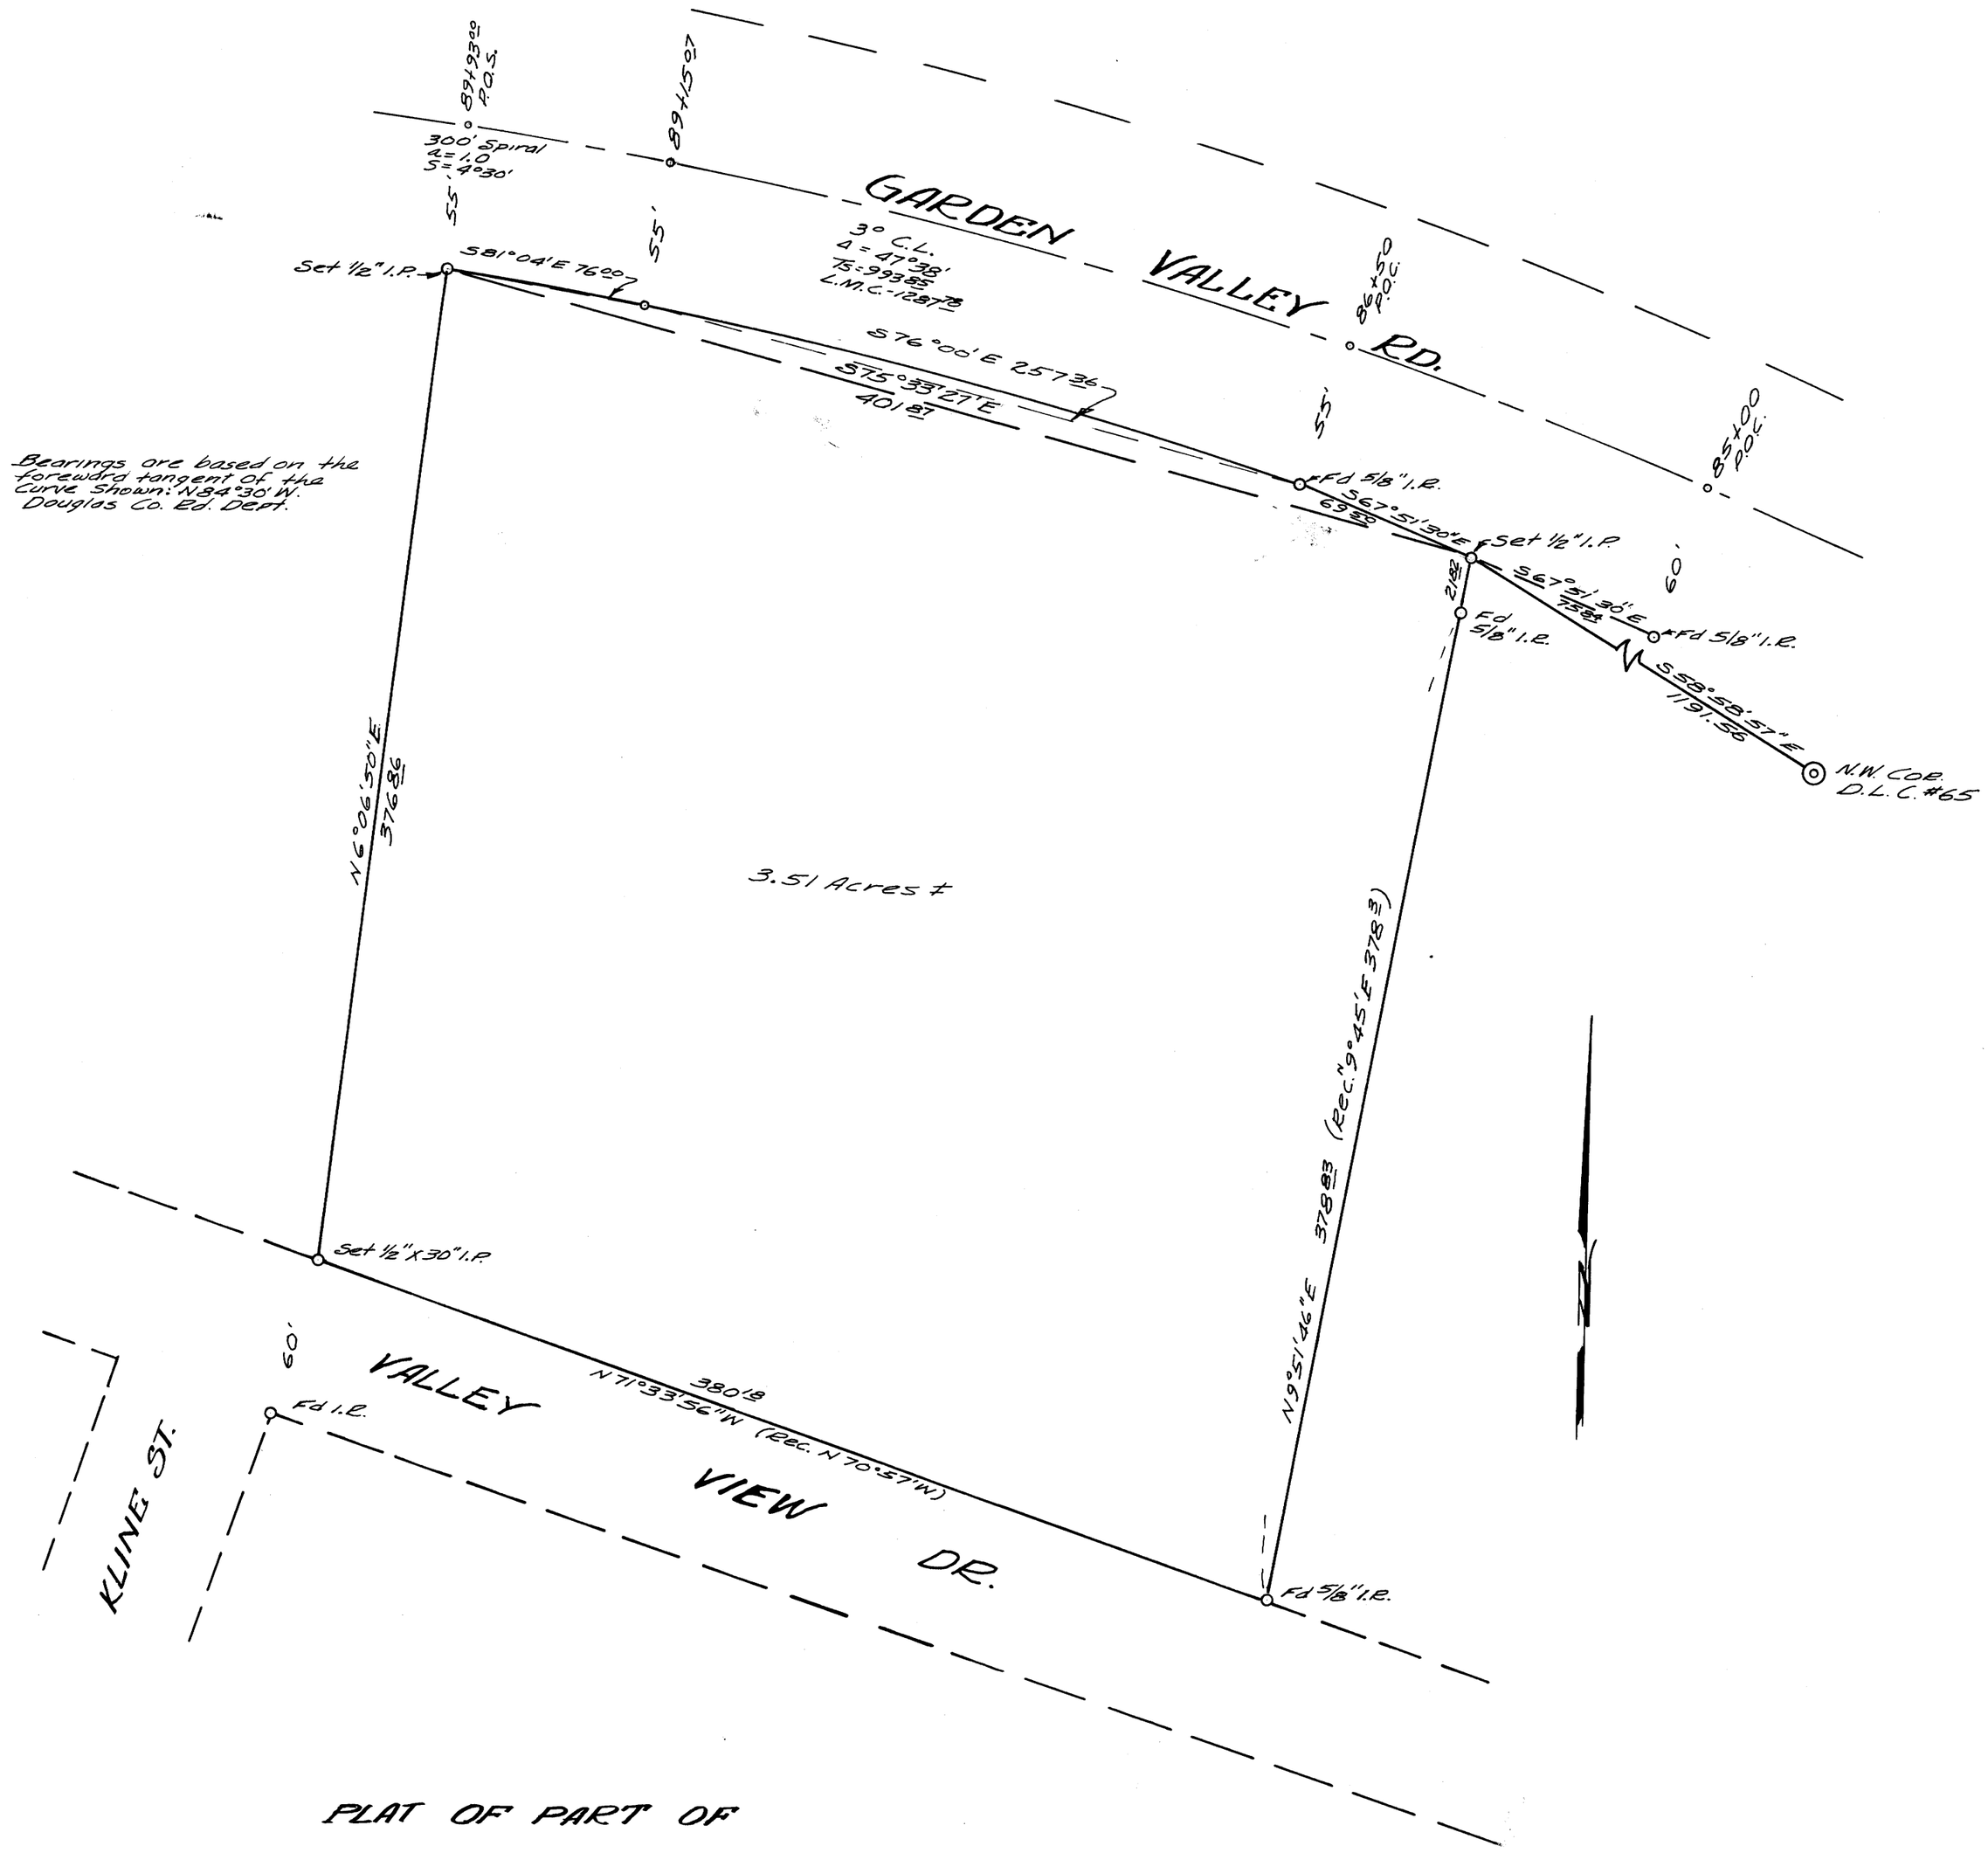

PLAT OF PART OF

CECIL HUGH & DARLEY WARE

PROPERTY

IN SECTION 11 T.27S, R6W WM

DOUGLAS COUNTY, OREGON

JAN. 1967 SCALE 1"=50'

NE OF SW 511

REGISTERED OREGON LAND SURVEYOR

Bruce R. Rogers

JULY 10, 1974

BRUCE R. ROGERS 660

FILED RECEIVED

JAN 26 1967

COUNTY SURVEYOR DOUGLAS COUNTY, ORE.

COUNTY SURVEYORS FILE DRAWING DO NOT REMOVE FROM OFFICE

MAP FILE M 32 - 1 - 52