MAP FILE M.32 + 60

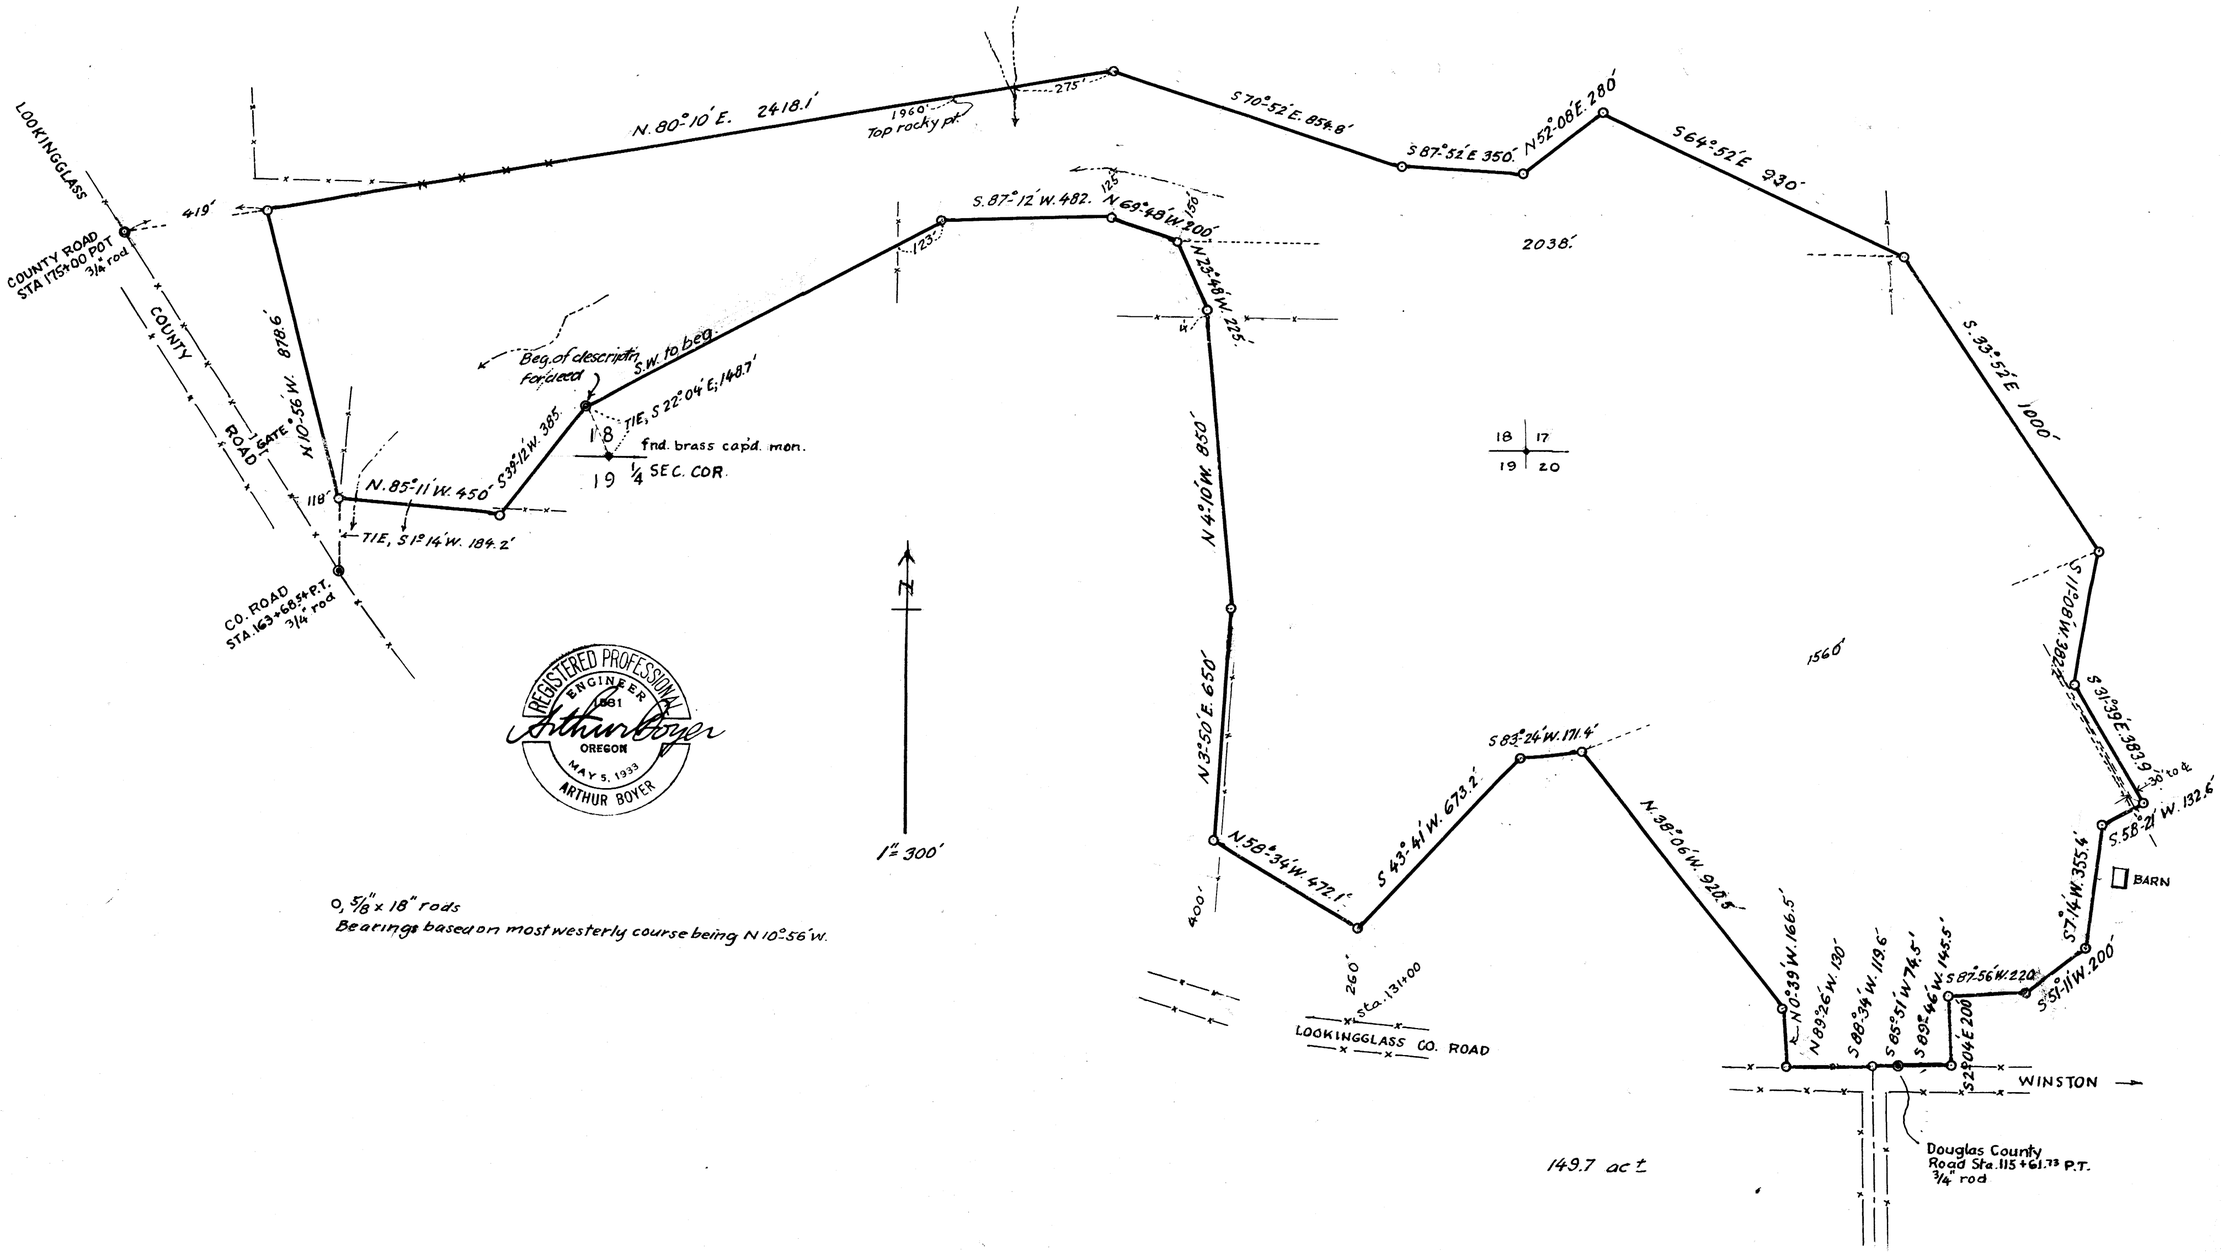

REGISTERED PROFESSIONAL ENGINEER 1881 OREGON MAY 5, 1933 ARTHUR BOYER

Arthur Boyer

O, 5/8" x 18" rods
Bearings based on most westerly course being N 10°-56' W.

FILED
RECEIVED
FEB 27 1967
COUNTY SURVEYOR
DOUGLAS COUNTY, ORE.

COUNTY SURVEYORS FILE DATA
DO NOT REMOVE FROM OFFICE

WINSTON MUNICIPAL GOLF COURSE
WINSTON, DOUGLAS COUNTY, ORE.
IN SEC'S. 17, 18, 19 & 20, T.28S; R.6W; W.M.
FEB. 1967 1" = 300'

MAP FILE M.32 + 60