COUNTY SURVEYORS FILE OR
DO NOT REMOVE FROM OFFICE

M 32-71
F.B. H-44

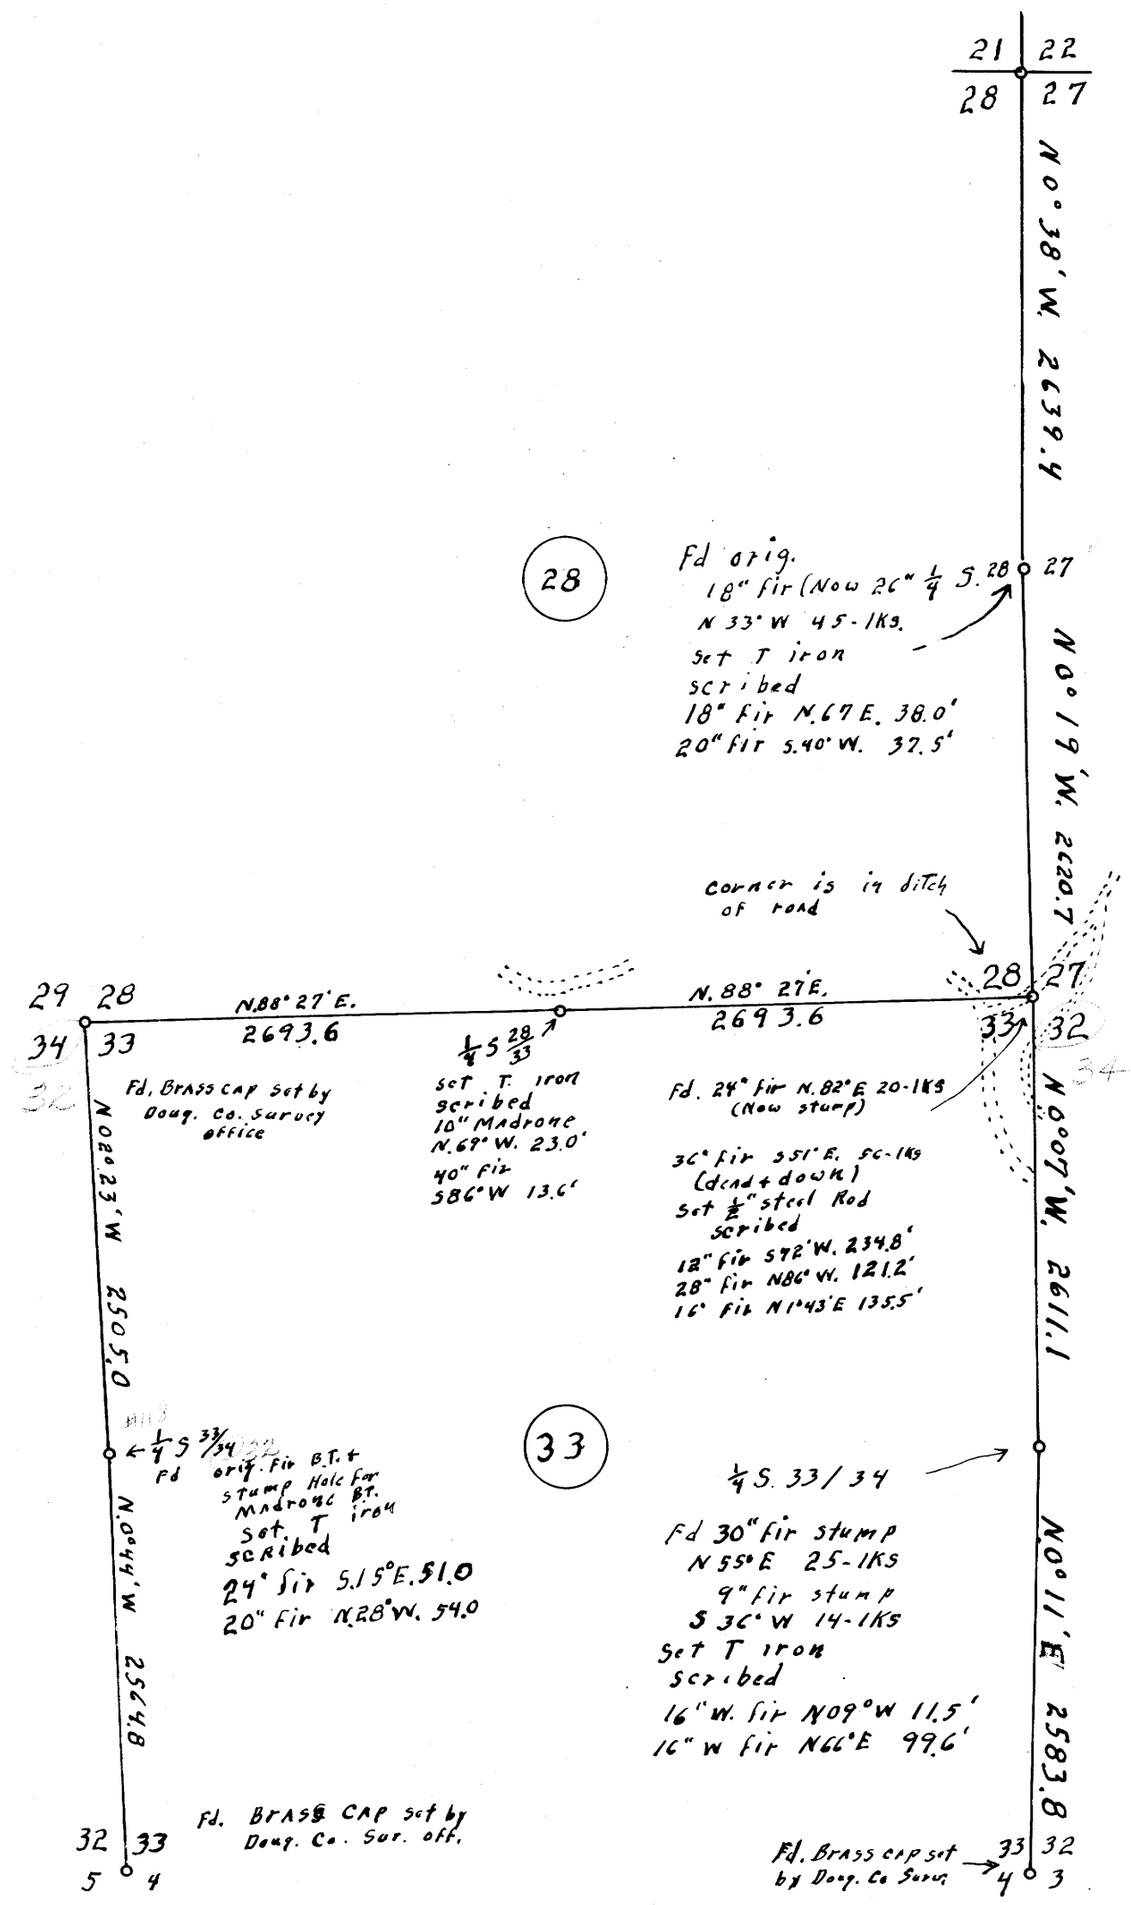

REGISTERED
OREGON
LAND SURVEYOR
Wilford N. Haines
MAY 7, 1948
WILFORD N. HAINES
239

T. 21 S., R. 6 W. W.M. SECTS. 28 + 33

for

Woolley Logging Company Drain, Ore.

Scale: 1" = 1000 surveyed 1965 plotted March 1967

Cor. 27, 28, 33 + 34 set after Road was constructed in 1966

FILED
RECEIVED
MAR 30 1967
COUNTY SURVEYOR
DOUGLAS COUNTY, ORE.

MAP FILE M 32 - 71
F.B. H-44