

S.E. Cor. D.L.C. #43
Pd. 2 orig. B.Ts
Both Now Stamps
Set 1/2" steel Rod

N.E. Cor. D.L.C. #41
Pd. 0x19.12' oak S. 25'E, 72-143
Set 1/2" steel Rod (dead)
Scribed
6" Fir S88'E. 4.3'
14" Fir S36'W. 29.9'

COUNTY SURVEYORS FILE DATA
NOT REMOVE FROM OFFICE

SECTS. 18 + 19, T22S., R.7 W. W.M.

To locate EAST line D.L.C. #41

For

R. D. Hungerford

Elkton, Ore.

scale: 1" = 200'

March 1967.

South

12° 56'

1379.42

18	17
19	20


T.22S., R.7 W. W.M.

Witness corner set at
S89°46'E. 72.80 cts. on line 18/19
Pd 20" Fir N88°W. 92-143
Now a windfall
Set 1/2" steel Rod in old cut rd. on top of ridge
Scribed
12" Fir West 14.3'

REGISTERED
OREGON
LAND SURVEYOR

Wilford N. Haines

MAY 7, 1948
WILFORD N. HAINES
239

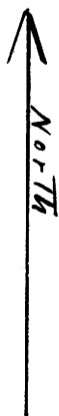

3307.5

S.E. Cor D.L.C. #41
Pd Steel Rod at corner
oak N80°W still standing
fir N80°E (stamp hole)
fir S67°E Now windfall

FILED
RECEIVED

MAR 10 1967

COUNTY SURVEYOR
DOUGLAS COUNTY, ORE.