COUNTY SURVEYORS FILE DATA
DO NOT REMOVE FROM OFFICE

A SURVEY TO ESTABLISH PROP. CORS.
IN SEC. 15 TW. 28S. RNG. 6W. W.M.
FOR ETHEL C. HUMPHREYS 8-12-66
BY DON E. GARRETT SCALE 1"=100'

FILED
RECEIVED
AUG 16 1966
COUNTY SURVEYOR
DOUGLAS COUNTY, ORE.

REGISTERED
OREGON
LAND SURVEYOR
Don E. Garrett
JULY 14, 1951
DON E. GARRETT
544

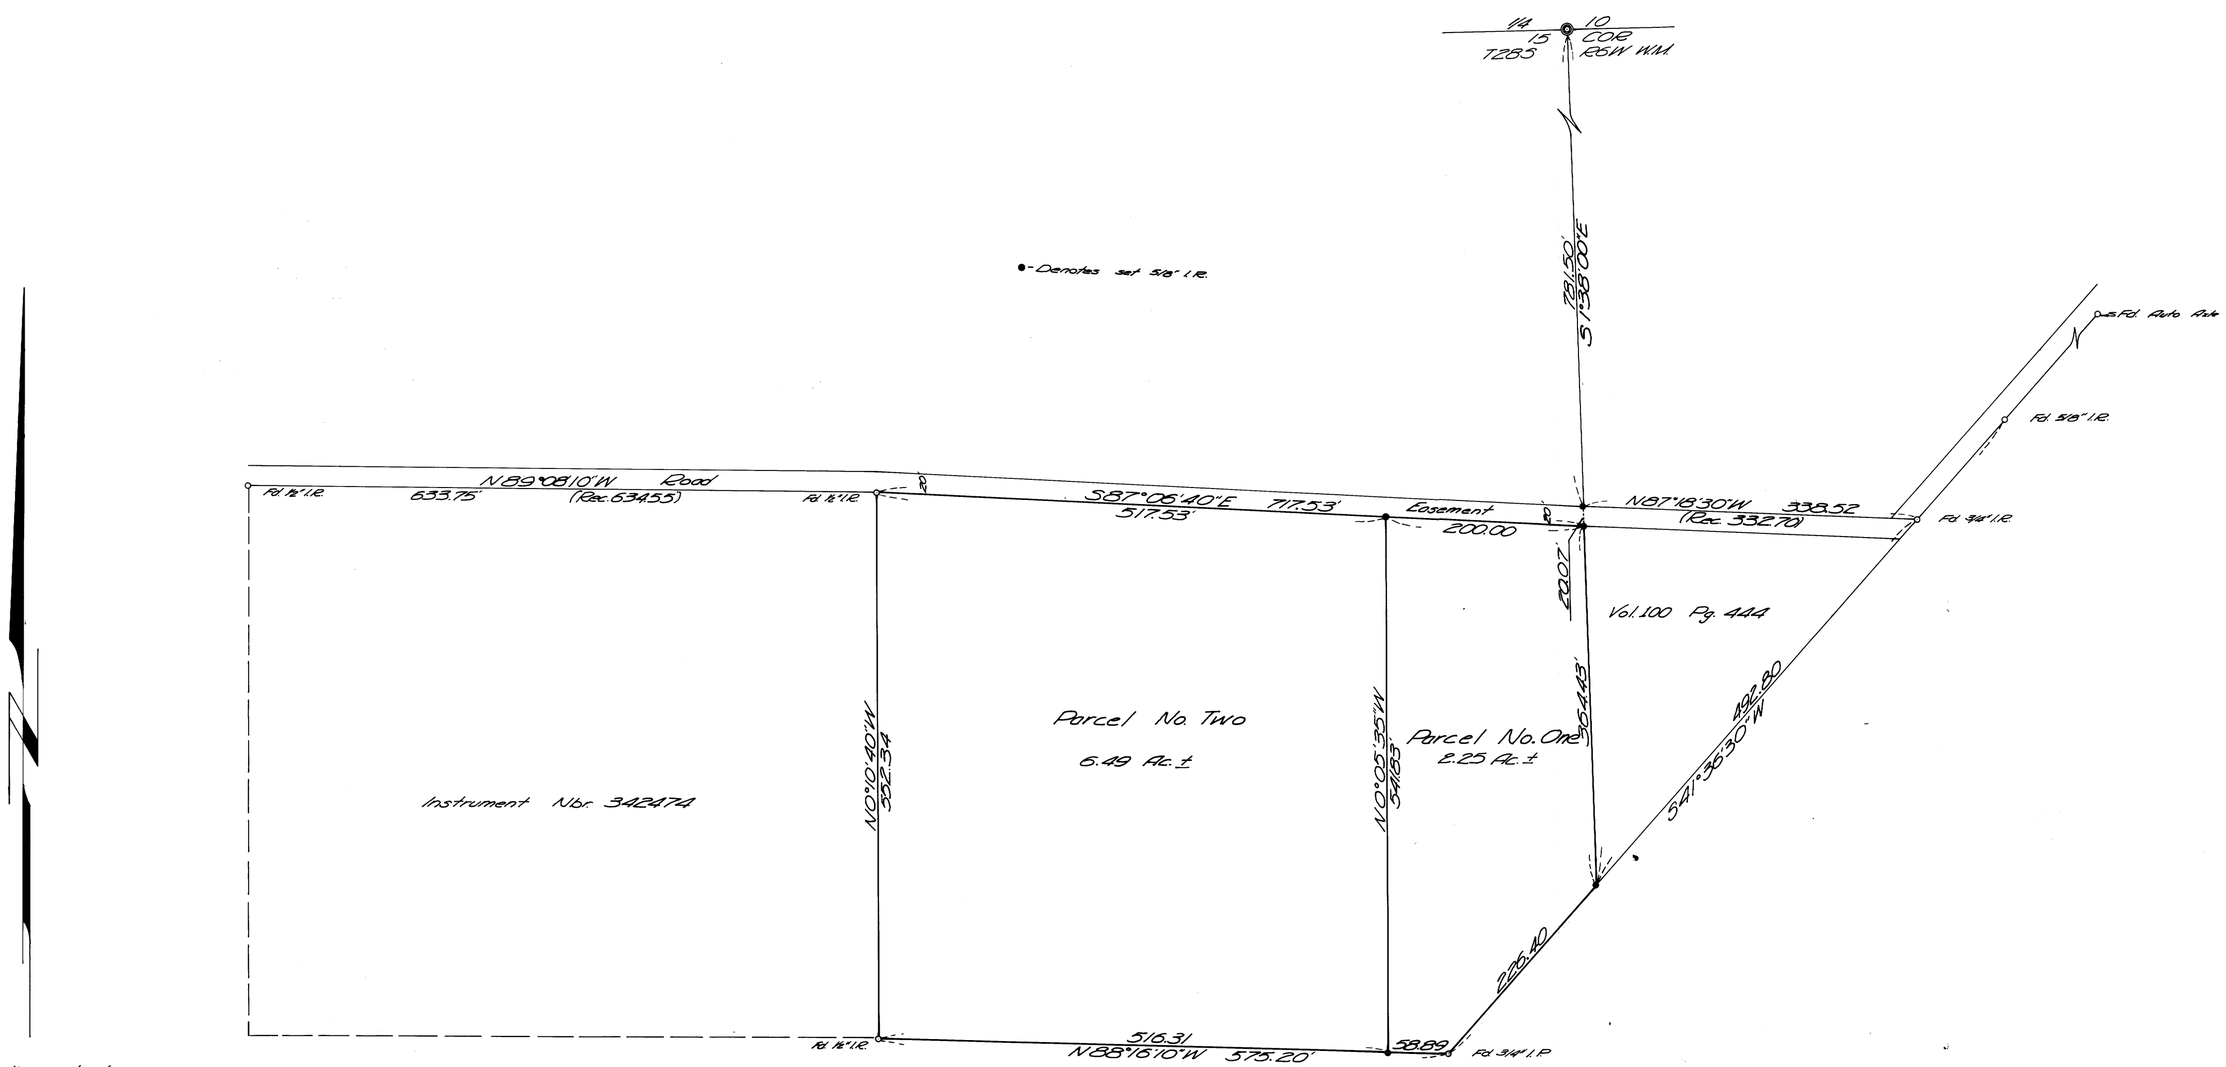

Note: Bearings are based on the East Line of parcel No. 1. S1°38'E.

MAP FILE M-32 r 8
MAP FILE M-32 r 8