MAP FILE M-32-1-80

COUNTY SURVEYORS FILE DATA
DO NOT REMOVE FROM OFFICE

SURVEY FOR DEED DESCRIPTIONS IN SEC. 14, T 22 S, R 10 W. W.M.. DOUGLAS COUNTY, ORE.

SURVEYED FOR- CECIL GEORGE — APRIL 1967
SURVEYED BY- W.S. BARNES — SCALE 1" = 100'

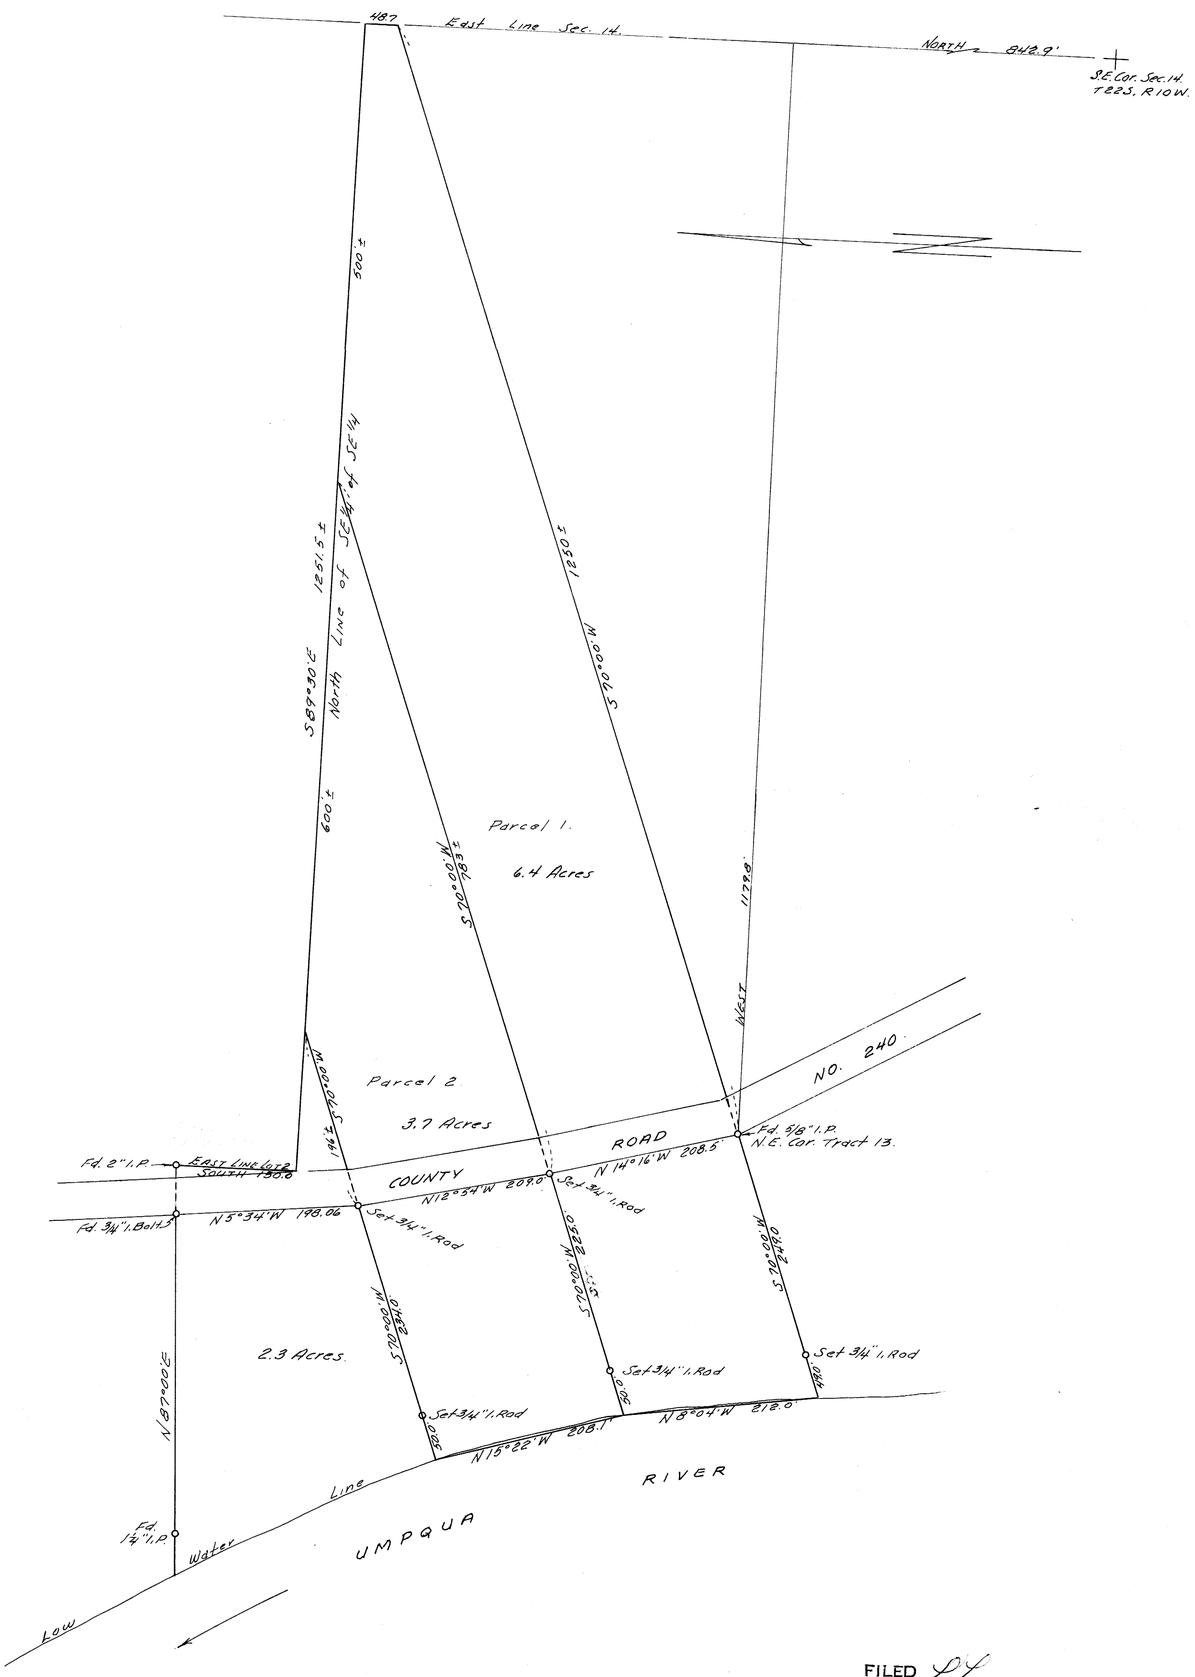

FILED
RECEIVED
MAY 4 1967
COUNTY SURVEYOR
DOUGLAS COUNTY, ORE.

REGISTERED PROFESSIONAL ENGINEER 2128 OREGON SEPT. 5, 1941 William S. Barnes

MAP FILE M-32-1-80