COUNTY SURVEYORS FILE DATA
DO NOT REMOVE FROM OFFICE

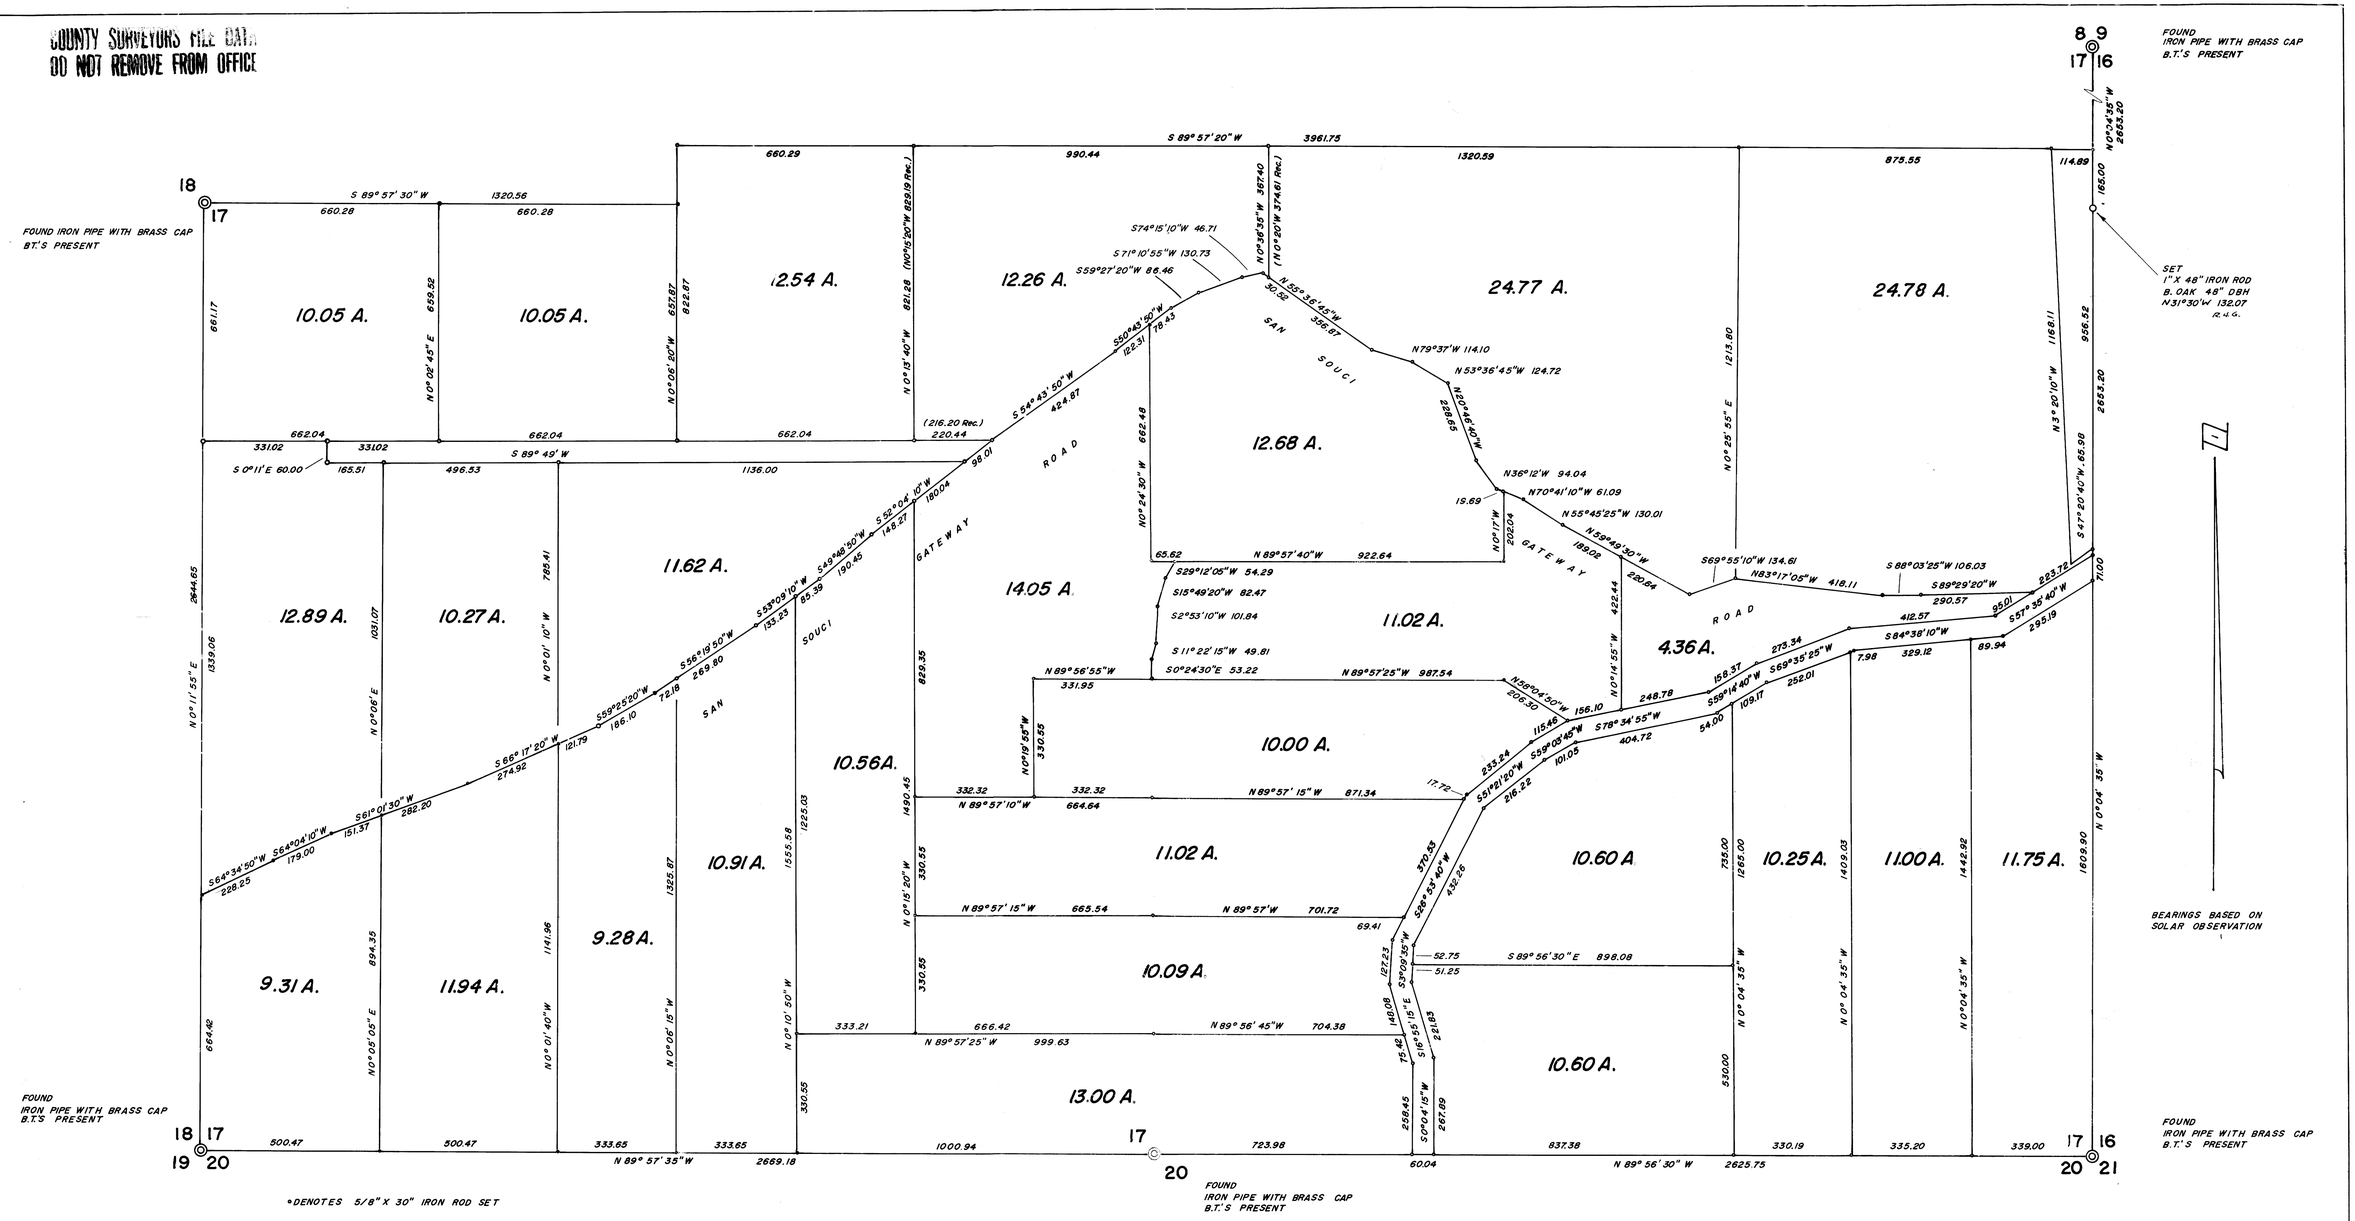


SURVEY IN SECTION 17, T. 27 S, R. 6 W, W.M.

DOUGLAS COUNTY, OREGON

SURVEYED FOR RAY GRAVES — JUNE, 1966

SURVEYED BY R. H. GEE — SCALE 1" = 200'

REGISTERED PROFESSIONAL ENGINEER 3288 OREGON OCT. 22, 1964 R. H. GEE

FILED RECEIVED FEB 16 1967 COUNTY SURVEYOR DOUGLAS COUNTY, ORE.

COUNTY SURVEYORS FILE DATA
DO NOT REMOVE FROM OFFICE

MAP FILE M33 # 12