SUBDIVISION OF SEC. 20, T27S, R7W, W.M.

SURVEYED FOR HAYWARD REED BY DON E. GARRETT
JANUARY 1, 1968 SCALE 1" = 200'

o – Set 5/8" I. Rod
● – Fd. 5/8" I. Rod
Bearings are based on a relocation survey of Melrose-Reston Road No. 51.

COUNTY SURVEYORS FILE DATA
DO NOT REMOVE FROM OFFICE

M 33 - 27

JAN 6 1968
COUNTY SURVEYOR
SALEM, OREGON

REGISTERED
OREGON
LAND SURVEYOR
Don E. Garrett
JULY 14, 1967
PAUL G. ...
1442

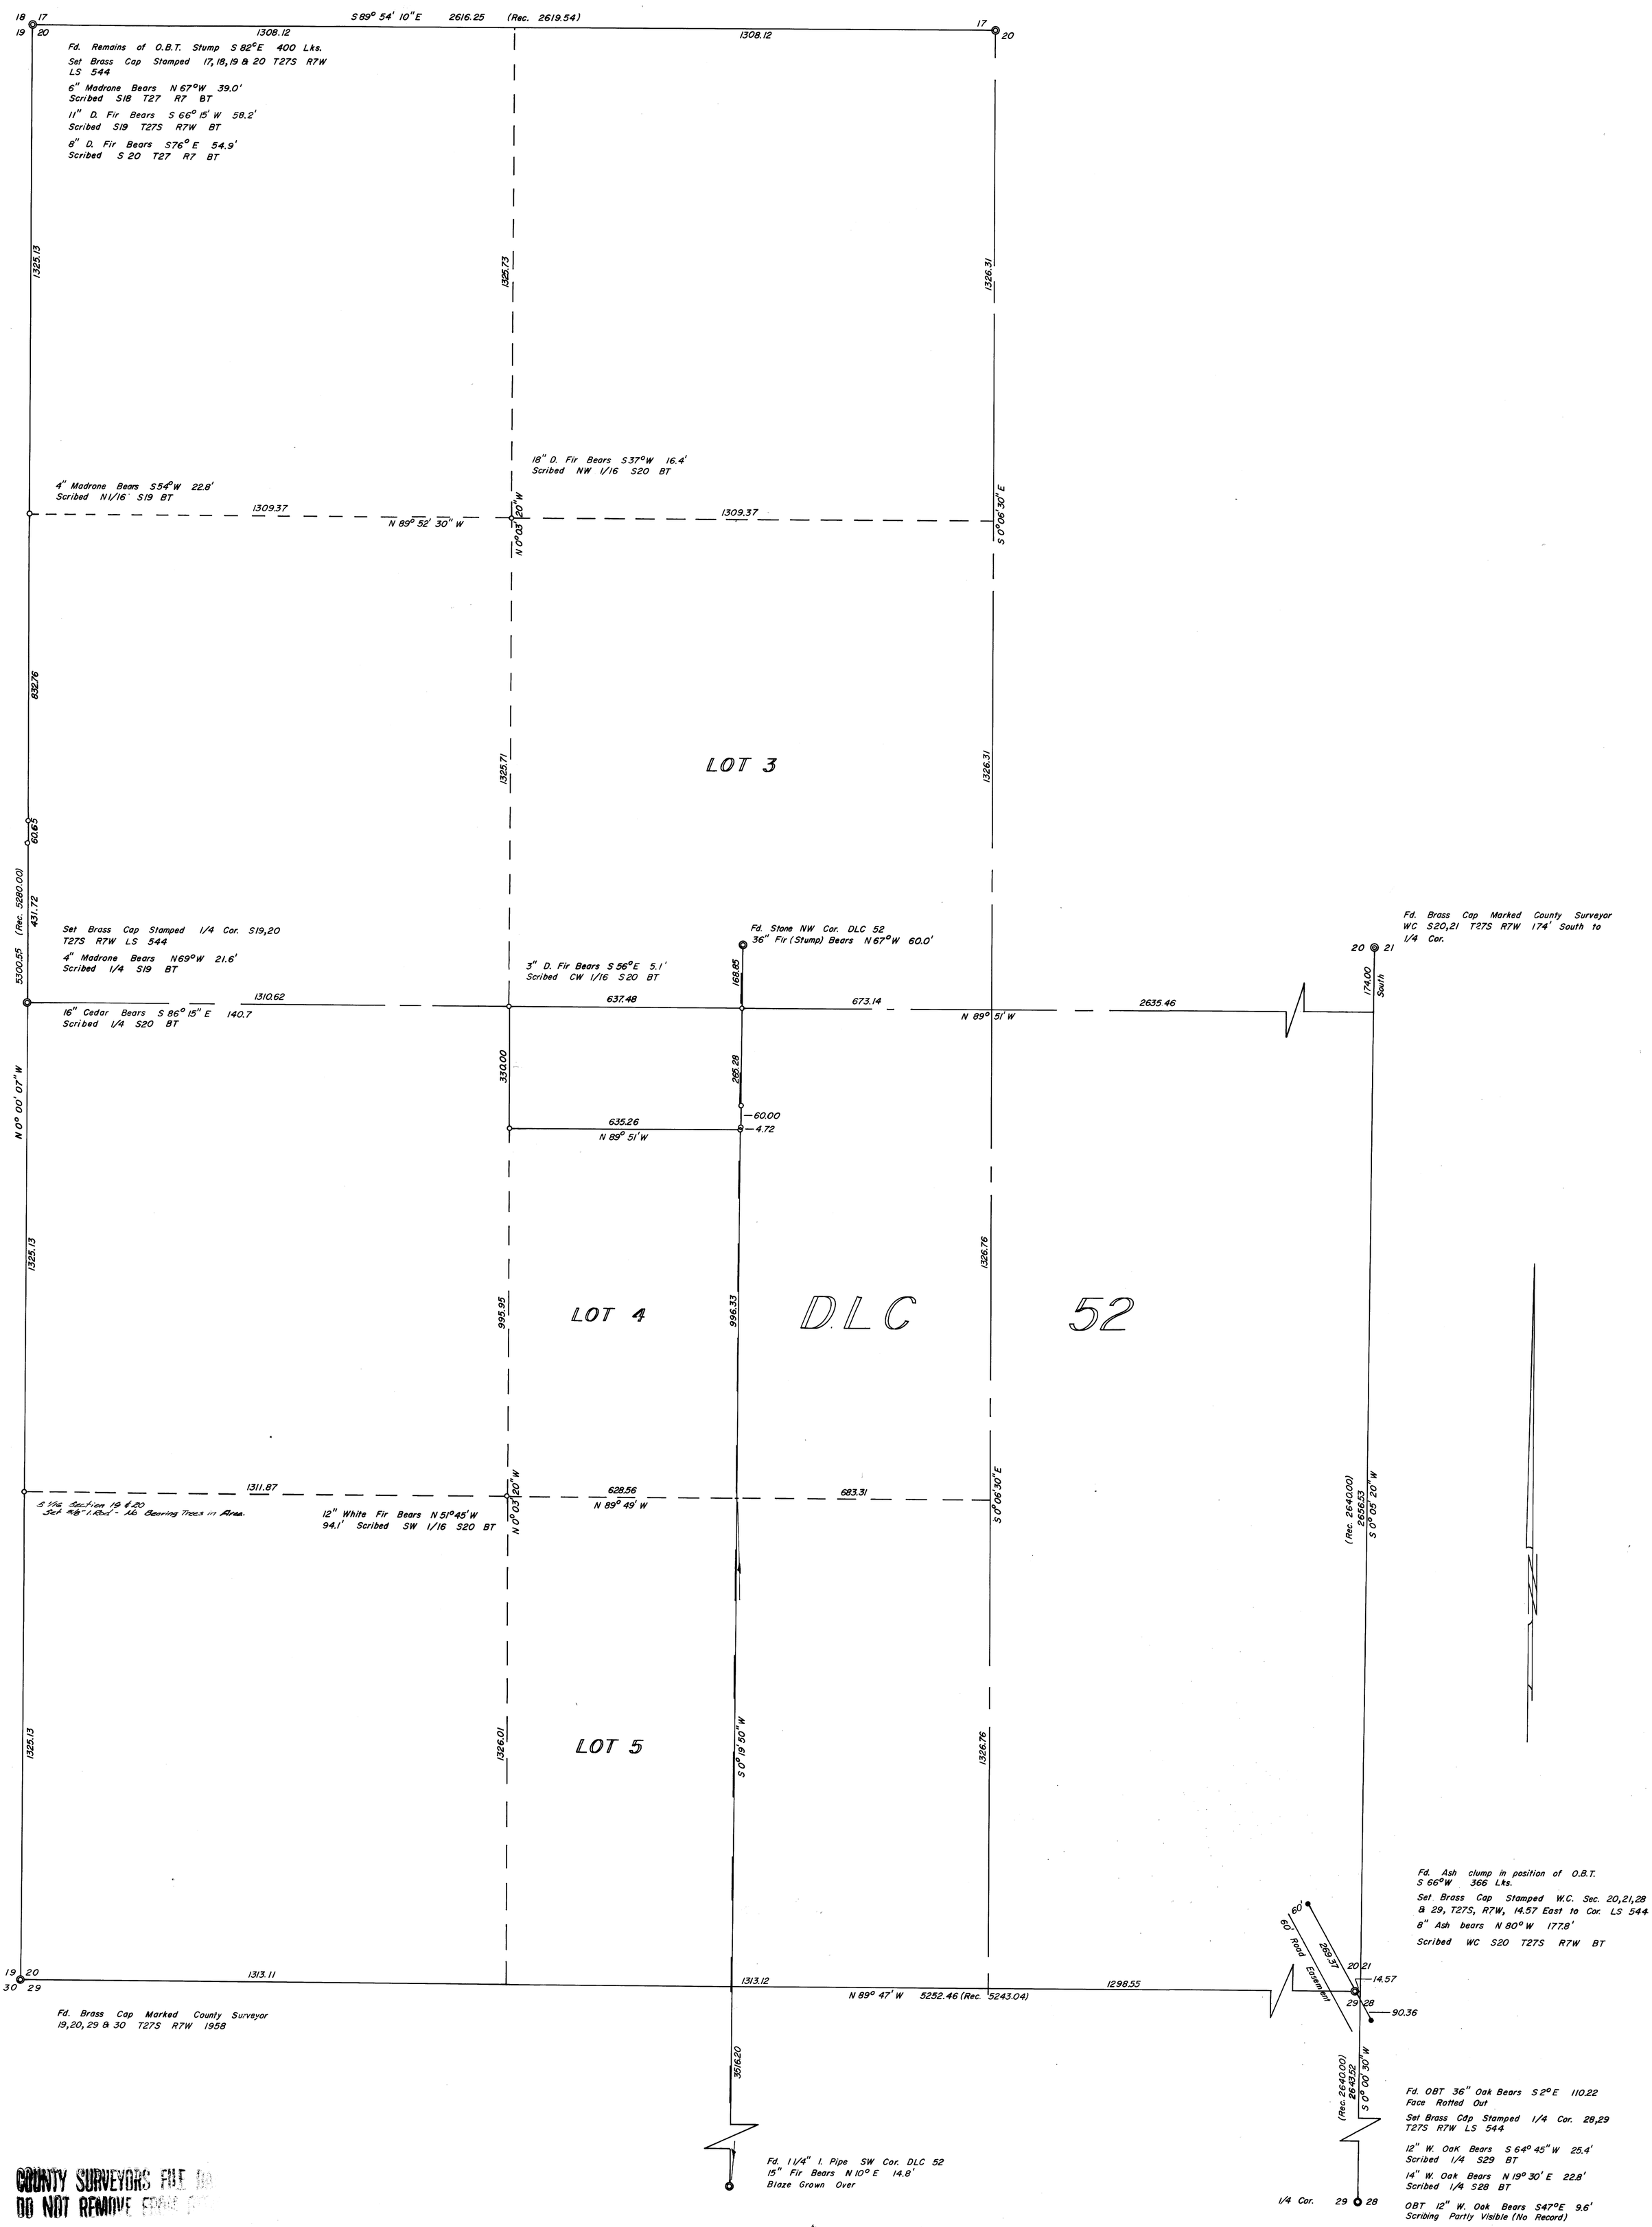

MAP FILE M 33 P 27

COUNTY SURVEYORS FILE DATA
DO NOT REMOVE FROM OFFICE