COUNTY SURVEYORS FILE ROOM
DO NOT REMOVE FROM ROOM

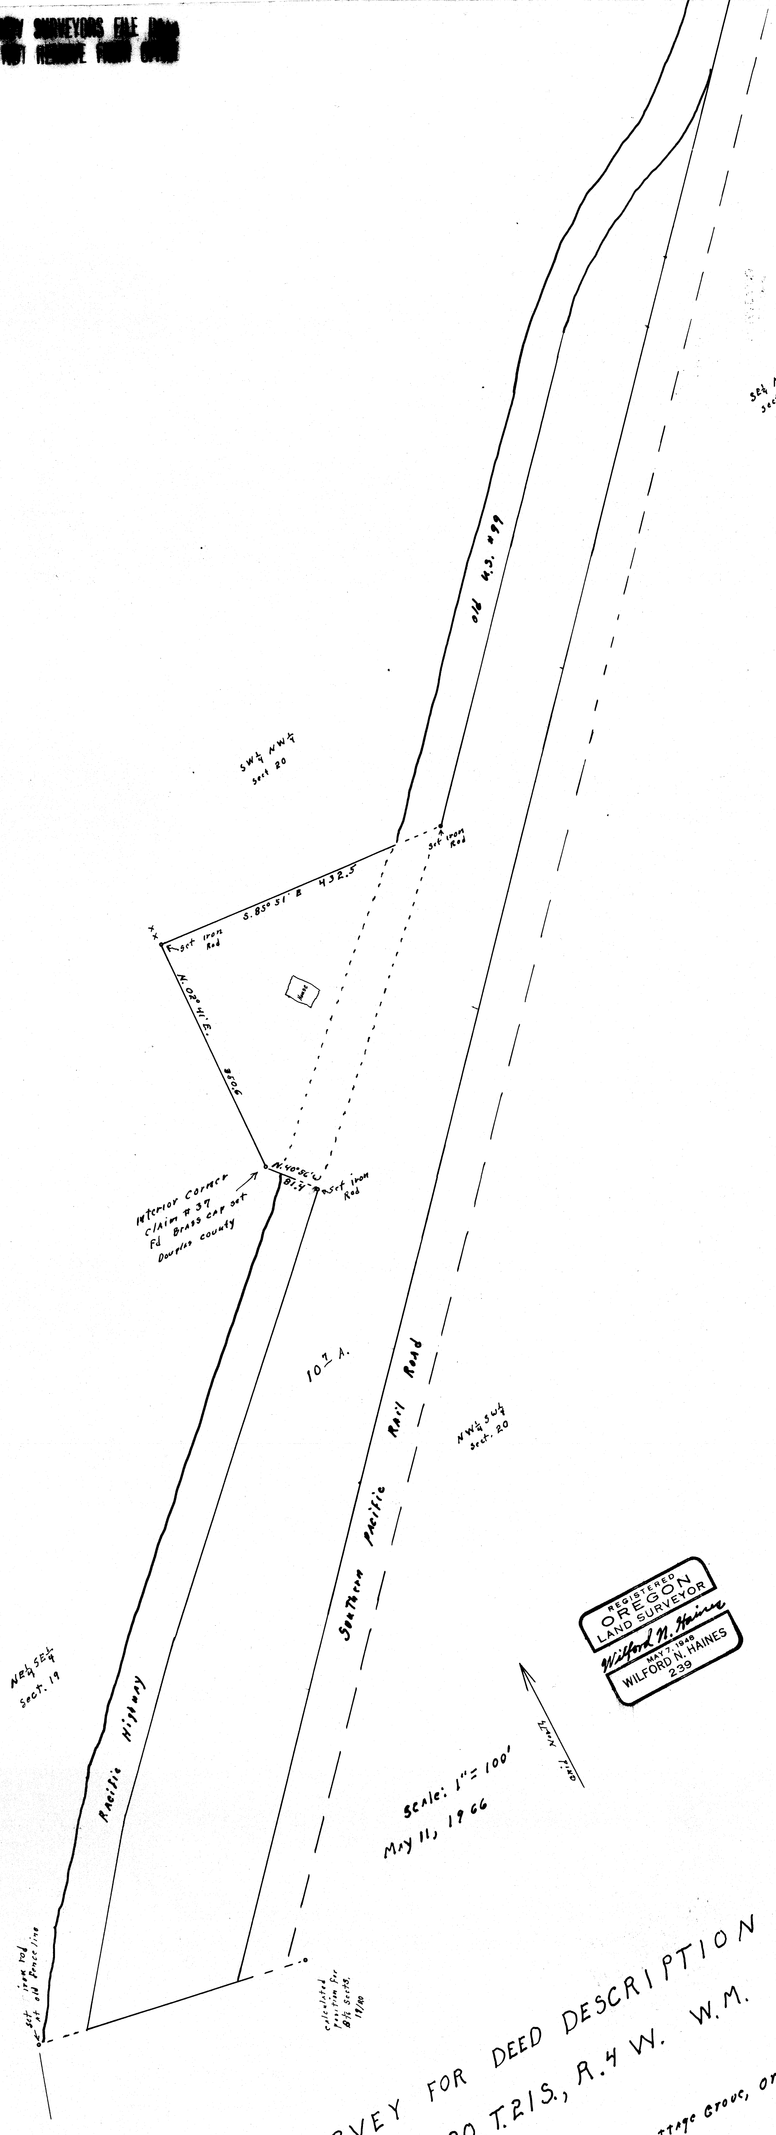

SURVEY FOR DEED DESCRIPTION

SECTS. 19 + 20, T. 21 S., R. 4 W. W.M.

for Cottage Grove, Oregon

I. R. Lawrence

FILED
RECEIVED
JUN 10 1966
COUNTY SURVEYOR
DOUGLAS COUNTY, ORE.

MAP FILE M 33 P. 3