M 33 - 45

[redacted]

SECT. 8, T. 22S., R. 9 W., W.M.

Edward Spicer D.L.C. No 39

for

Ted. Hanson 2832 Ridgeway Drive, Reedsport

scale: 1" = 100' Nov. 12, 1968

FILED
RECEIVED
NOV 18 1968
COUNTY SURVEYOR
DOUGLAS COUNTY, ORE.

REGISTERED
OREGON
LAND SURVEYOR
Wilford N. Haines
MAY 7, 1948
WILFORD N. HAINES
239

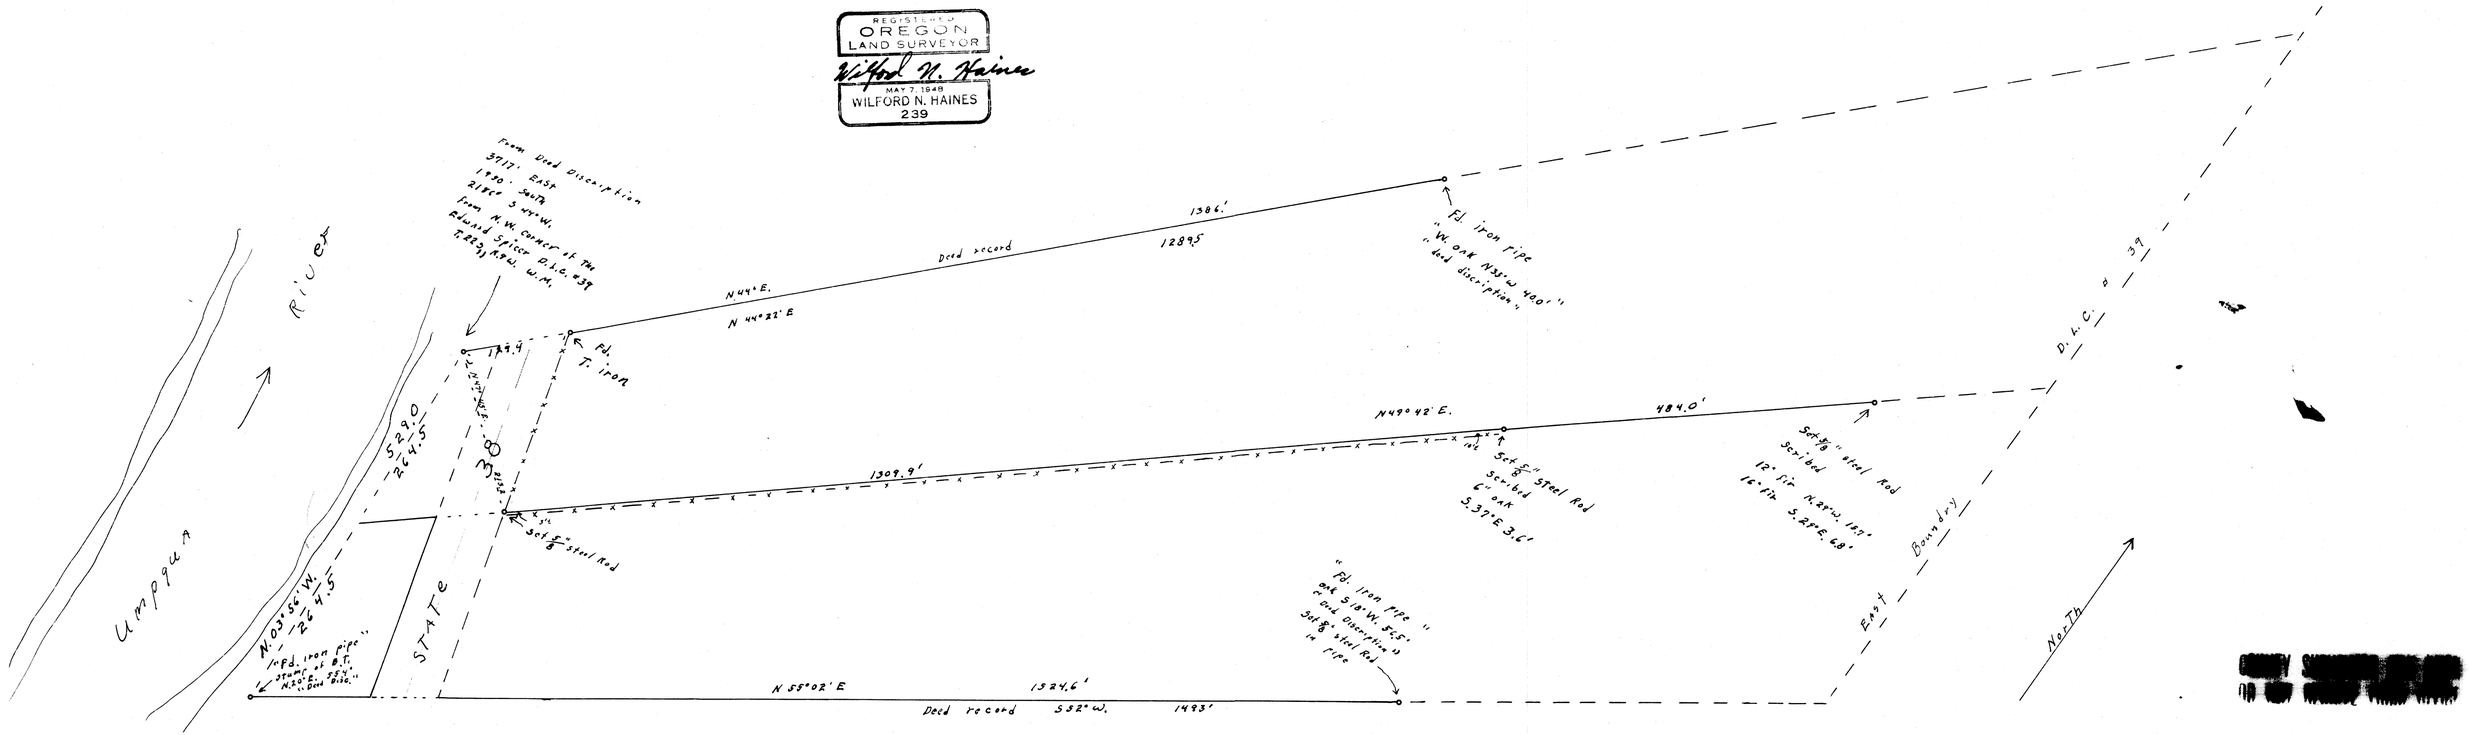

[redacted]

MAP FILE M 33 T 45