COUNTY SURVEYORS FILE DATA
DO NOT REMOVE FROM OFFICE

Hendrickson Greenacres Property

Portion of D.L.C. 39 ~ T22S, R9W W.M.
Douglas County ~ Oregon

FILED
RECEIVED
AUG 16 1966
COUNTY SURVEYOR
DOUGLAS COUNTY, ORE.

Note 'Initial Point' location taken from
'Wells Creek Acres' plat filed April 12, 1951
Surveyed by Ben B. Irving
Area included by points B1-7 and
Road R/W covered by this survey
Bearings based on plat
mentioned above

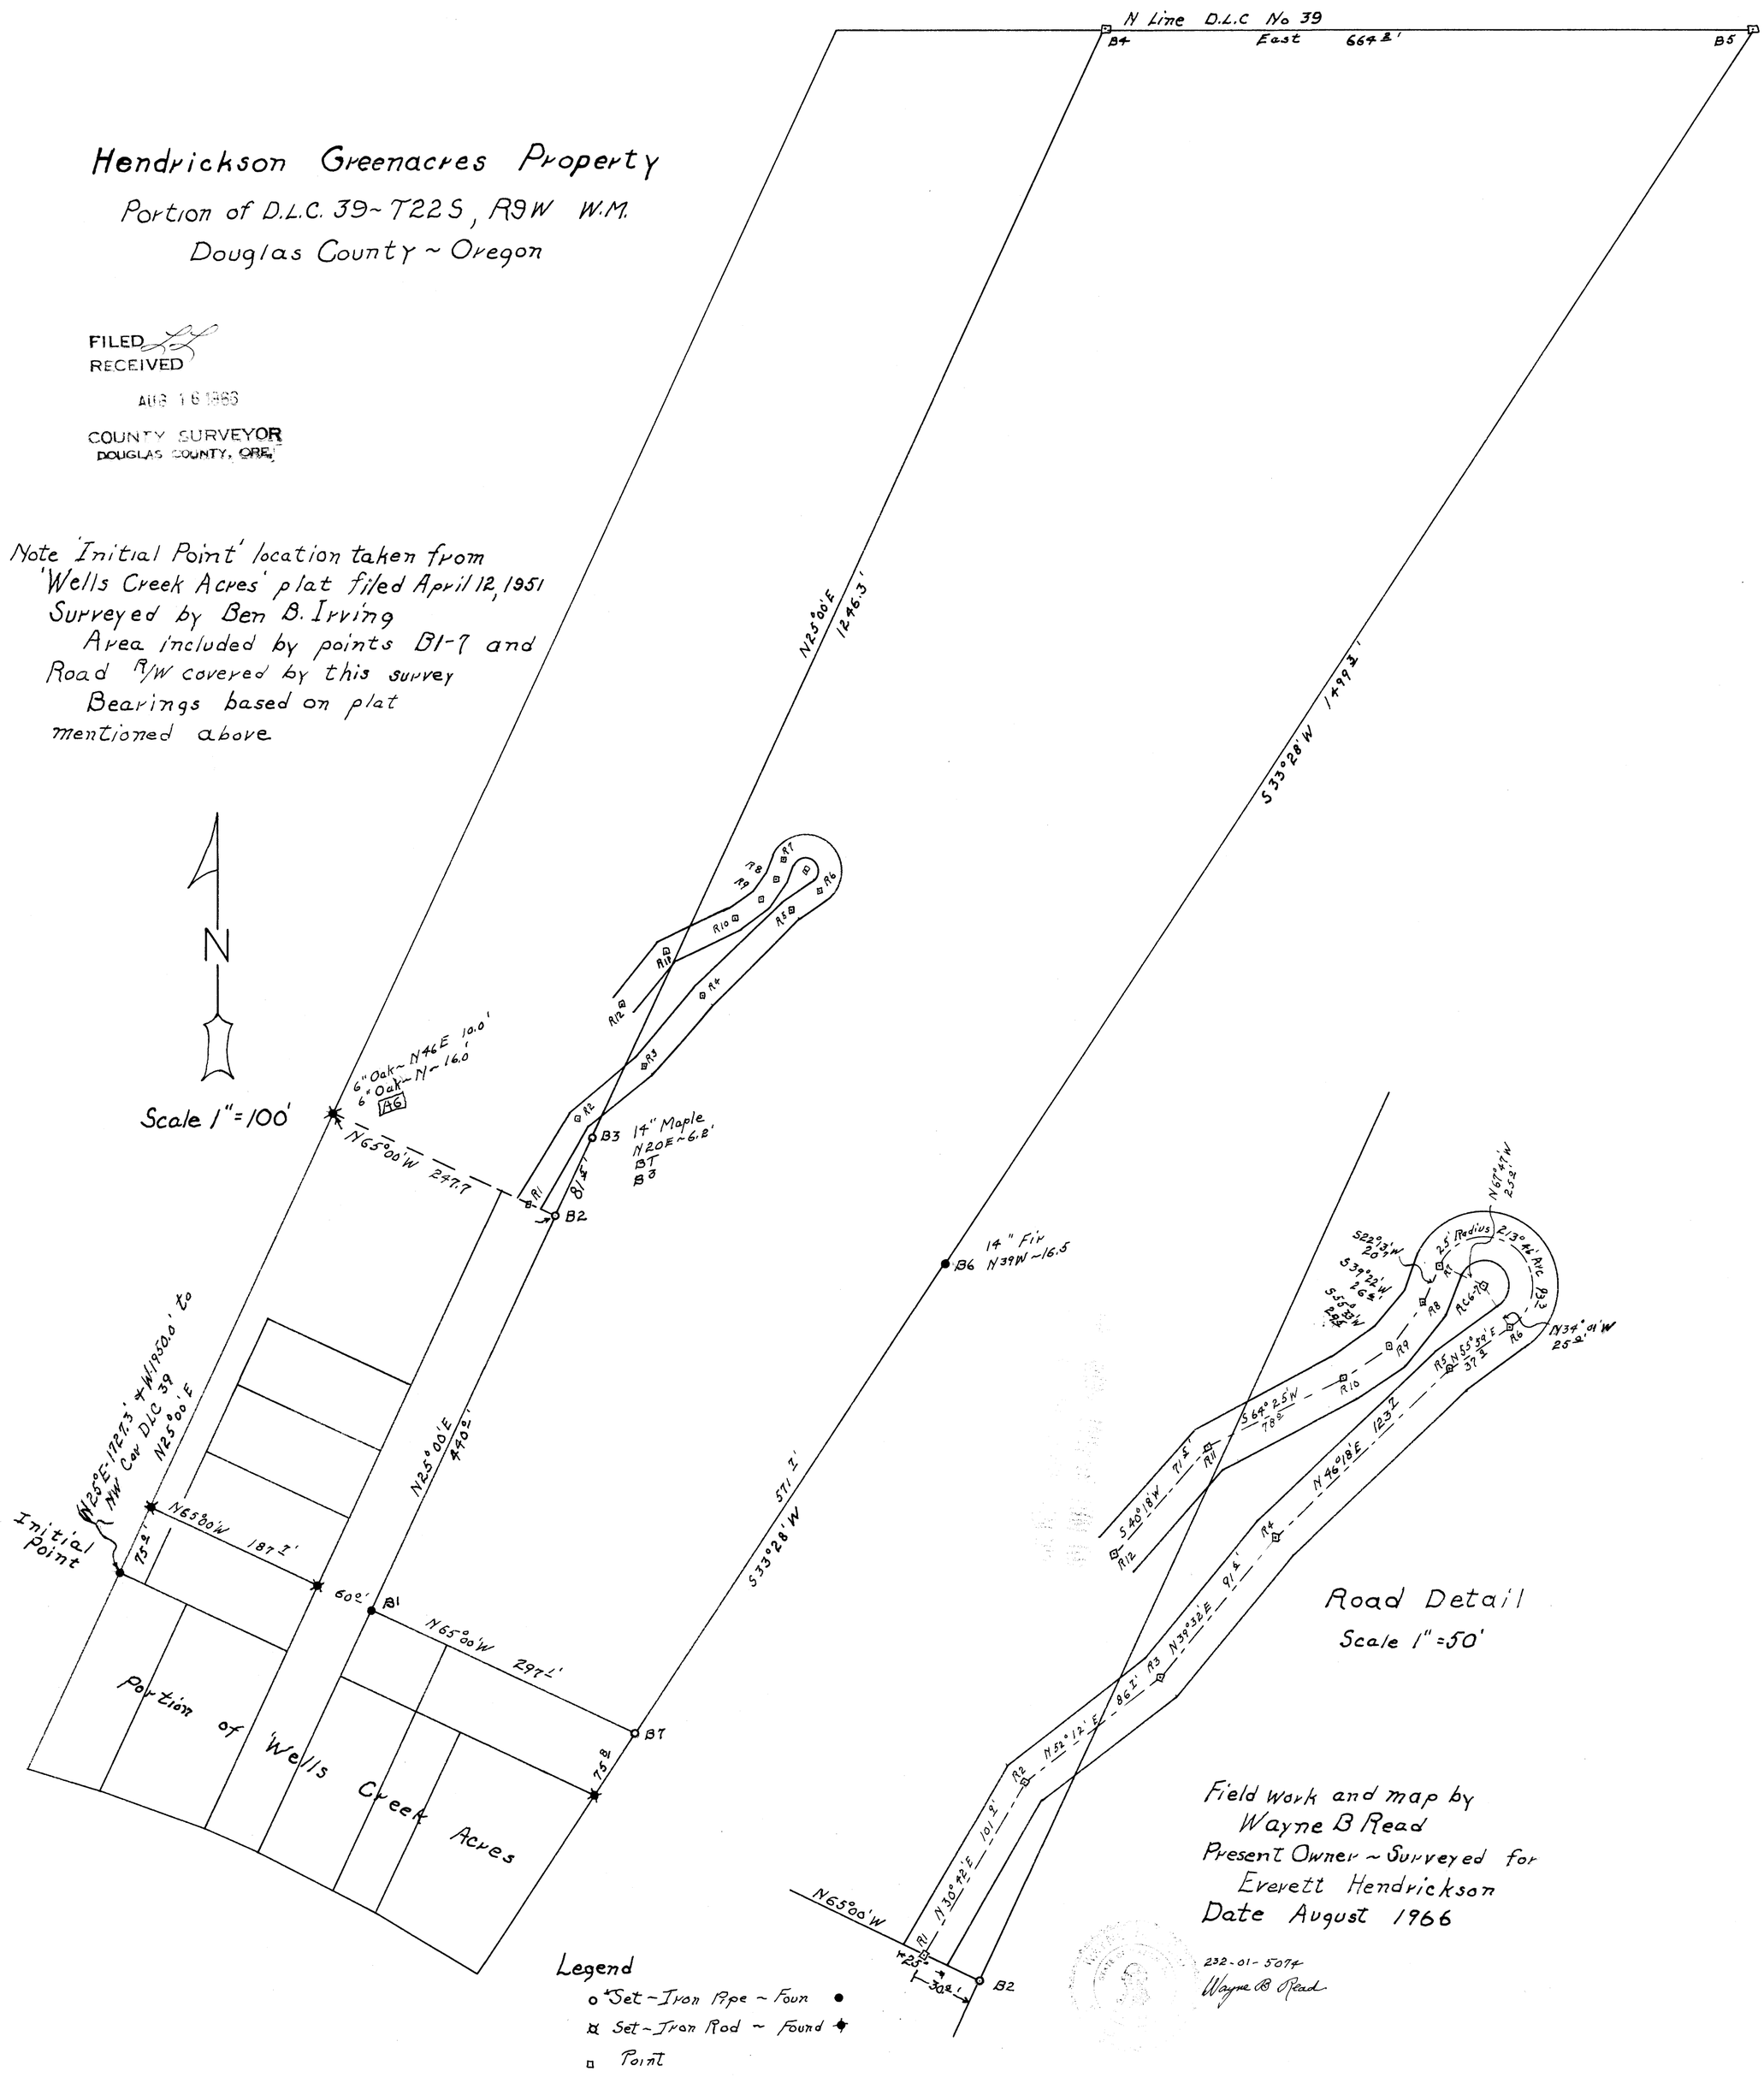

Field work and map by
Wayne B Read
Present Owner ~ Surveyed for
Everett Hendrickson
Date August 1966

232-01-5074
Wayne B Read

COUNTY SURVEYORS FILE DATA
DO NOT REMOVE FROM OFFICE

MAP FILE M 337-6