M33-60

COUNTY SURVEYORS FILE DATA
DO NOT REMOVE FROM OFFICE

FILED
RECEIVED
SEP 18 1969
COUNTY SURVEYOR
DOUGLAS COUNTY, ORE.

MAP OF SURVEY IN SEC.S 3 & 4, T 28 S, R 6 W. W.M. DOUGLAS COUNTY, ORE.

SURVEYED FOR - R.M. KORFF
ENGINEER - W.S. BARNES

AUGUST 1969
SCALE 1" = 300'

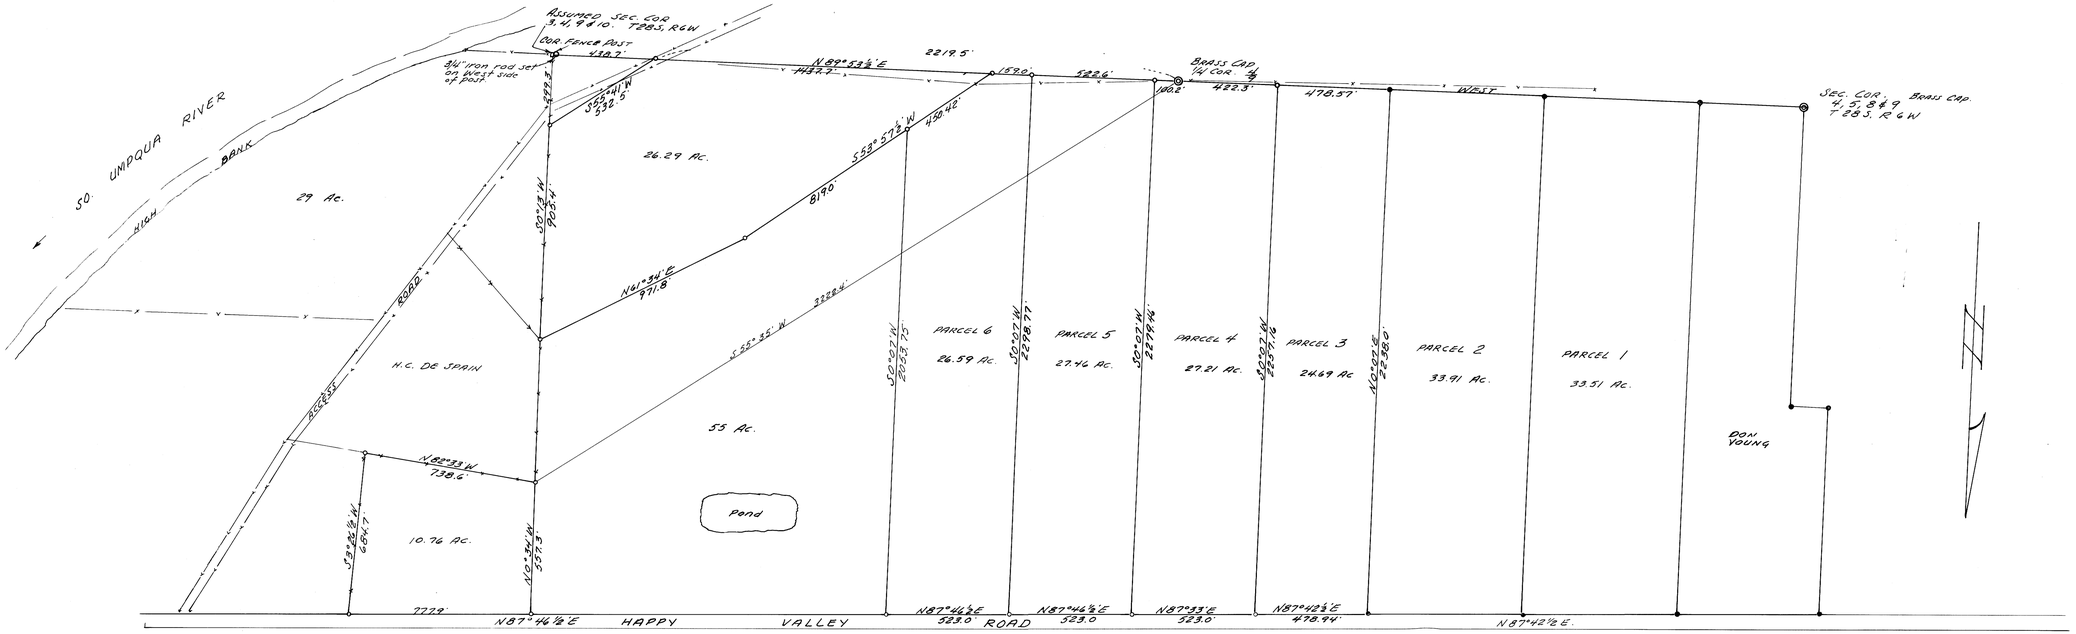

○ 3/4" IRON RODS SET
● MONUMENTS FOUND
BASE BEARING TAKEN FROM SOUTH LINE OF SEC. 4.

REGISTERED PROFESSIONAL ENGINEER 2128 OREGON SEPT 5, 1967 William S. Barnes

COUNTY SURVEYORS FILE DATA
DO NOT REMOVE FROM OFFICE

MAP FILE M33-60