MF FILE M38-78

See M 42-76

COUNTY SURVEYORS FILE DATA
DO NOT REMOVE FROM OFFICE

FILED
RECEIVED
JUL 13 1970
COUNTY SURVEYOR
DOUGLAS COUNTY, ORE.

SURVEY FOR:

STATE OF OREGON - DEPARTMENT OF FORESTRY

SECTIONS 26, 27 & 35, T22S, R12W, WM

DOUGLAS COUNTY, OREGON

TRANSIT & CHAIN SURVEY BY: D. SMITH, W. COOK, D. BROWN, S. HOWARD, B. HANSEN, B. METCALF, D. RIGHT, D. KUCERA & G. GRESHAM.

DRAWN BY: D. SMITH - MARCH 20, 1970

SCALE: 1" = 400'

LEGEND

OSBF P/C = OREGON STATE BOARD OF FORESTRY 1½"x 36" GALV. IRON PIPE WITH 3" BRONZE CAP.

WPCP	= 4"x4"x72" WHITE PAINTED CEDAR POST
YMLP	= YELLOW METAL LOCATION POSTER
IG	= 1 G
TB FP →	= TRUE BLAZED & POSTED
BTS	= BEARING TREES
BO	= BEARING OBJECT (X ON ROCK)
MR	= MOUND OF ROCK
CRS	= COURSE
( )	= RECORD DISTANCE IN CHAINS

FOR DETAILED REPORT ON FOUND CORNERS SEE COUNTY RECORDS. NEW CORNERS AND ASSESSORIES MARKED ACCORDING TO " MANUAL OF INSTRUCTIONS FOR THE SURVEY OF THE PUBLIC LANDS OF THE UNITED STATES."
OTHER MARKINGS AS INDICATED (----------)
ESTABLISHED = NEW CORNER SET
REESTABLISHED = LOST GLO, CADASTRAL OR OTHER CORNER RESET BY PROPORTIONATE MEASUREMENT OR AS NOTED.

SOLAR OBSERVATION

MAGNETIC VARIATION	19° 14' E
DATE	AUGUST 29, 1968
STANDARD TIME	08:45:16 AM
LOCAL TIME	08:16:25 AM
REF. & PAR. CORRECTION	- 1.3'
TRUE ALTITUDE	32° 42' 24"
LATITUDE	43° 37' 34"
SUN'S DECLINATION	N 9° 10'
PLACE OF OBSERVATION	S 58° 20' 46" W

554.80' FROM SECTION CORNER 26, 27, 34 & 35.

REGISTERED OREGON LAND SURVEYOR
Arnold G. Gibson
NOV. 4, 1955
ARNOLD G. GIBSON
359

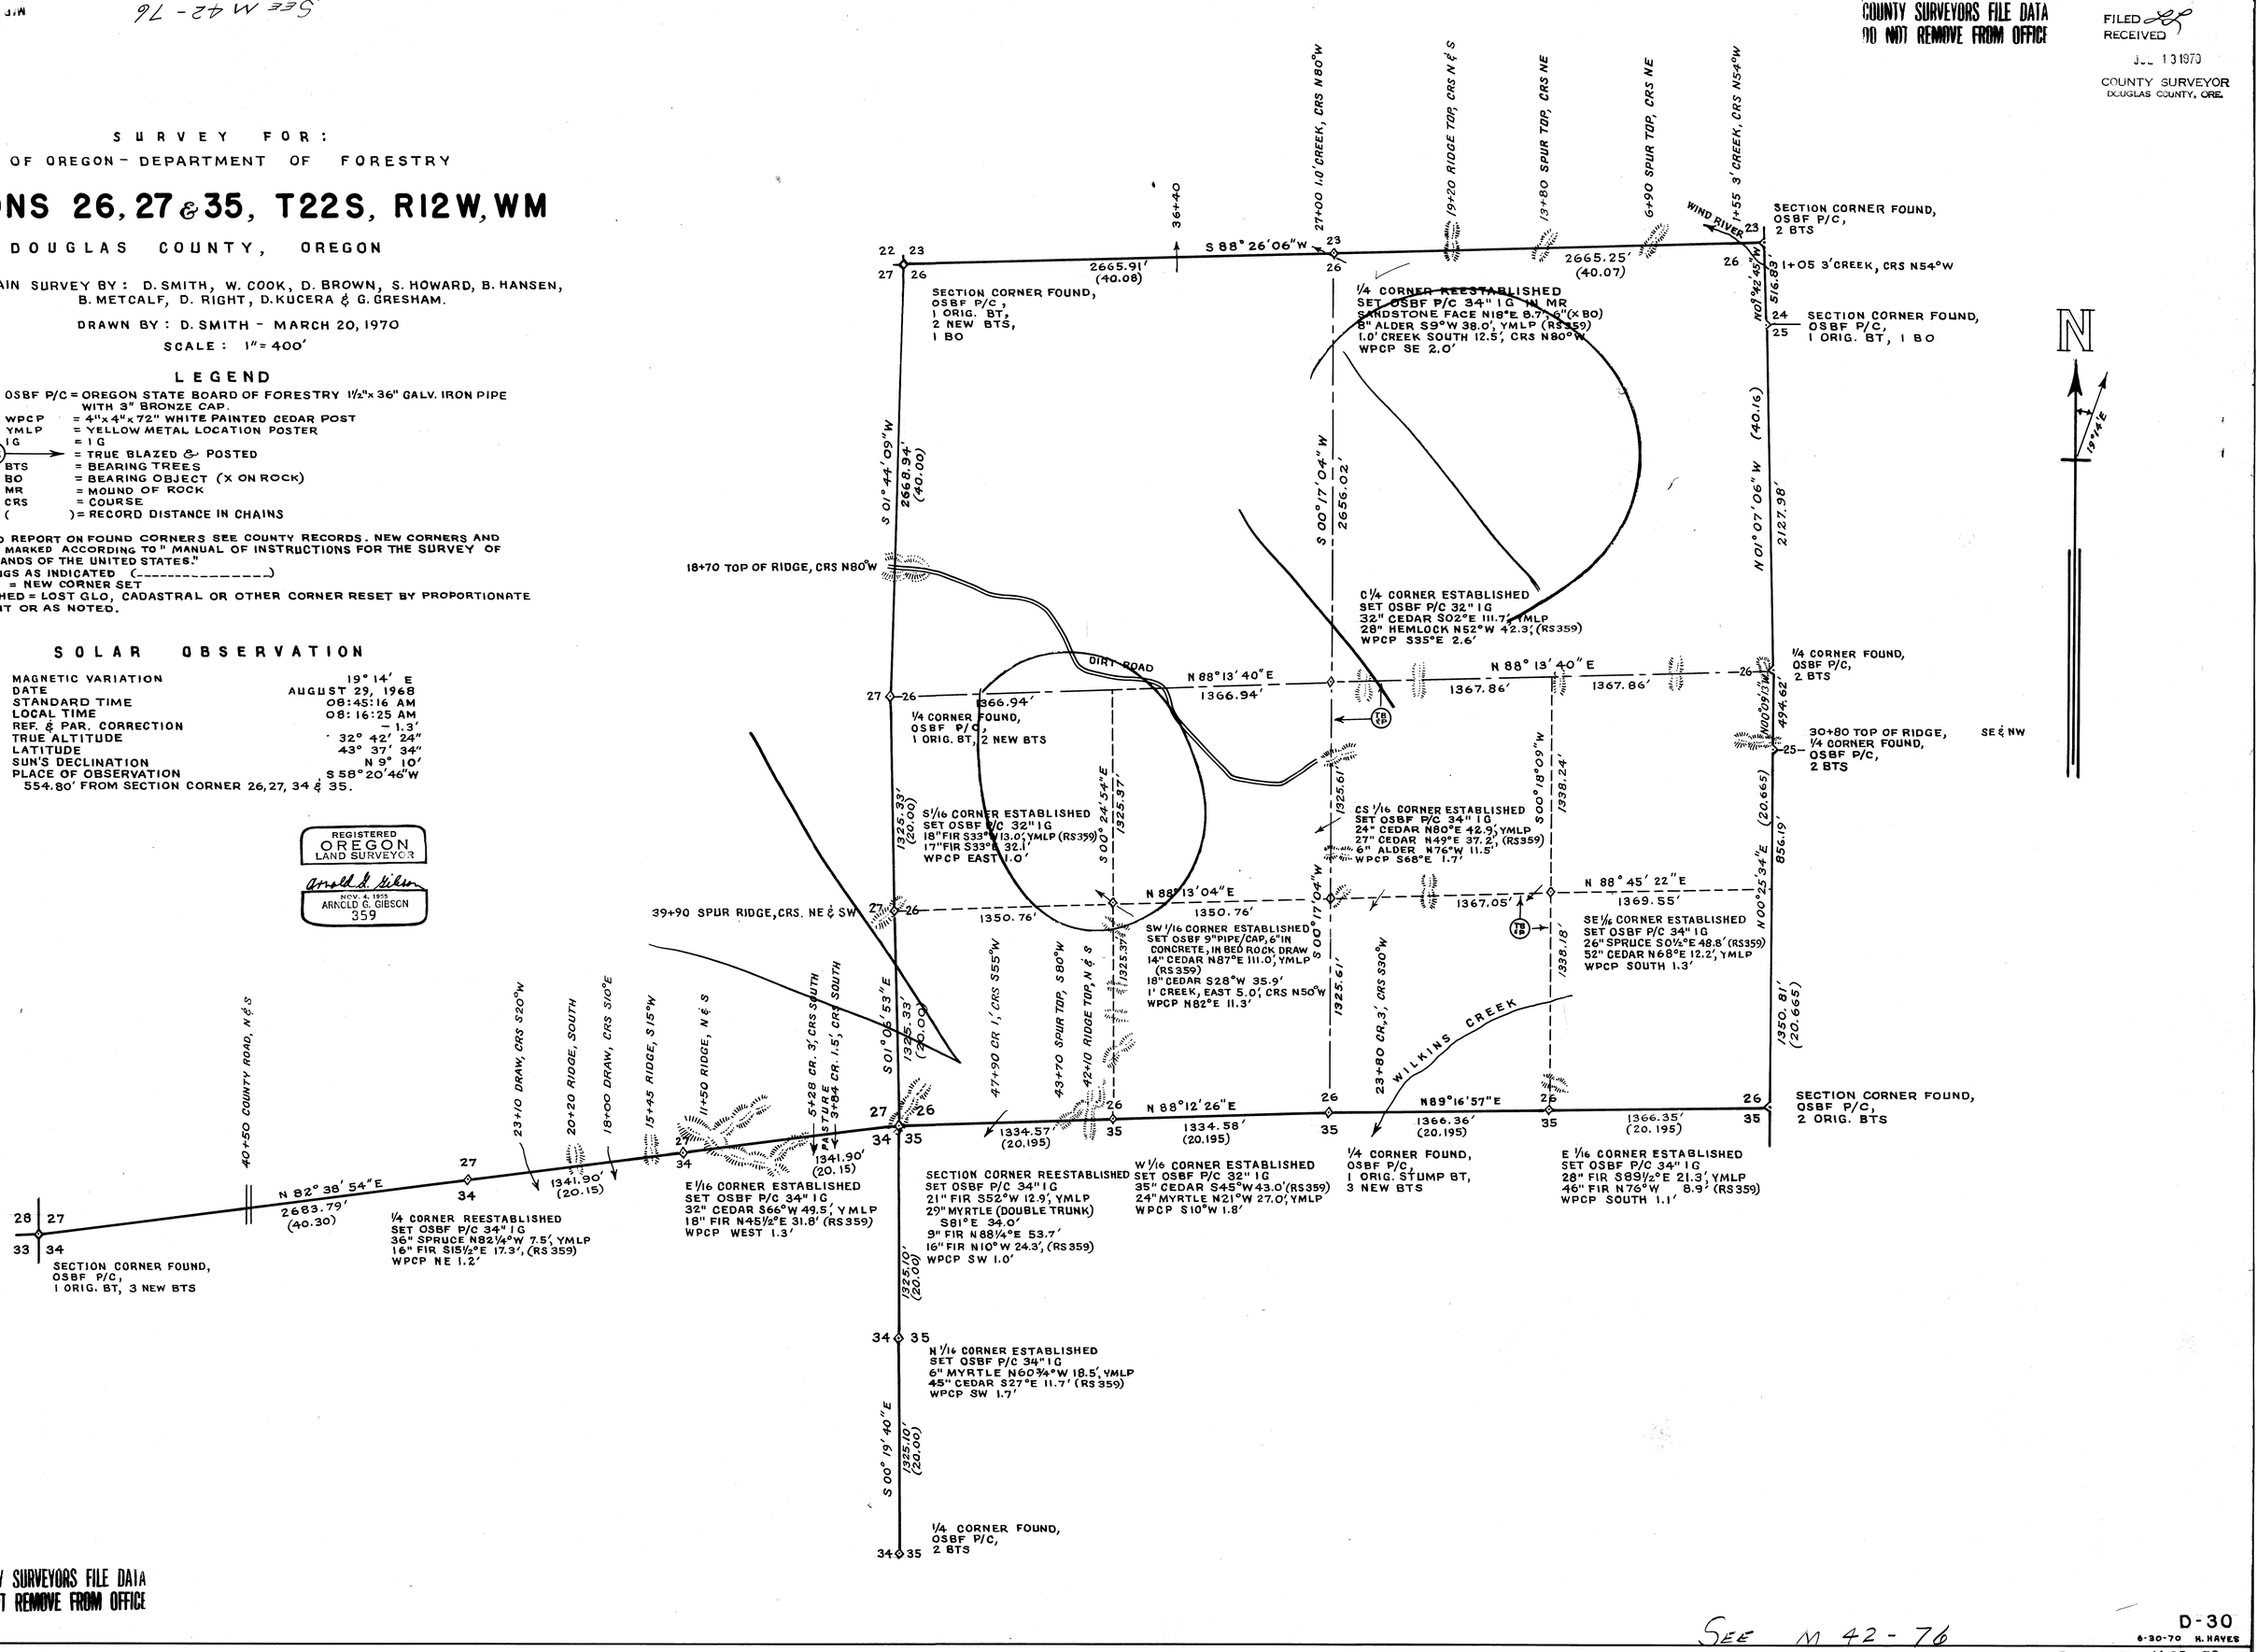

COUNTY SURVEYORS FILE DATA
DO NOT REMOVE FROM OFFICE

See M 42-76

D-30
6-30-70 H. HAYES

M35-79