COUNTY SURVEYORS FILE DATA
DO NOT REMOVE FROM OFFICE

SURVEY TO SET PROPERTY CORNERS
LOTS 7 & 8, BLK. 24, RIVERSIDE ADD'N. TO ROSEBURG
SURVEYED FOR JAMES DEWAR by BRUCE ROGERS
MAY, 1967 SCALE - 1" = 100'

FILED
RECEIVED
MAY 3 1 1967
COUNTY SURVEYOR
DOUGLAS COUNTY, ORE.

MAP FILE M34 + 11

○ MONUMENTS FD.
● 5/8" I.R. SET.

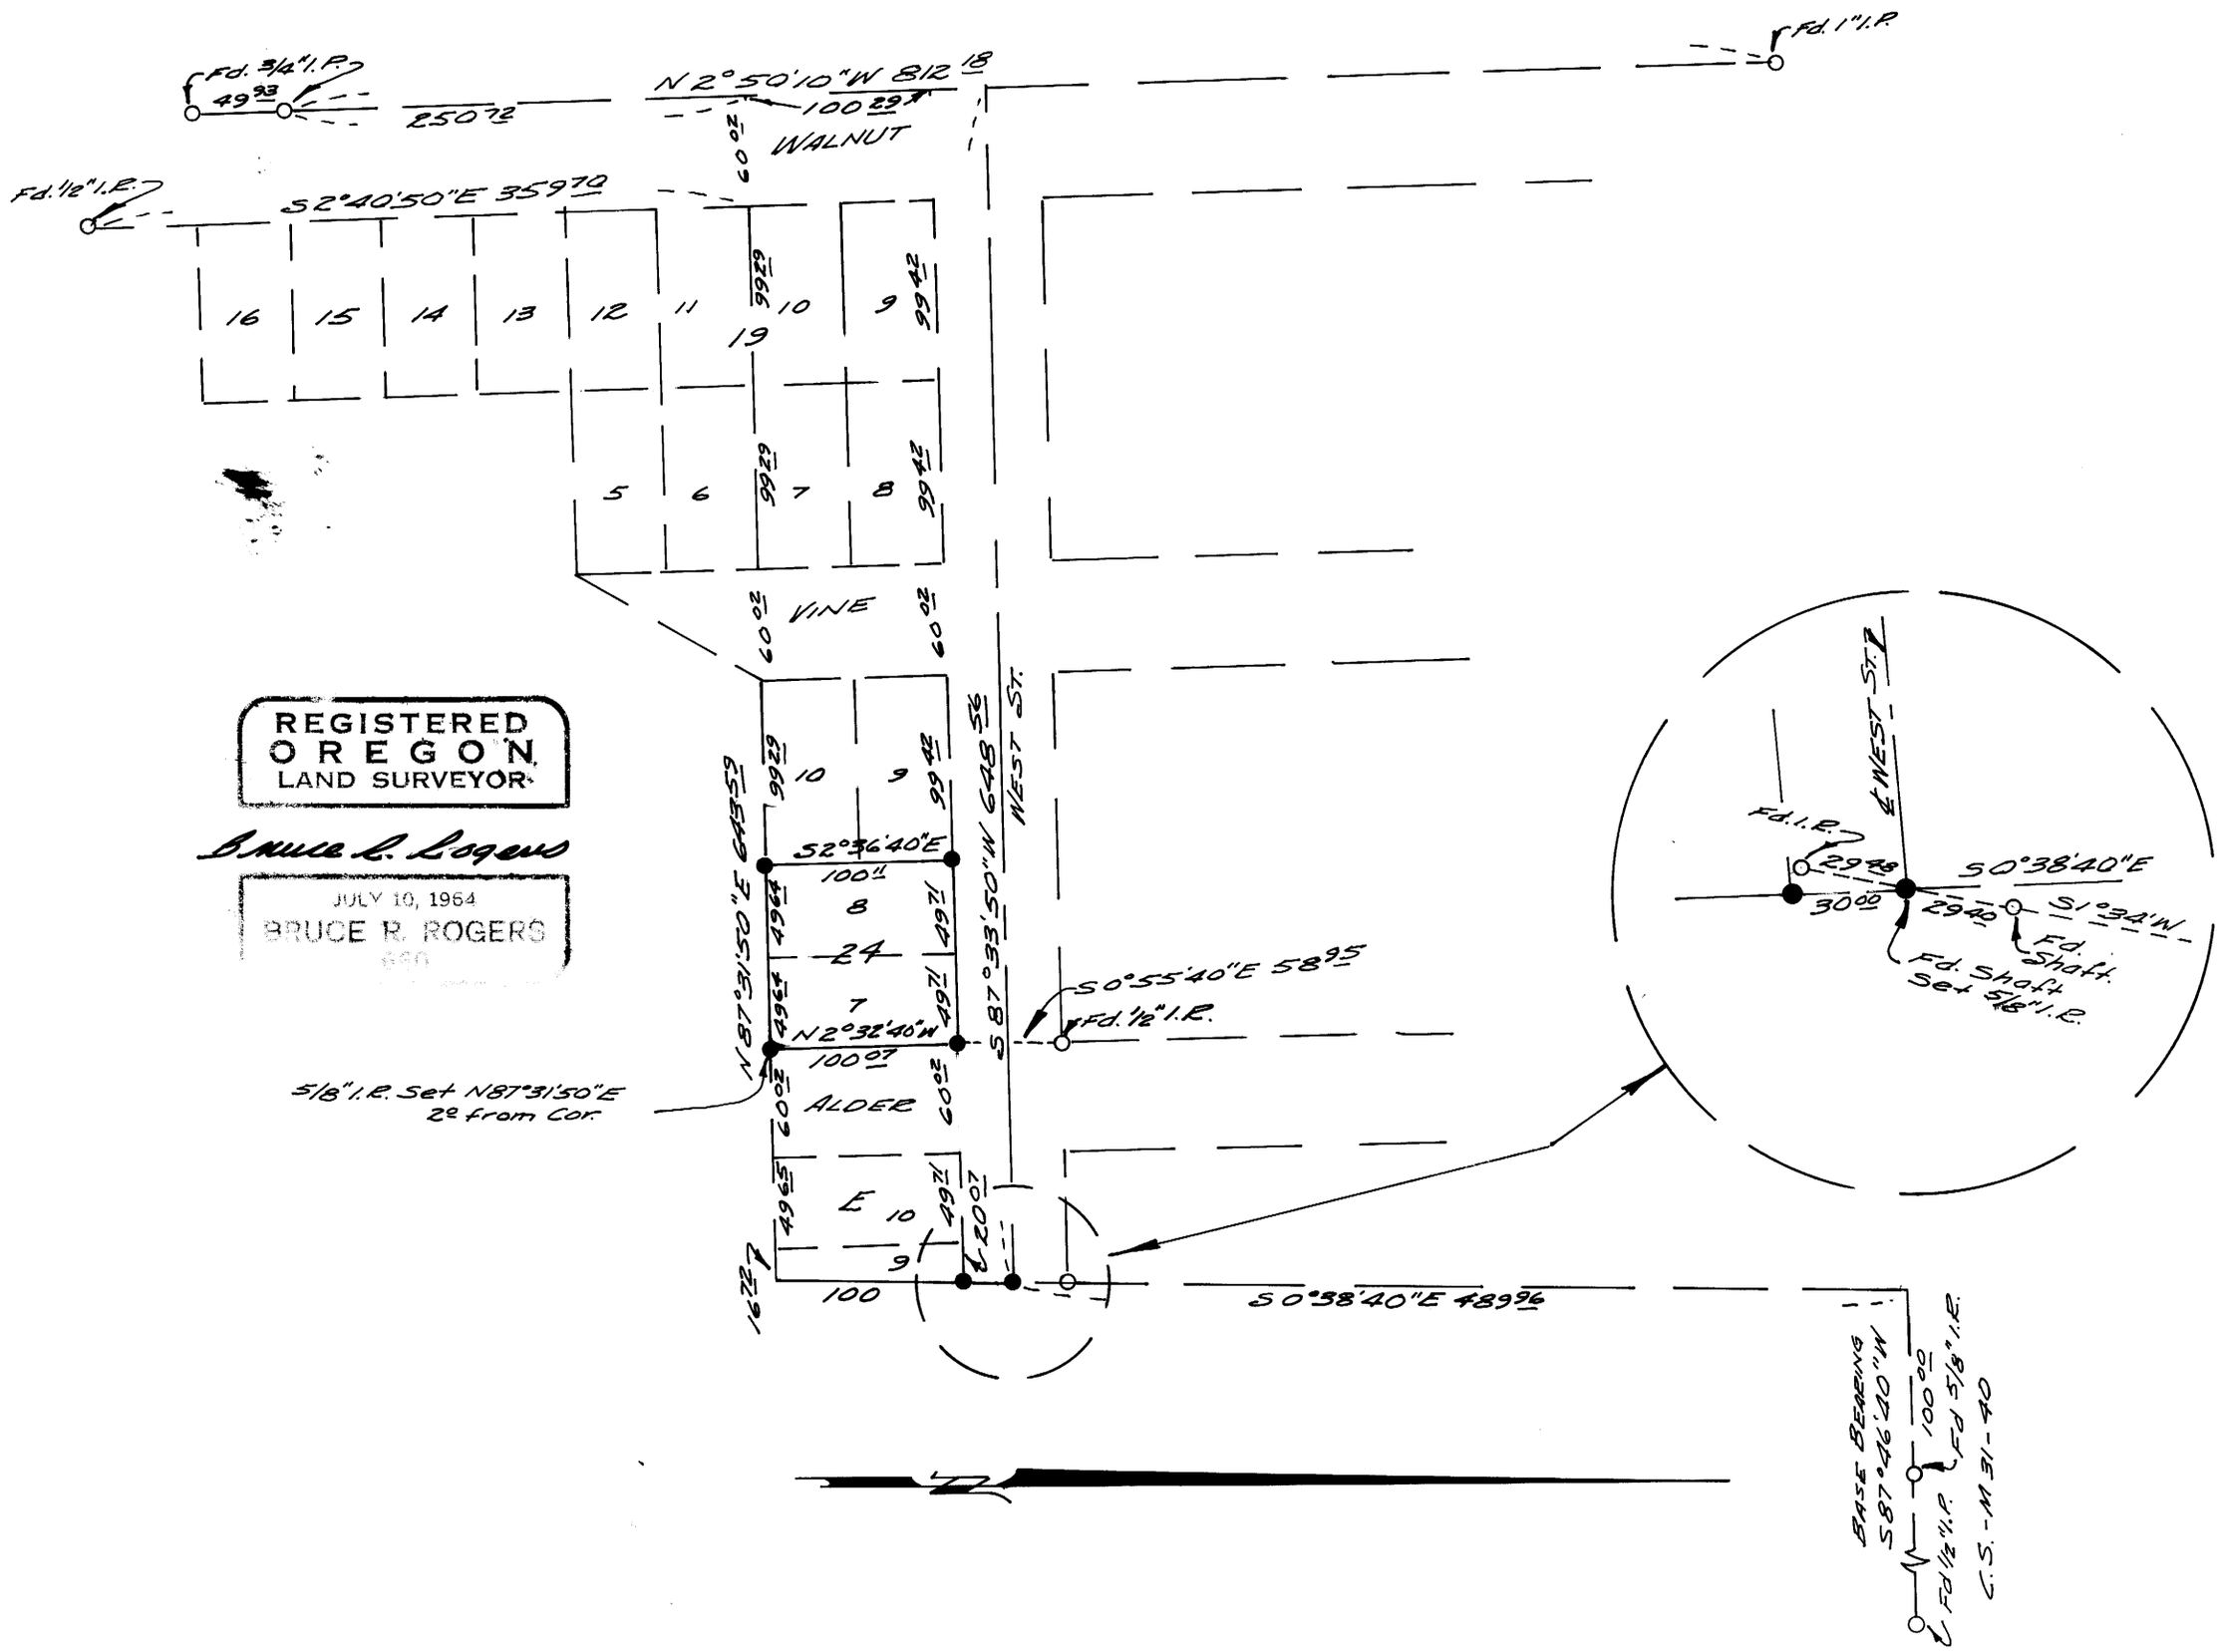

REGISTERED
OREGON
LAND SURVEYOR

Bruce R. Rogers

JULY 10, 1964
BRUCE R. ROGERS

MAP FILE M34 + 11