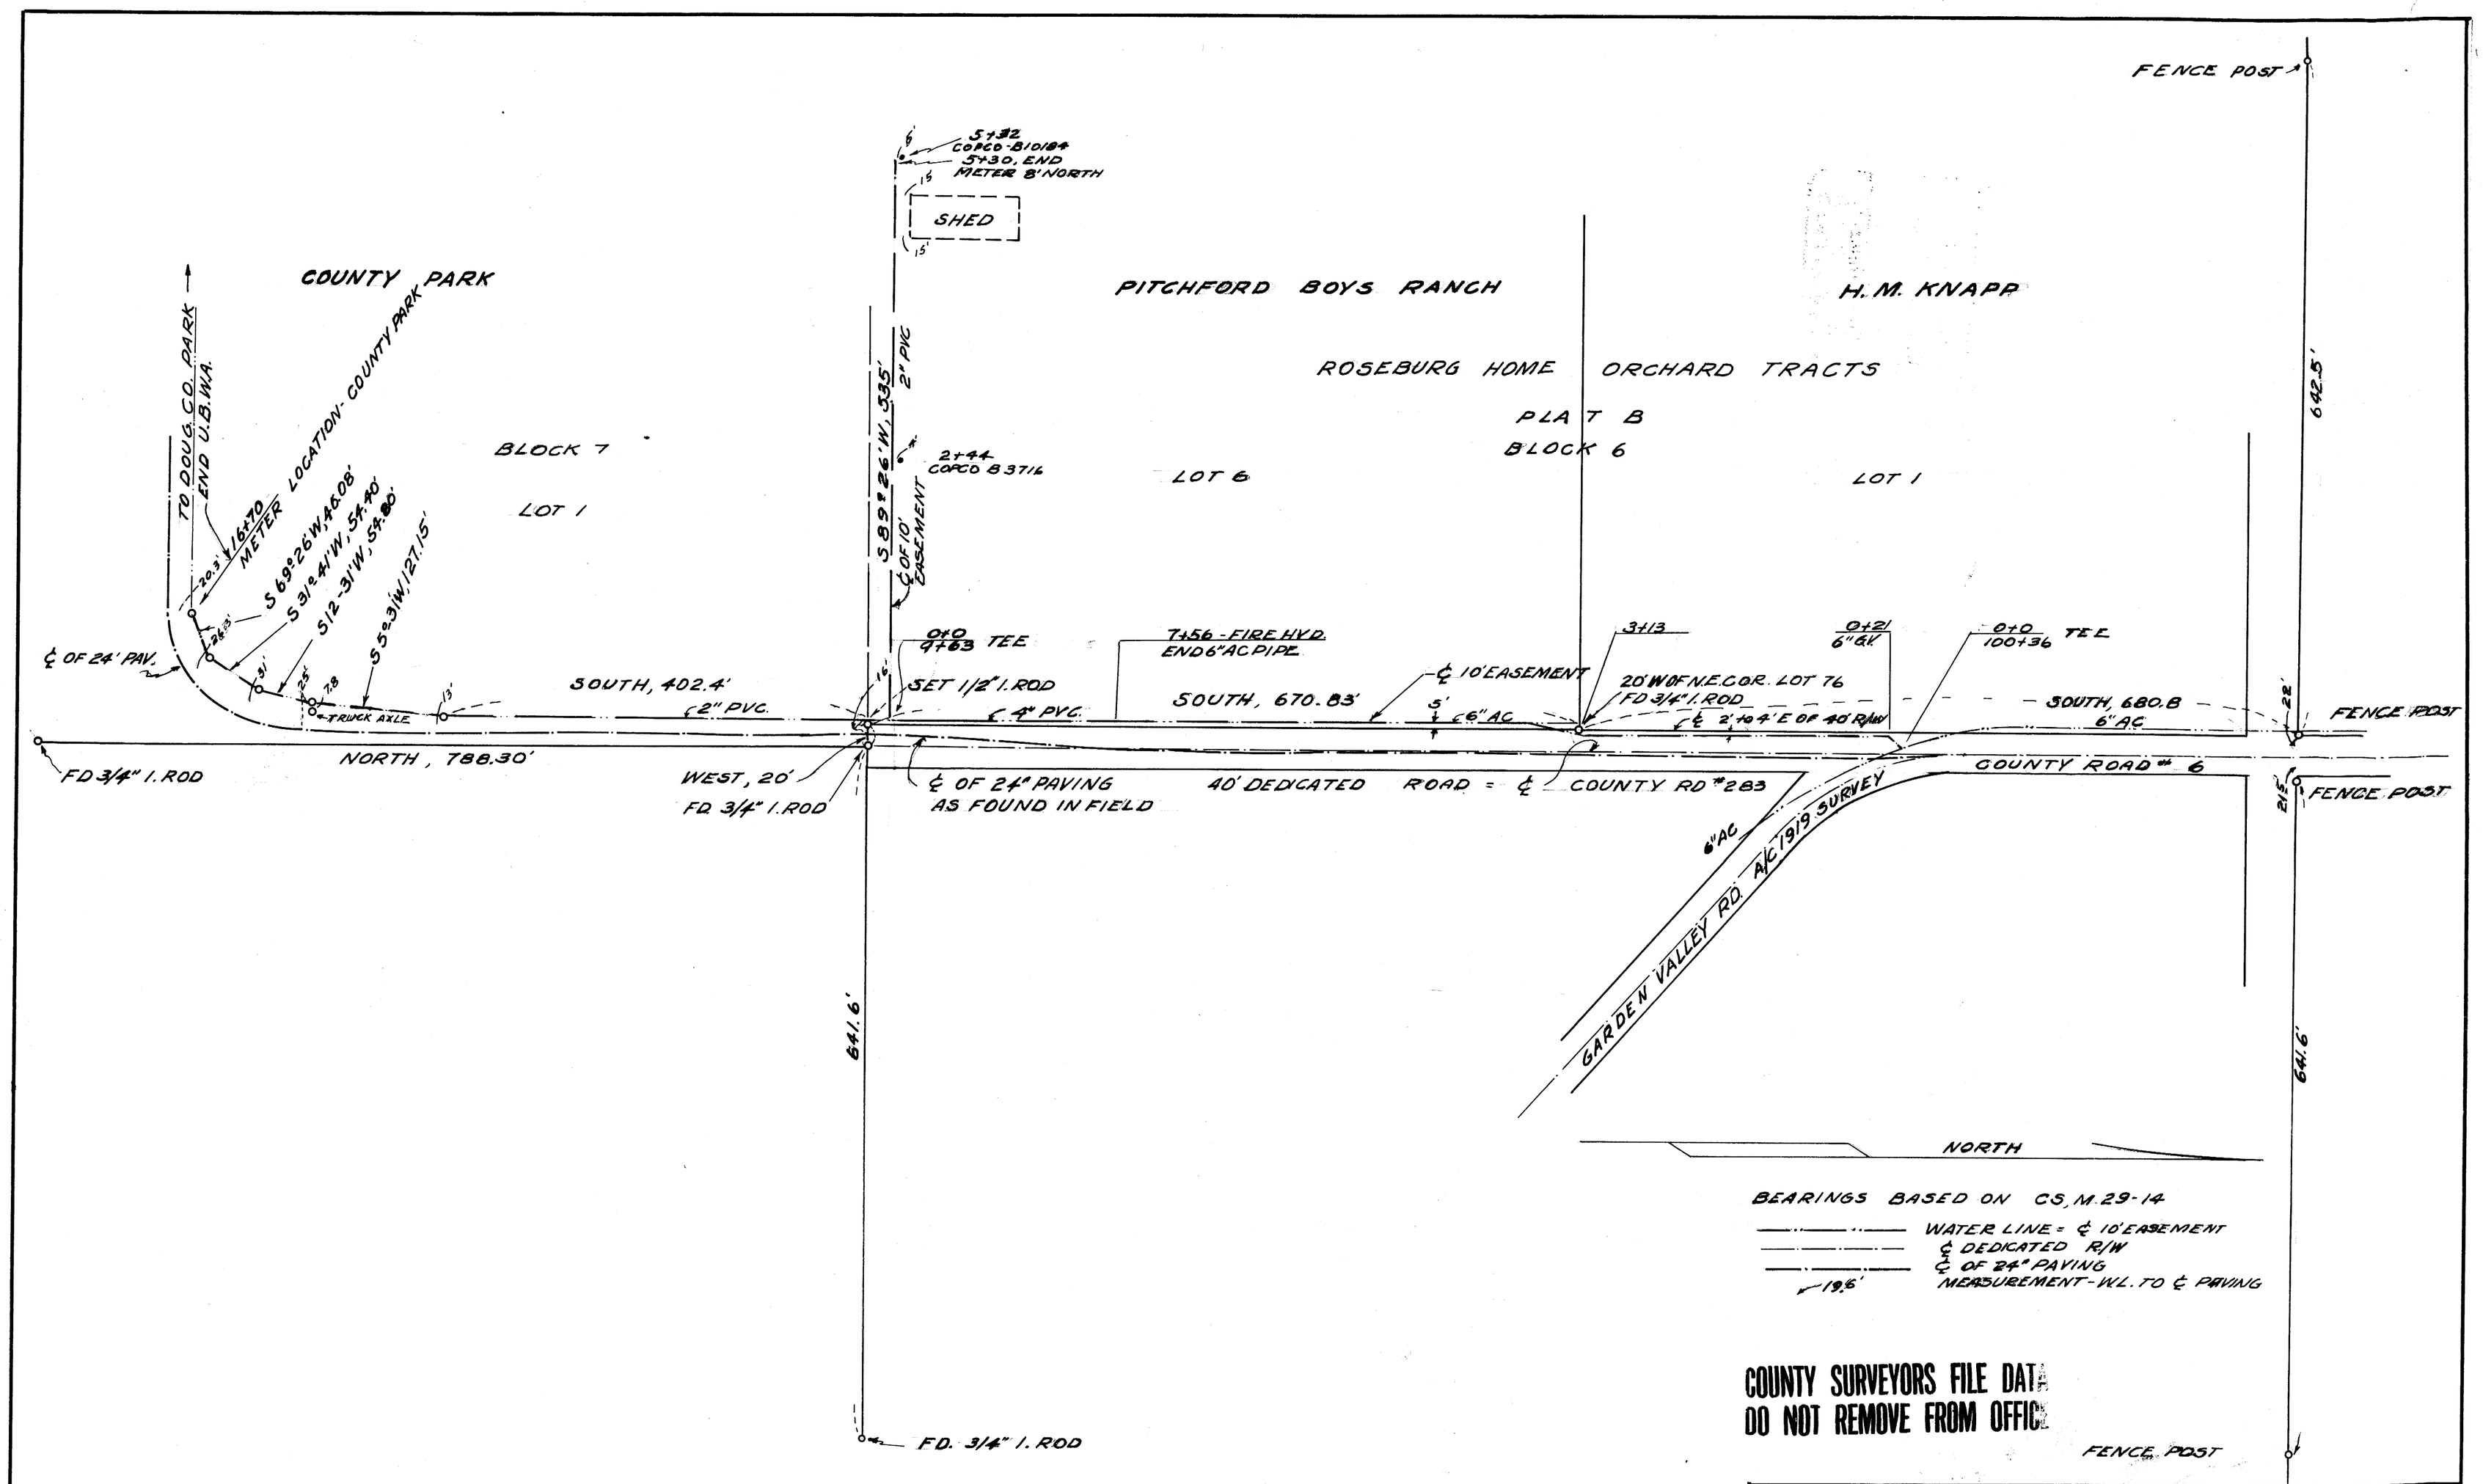

COUNTY SURVEYORS FILE DATA
DO NOT REMOVE FROM OFFICE

REGISTERED
OREGON
LAND SURVEYOR

Herbert L. Northcraft

JULY 8, 1966
HERBERT L. NORTHCRAFT
750

FILED
RECEIVED
MAY 9 1967
COUNTY SURVEYOR
DOUGLAS COUNTY, ORE.

UMPQUA BASIN WATER ASSOC. INC.
ROSEBURG, ORE.

EASEMENT SURVEY FOR WATER LINES
IN LOT 1 FOR M.M. KNAPP & LOT 6 BLOCK 6,
& LOT 1, BLOCK 7. FOR DOUGLAS COUNTY IN PLAT B,
ROSEBURG HOME ORCHARD TRACTS, IN
SEC'S 29 & 32, T26S, R6W, W.M. DOUG. CO. ORE.

SCALE 1" = 100

MAY - 1967
SURVEY & MAP BY HLN

MAP FILE M.34 P-2

MAP FILE M.34 P-2