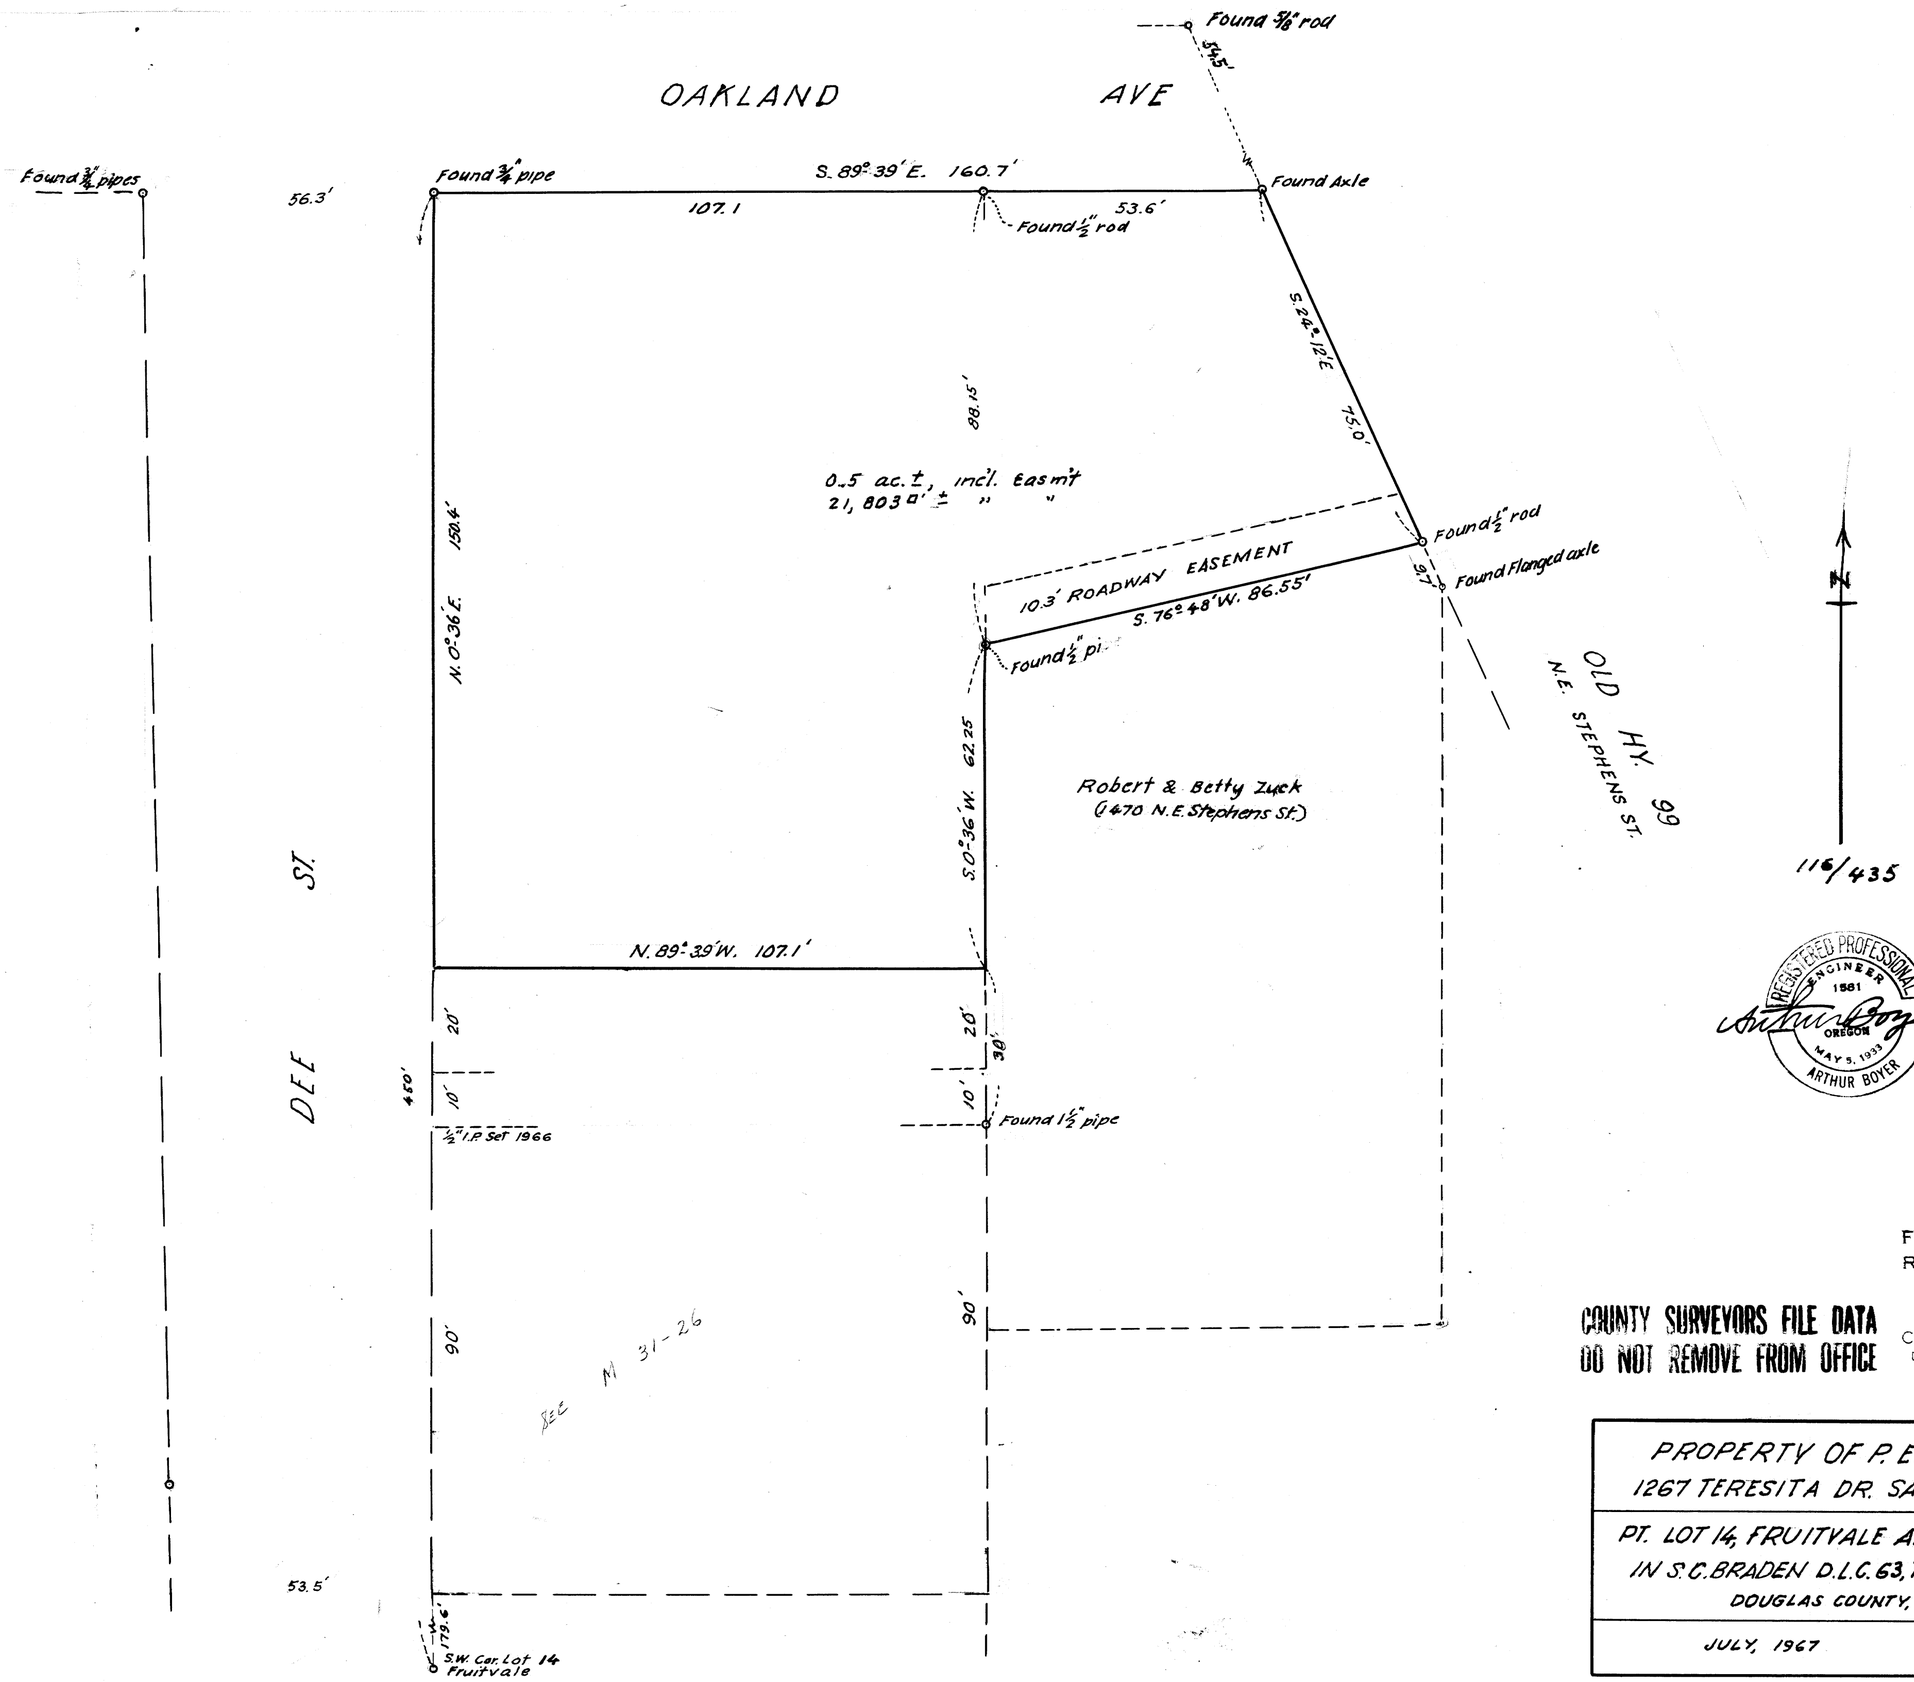

REGISTERED PROFESSIONAL ENGINEER 1581 OREGON MAY 5, 1933 ARTHUR BOYER

Arthur Boyer

FILED
RECEIVED
JUL 20 1967
COUNTY SURVEYOR
DOUGLAS COUNTY, ORE.

COUNTY SURVEYORS FILE DATA
DO NOT REMOVE FROM OFFICE

PROPERTY OF P. E. RILEY,
1267 TERESITA DR. SAN JOSE, CALIF.

PT. LOT 14, FRUITVALE ADD TO ROSEBURG,
IN S.C. BRADEN D.L.C. 63, T.27S; R.6W; W.M;
DOUGLAS COUNTY, ORE.

JULY, 1967 1" = 20 ft.

MAP FILE M-34 P-25

MAP FILE M-34 P-25