MAP FILE M34 # 36

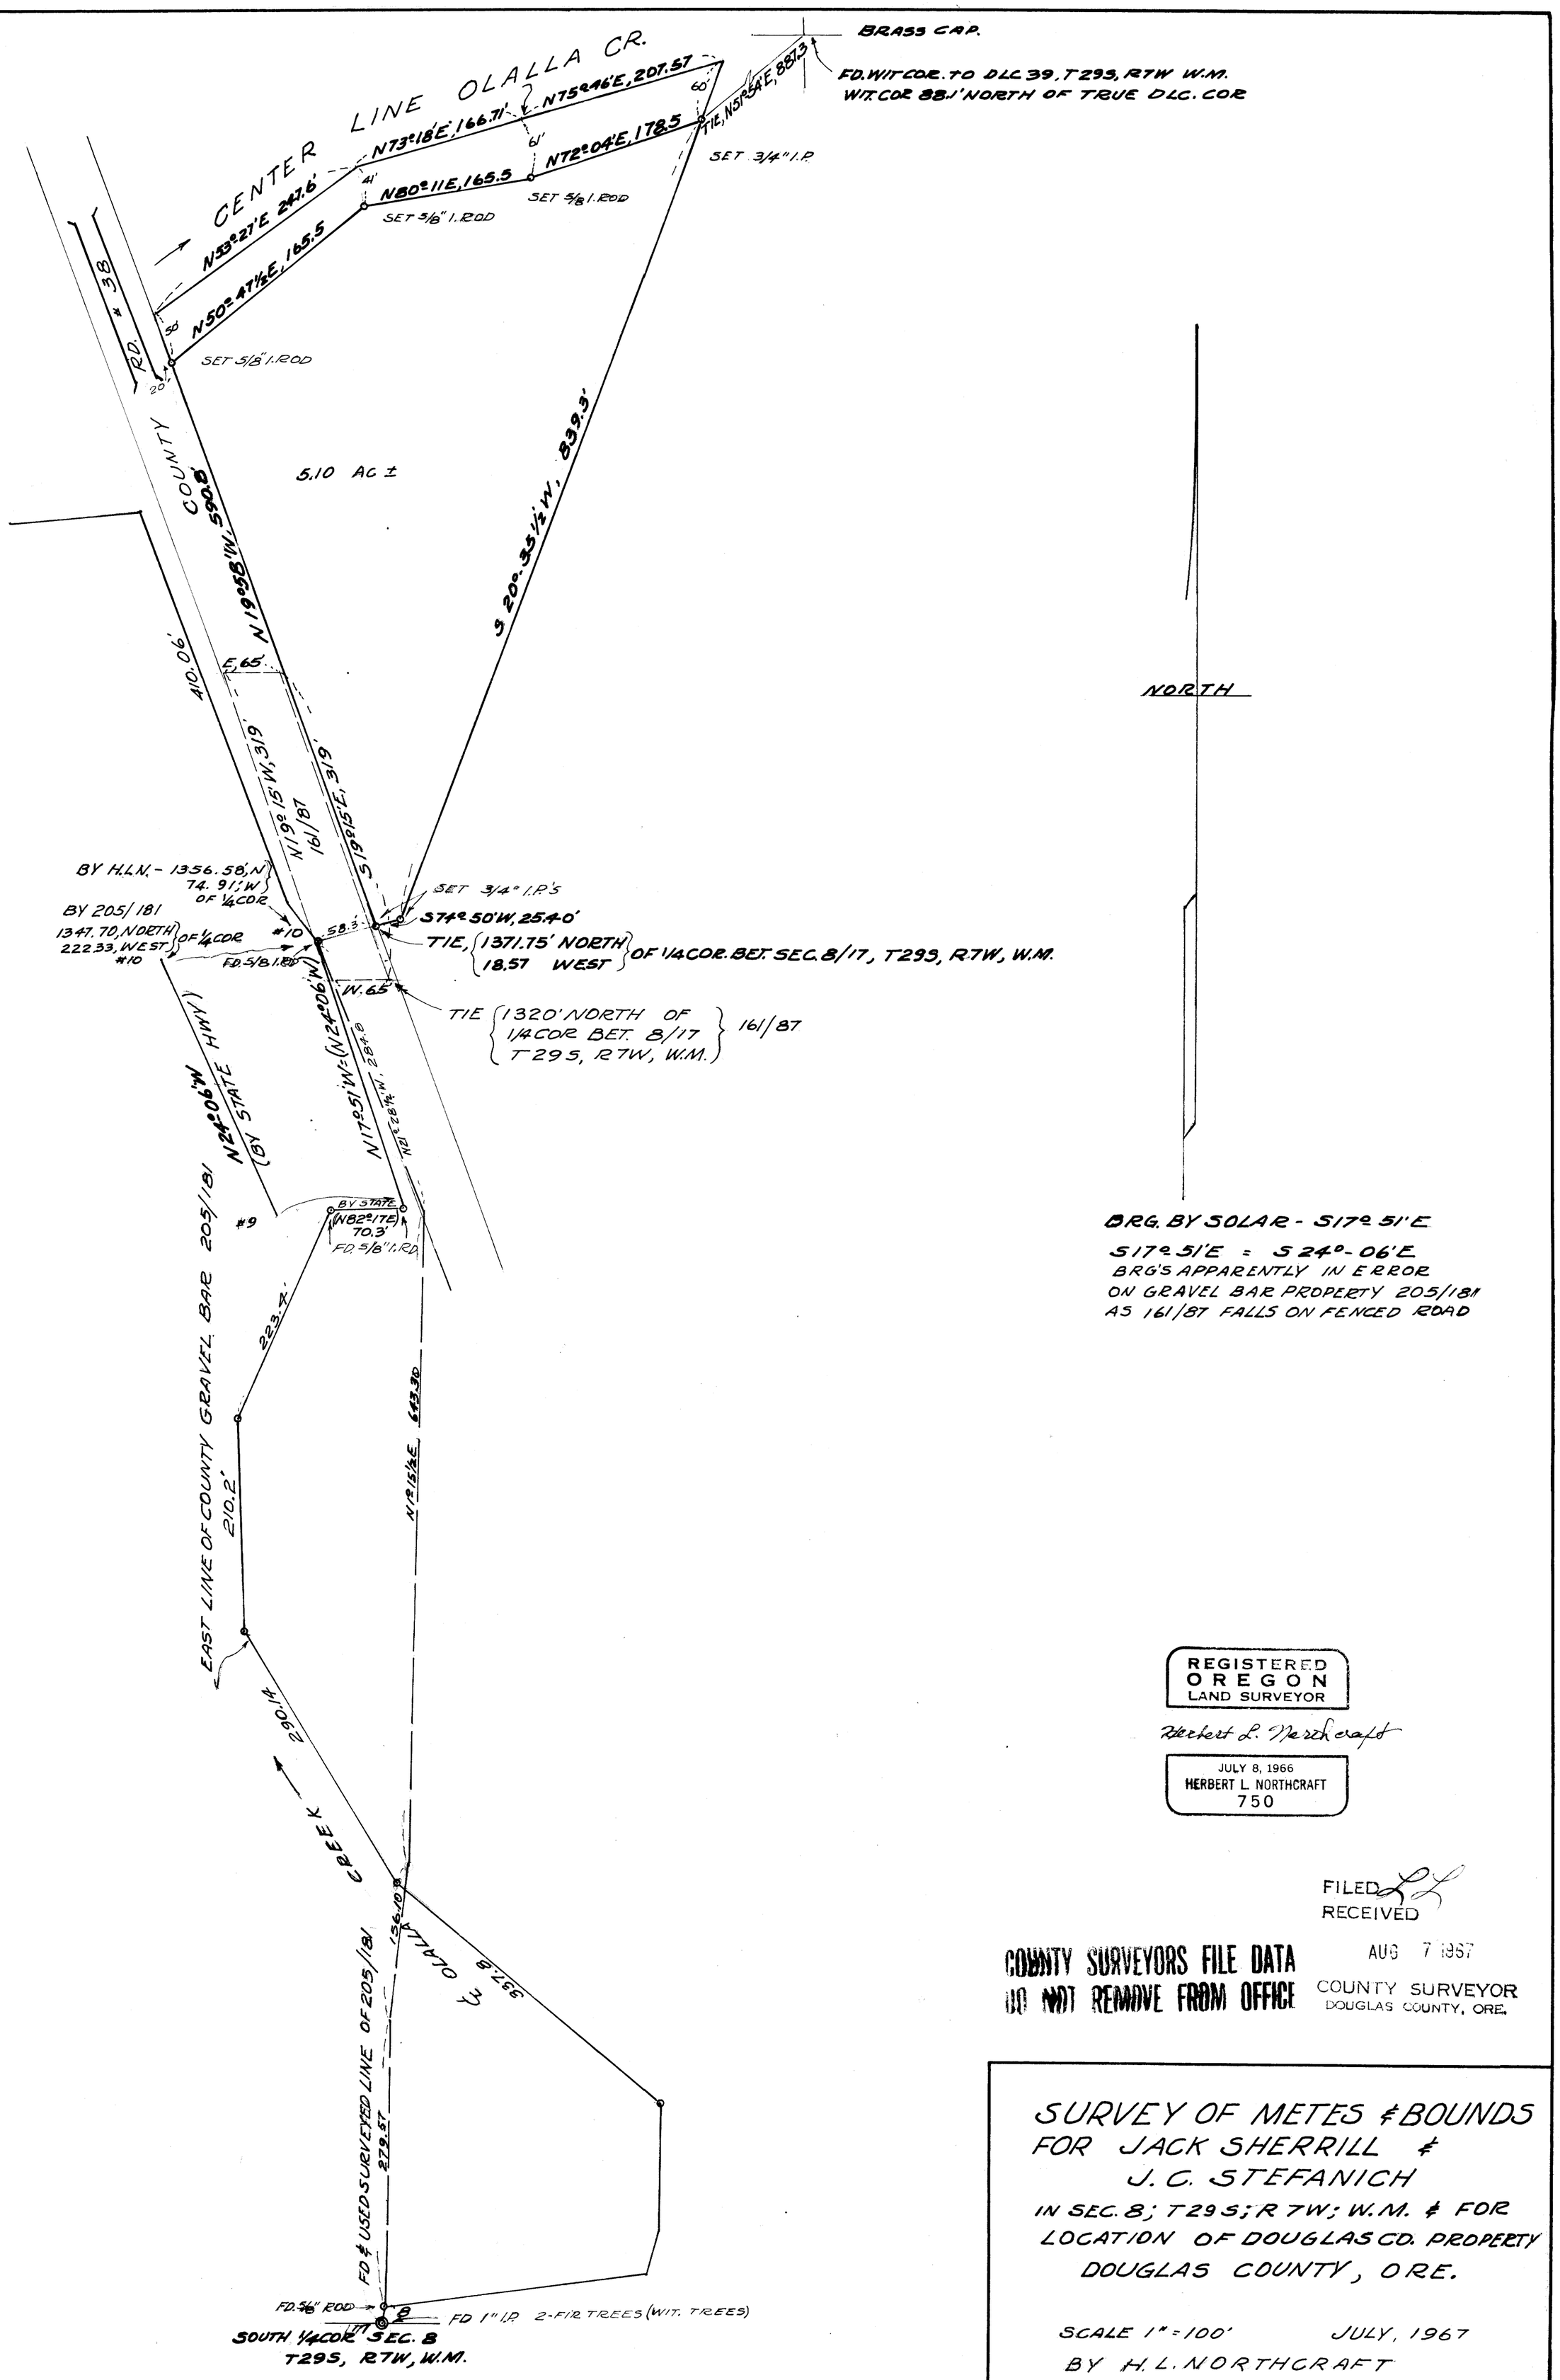

REGISTERED
OREGON
LAND SURVEYOR

Herbert L. Northcraft

JULY 8, 1966
HERBERT L. NORTHCRAFT
750

FILED
RECEIVED
AUG 7 1967
COUNTY SURVEYOR
DOUGLAS COUNTY, ORE.

COUNTY SURVEYORS FILE DATA
DO NOT REMOVE FROM OFFICE

SURVEY OF METES & BOUNDS
FOR JACK SHERRILL &
J. C. STEFANICH
IN SEC. 8; T29S; R7W; W.M. & FOR
LOCATION OF DOUGLAS CO. PROPERTY
DOUGLAS COUNTY, ORE.

SCALE 1" = 100' JULY, 1967
BY H. L. NORTHCRAFT

MAP FILE M34 # 36