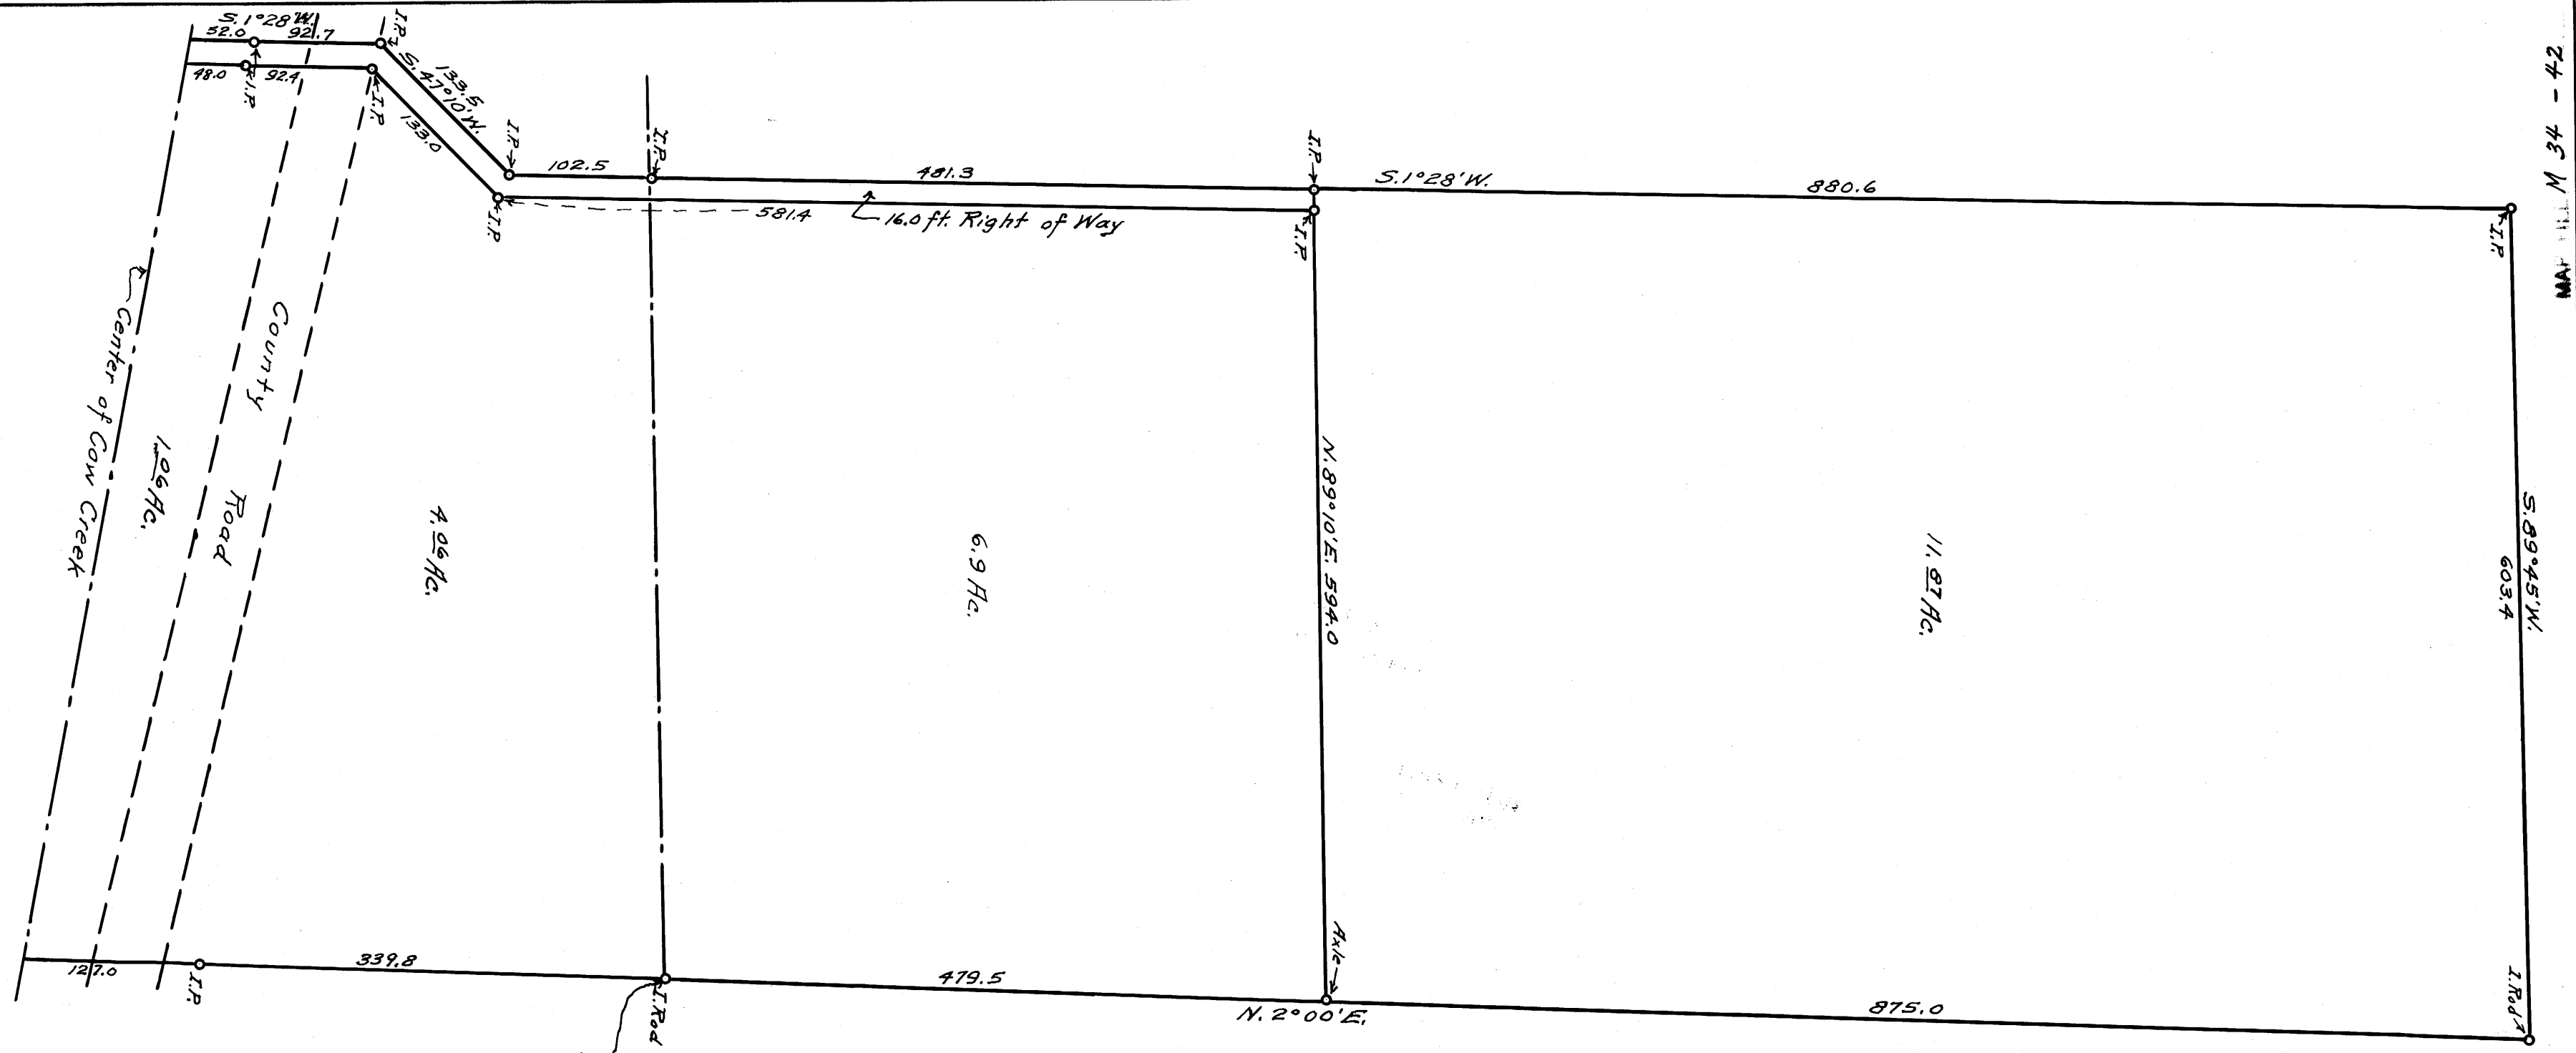

COUNTY SURVEYOR'S OFFICE
DOUGLAS COUNTY, OREGON.
SURVEY FOR
LEONARD SELL IN
SECTION 5, T. 32 S., R. 4 W., W.M.
GEO. J. WENDEROTH, DEPUTY. AUGUST 1967.
Scale 1"=100ft.

REGISTERED
OREGON
LAND SURVEYOR
Geo. J. Wenderoth
MARCH 10, 1944
George J. Wenderoth
5

Var. 20½°

FILED
RECEIVED
AUG 16 1967
COUNTY SURVEYOR
DOUGLAS COUNTY, ORE.

MAP M 34 - 42