COUNTY SURVEYORS FILE DATA
DO NOT REMOVE FROM OFFICE

MAP FILE M34 # 43

SURVEY FOR DEED DESCRIPTION
METES & BOUNDS PARCEL IN SEC. 34, T. 27S, R. 7W, W.M.
SURVEYED FOR CHARLES SCHULZE
by BRUCE ROGERS
AUG. 21, 1967
1" = 40'

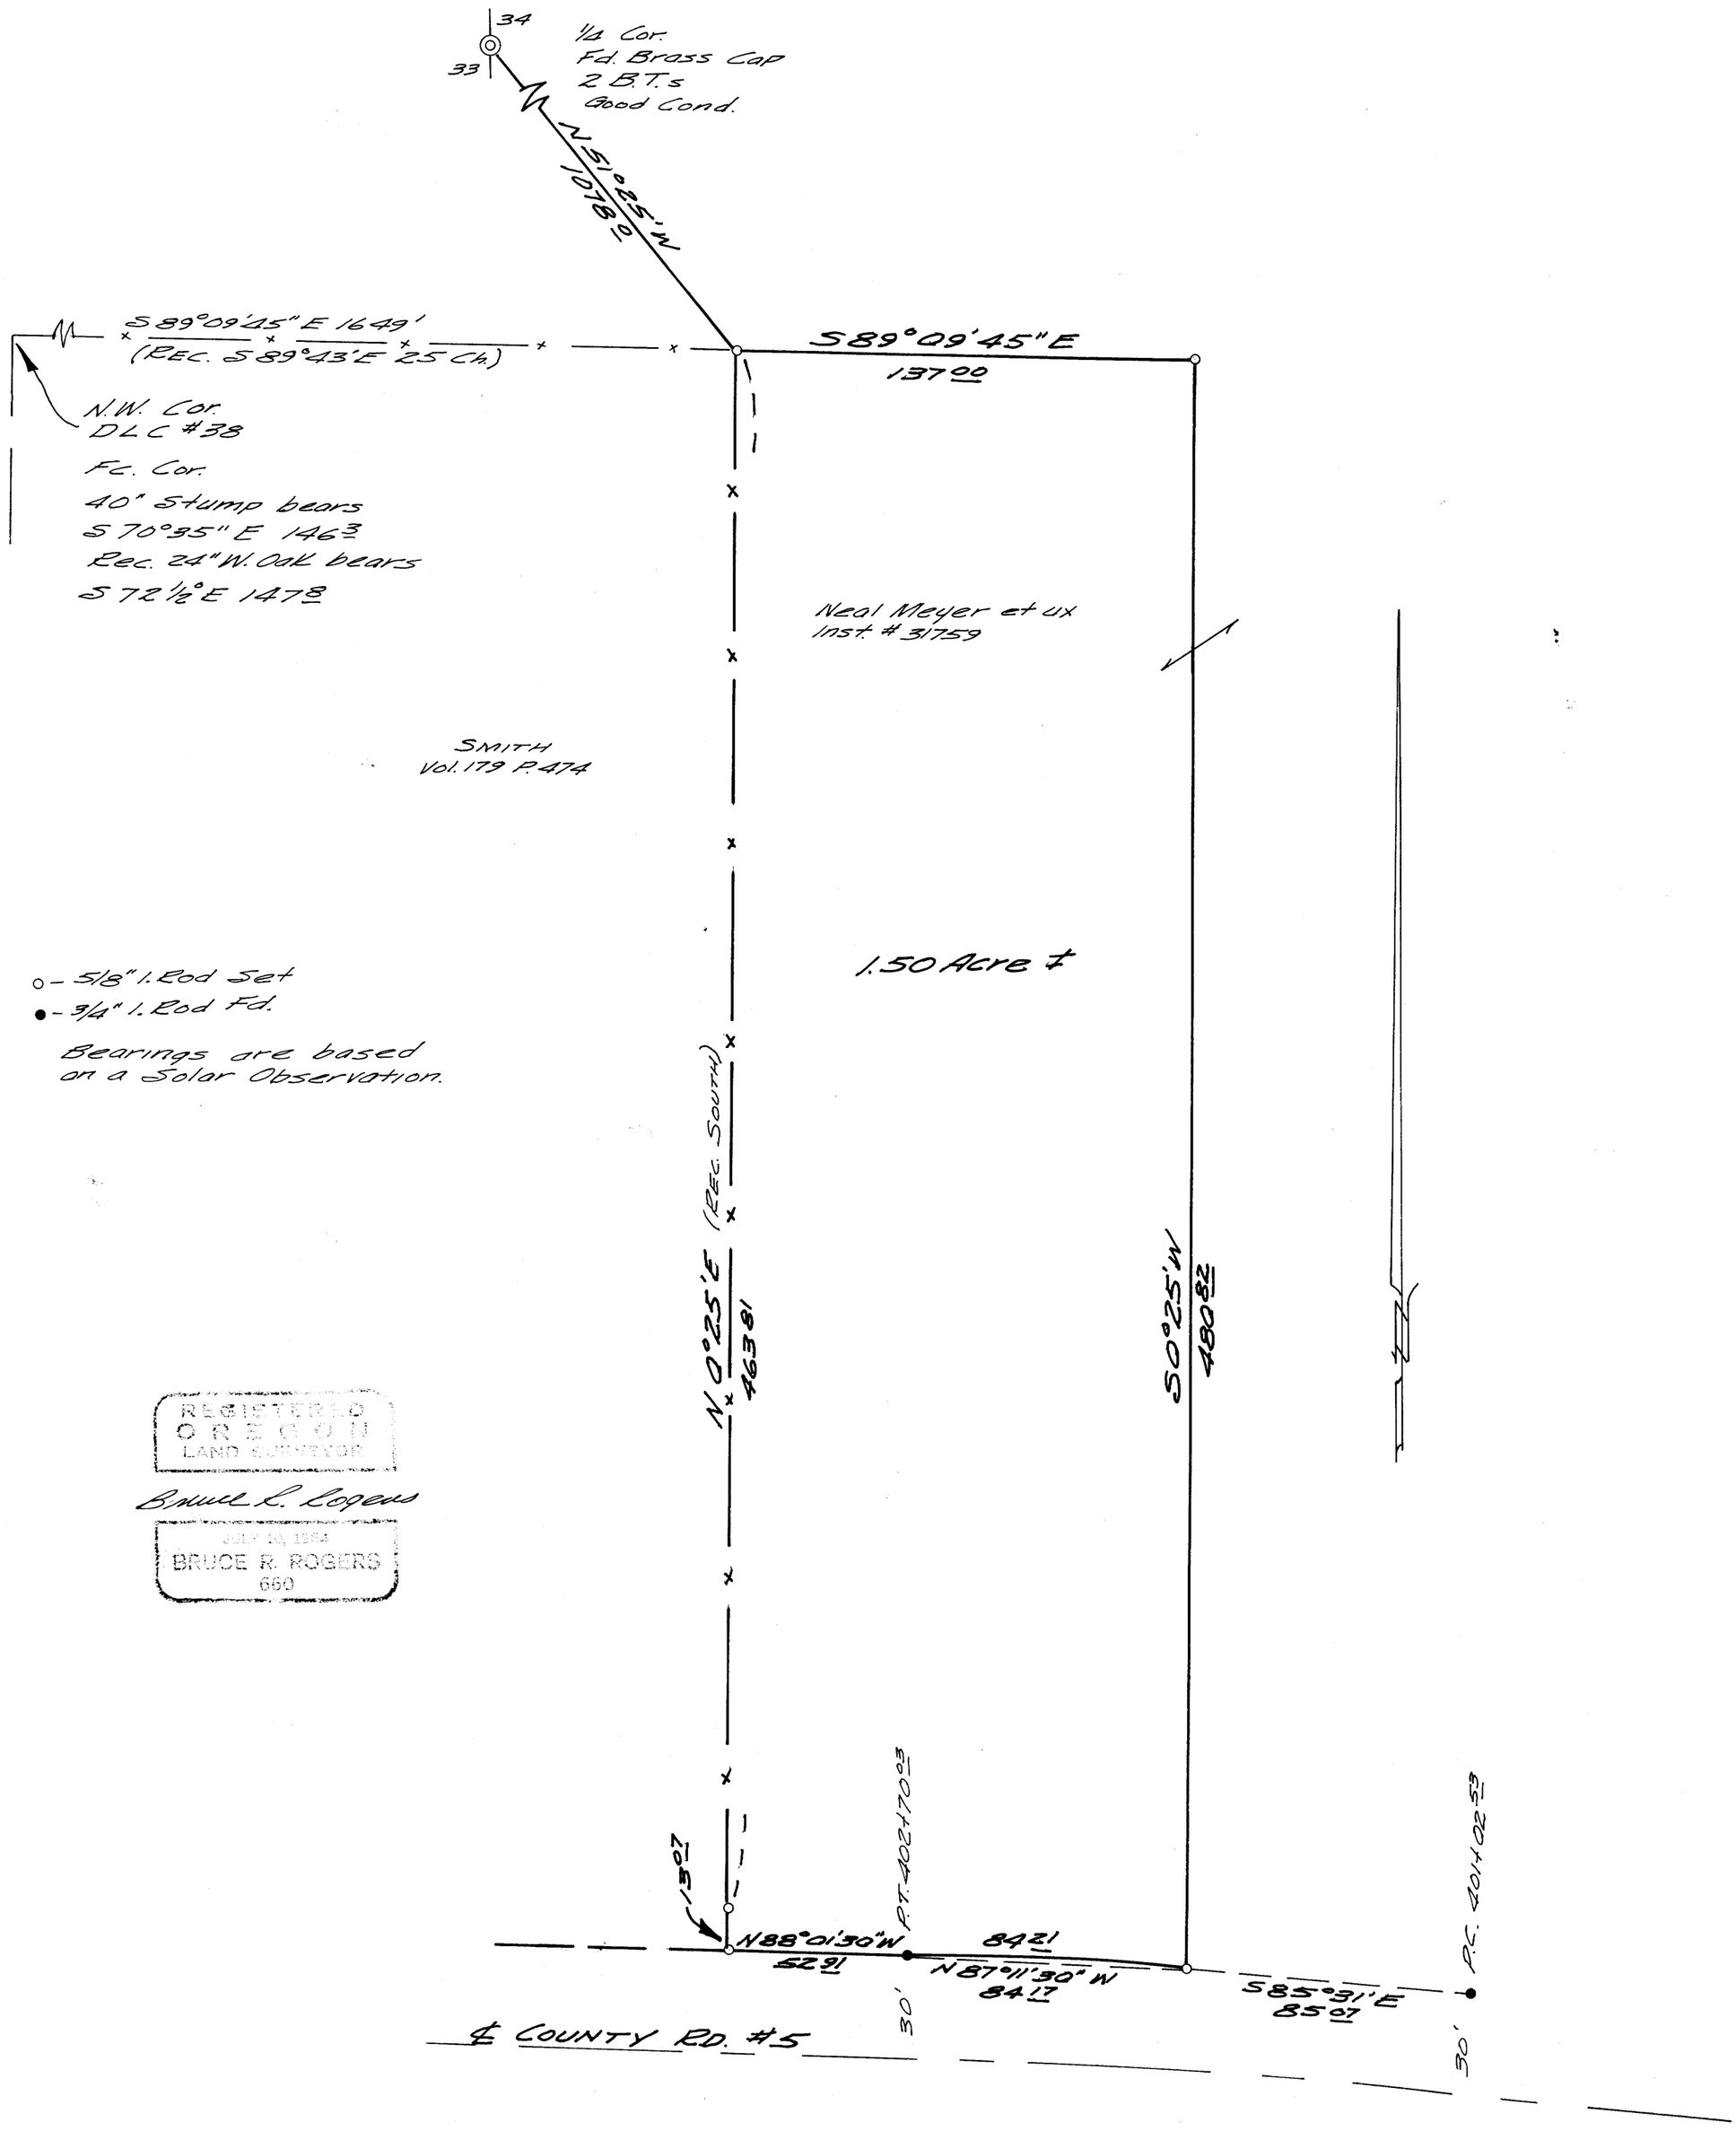

FILED
RECEIVED
AUG 23 1967
COUNTY SURVEYOR
DOUGLAS COUNTY, ORE.

MAP FILE M34 # 43