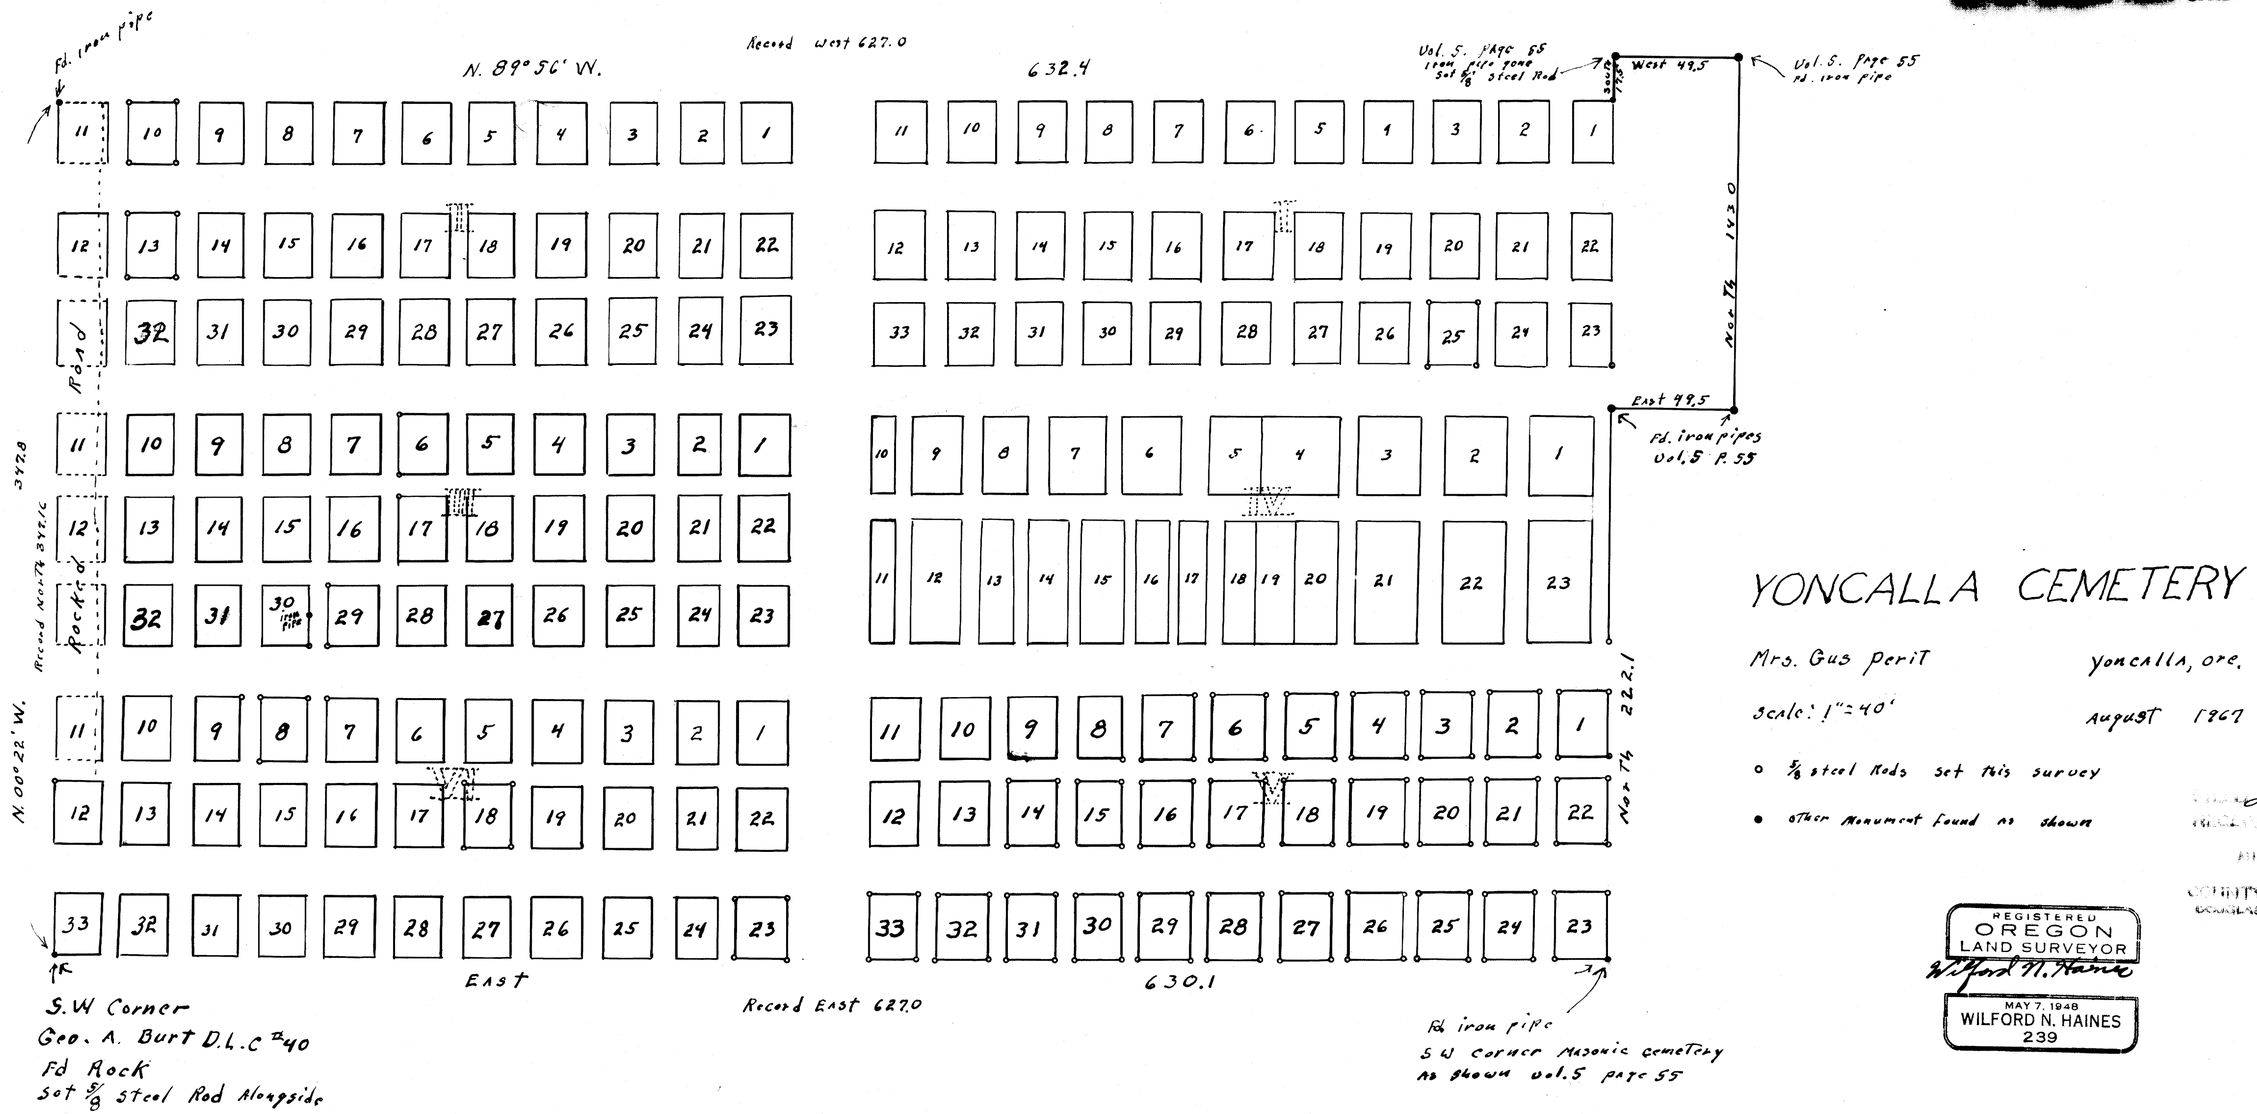

YONCALLA CEMETERY

Mrs. Gus Perit

Yoncalla, Ore.

Scale: 1" = 40'

August 1967

○ 5/8 steel Rods set this survey

● other Monument found as shown

RECEIVED
AUG 22 1967
COUNTY SURVEYOR
DOUGLAS COUNTY, ORE.

REGISTERED
OREGON
LAND SURVEYOR
Wilford N. Haines
MAY 7, 1948
WILFORD N. HAINES
239

M34 p 46

M34 - 46