MAP FILE M34 #60

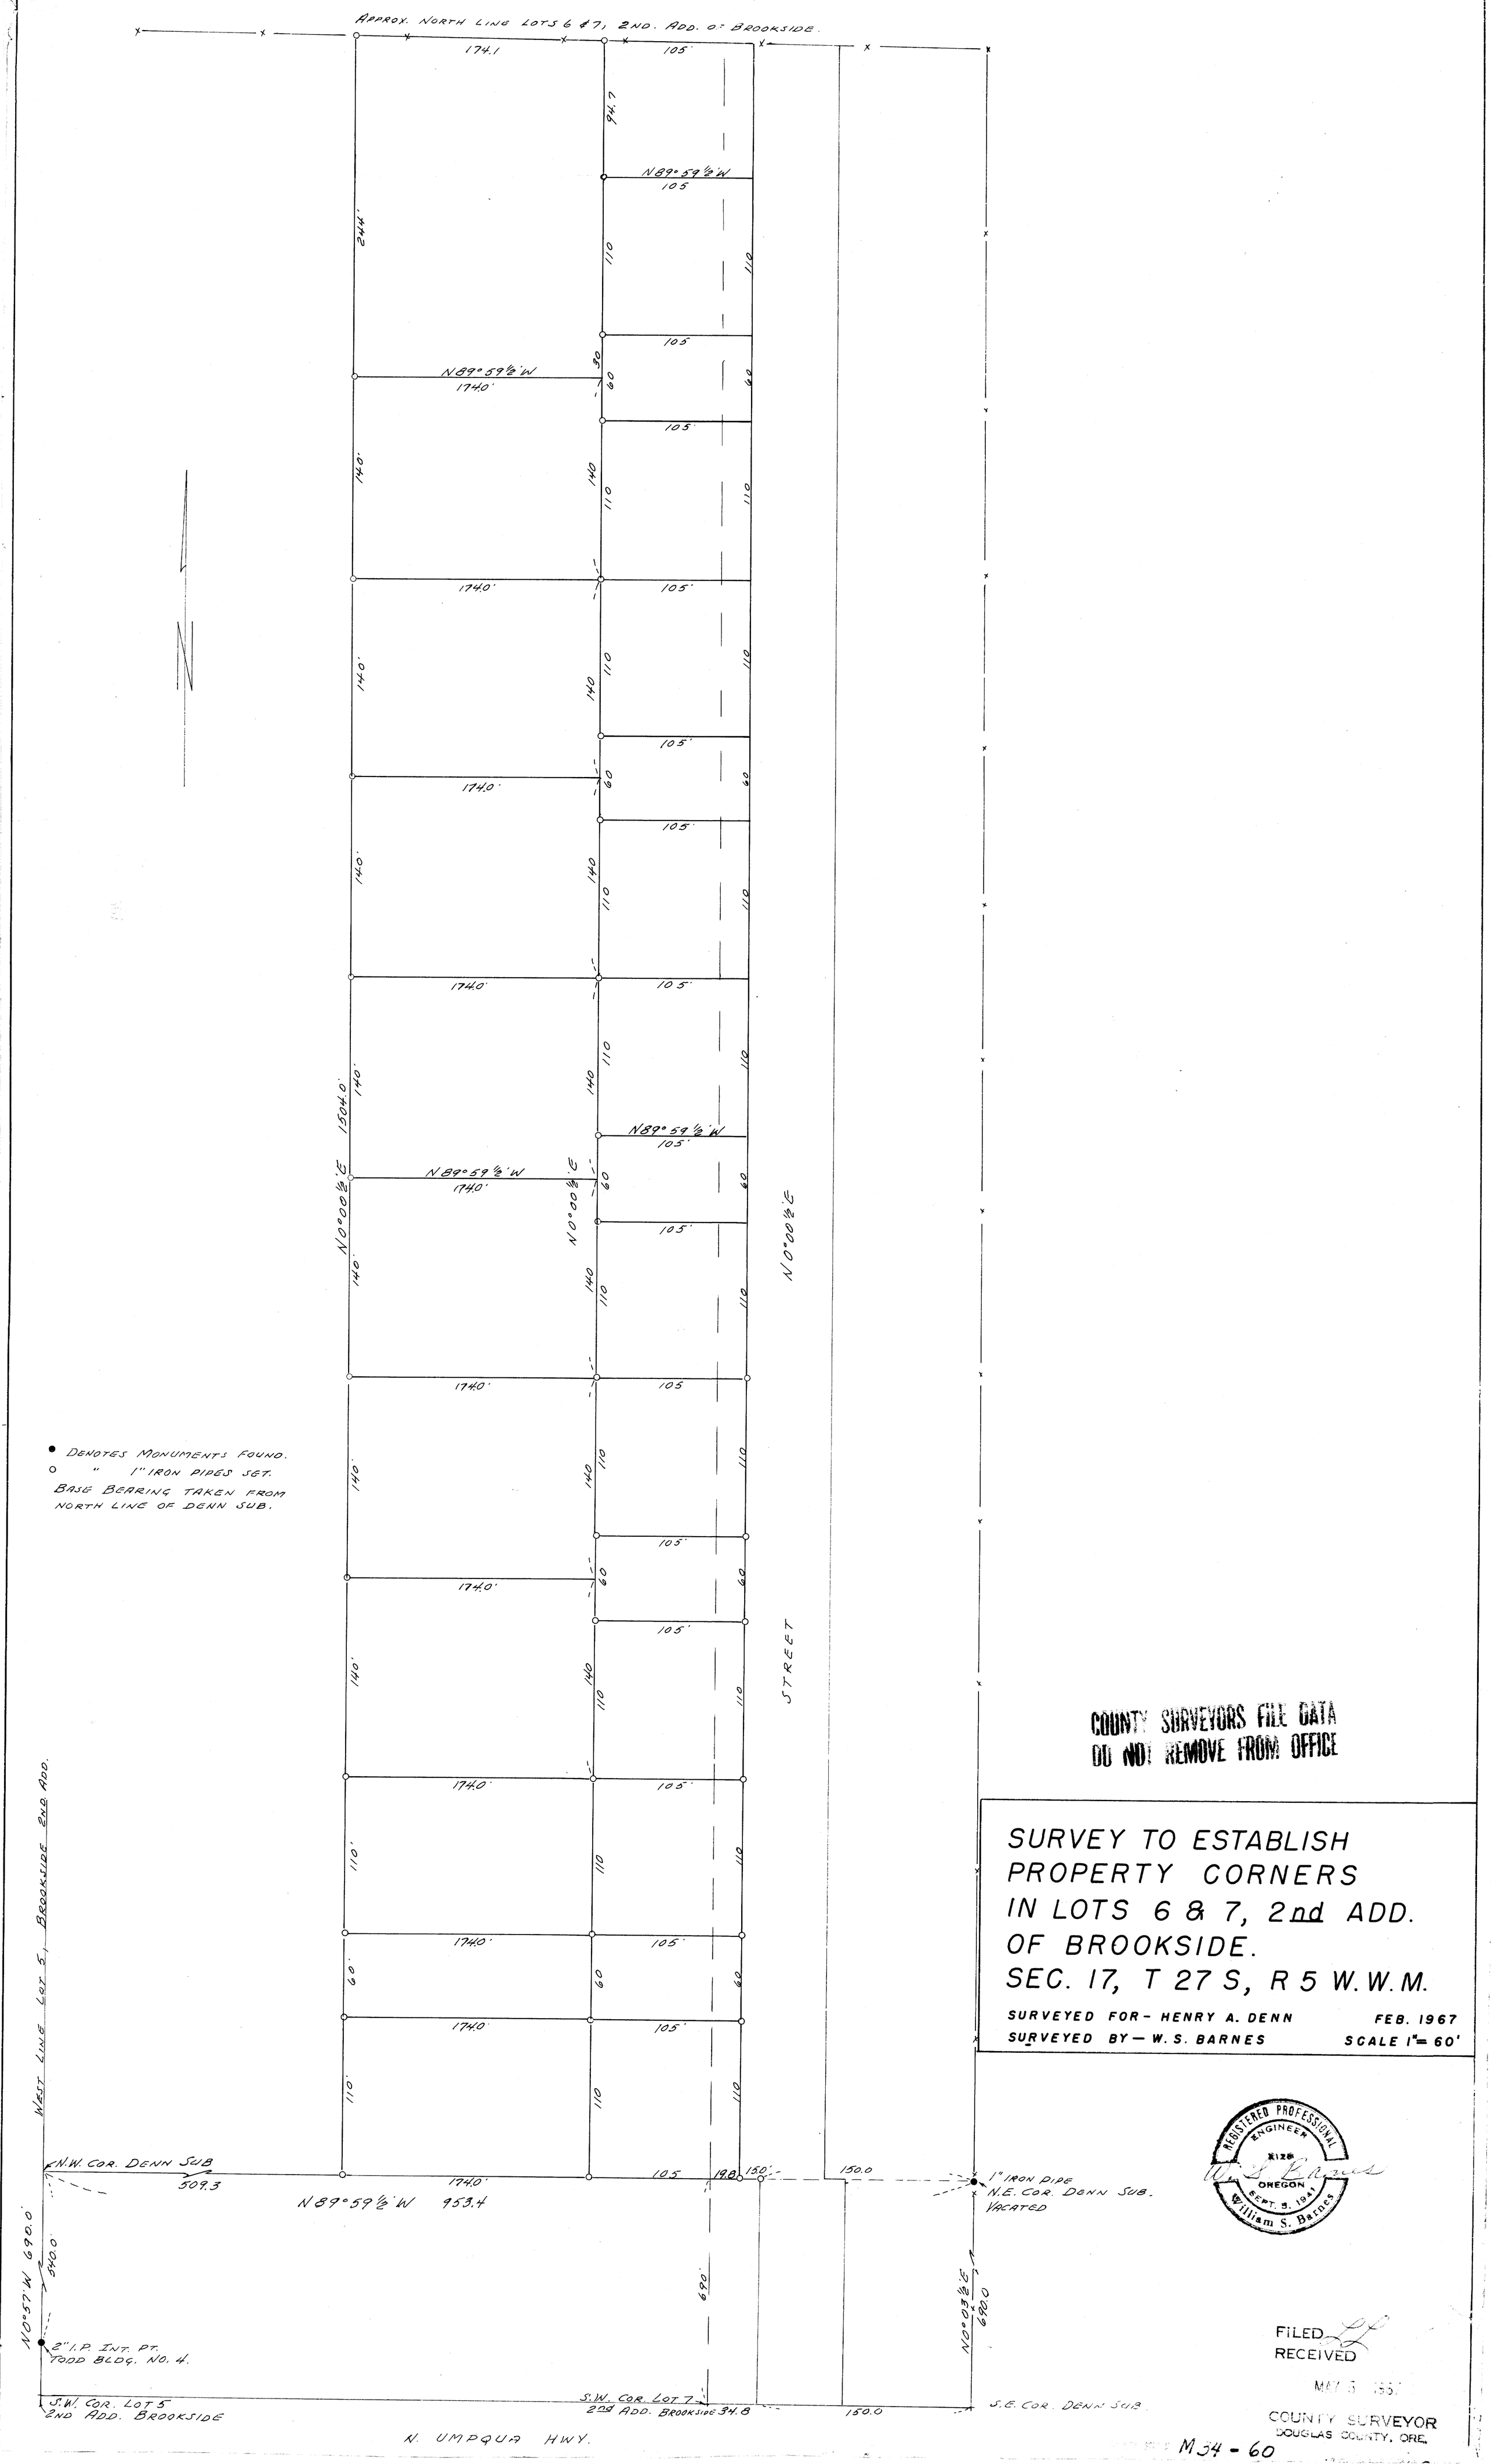


• DENOTES MONUMENTS FOUND.
○ " 1" IRON PIPES SET.
BASE BEARING TAKEN FROM NORTH LINE OF DENN SUB.

COUNTY SURVEYORS FILE DATA
DO NOT REMOVE FROM OFFICE

# SURVEY TO ESTABLISH PROPERTY CORNERS IN LOTS 6 & 7, 2nd ADD. OF BROOKSIDE. SEC. 17, T 27 S, R 5 W.W.M.

SURVEYED FOR - HENRY A. DENN — FEB. 1967
SURVEYED BY — W. S. BARNES — SCALE 1" = 60'

REGISTERED PROFESSIONAL ENGINEER 2126 OREGON SEPT. 9, 1941 William S. Barnes

FILED
RECEIVED
MAY 5 1967
COUNTY SURVEYOR
DOUGLAS COUNTY, ORE.

M34 - 60