M 34-65

LEGEND

- ∘ TACK SET
- ⊙ 1/2" IRON ROD SET
- • MONUMENT FOUND SIZE AS NOTED

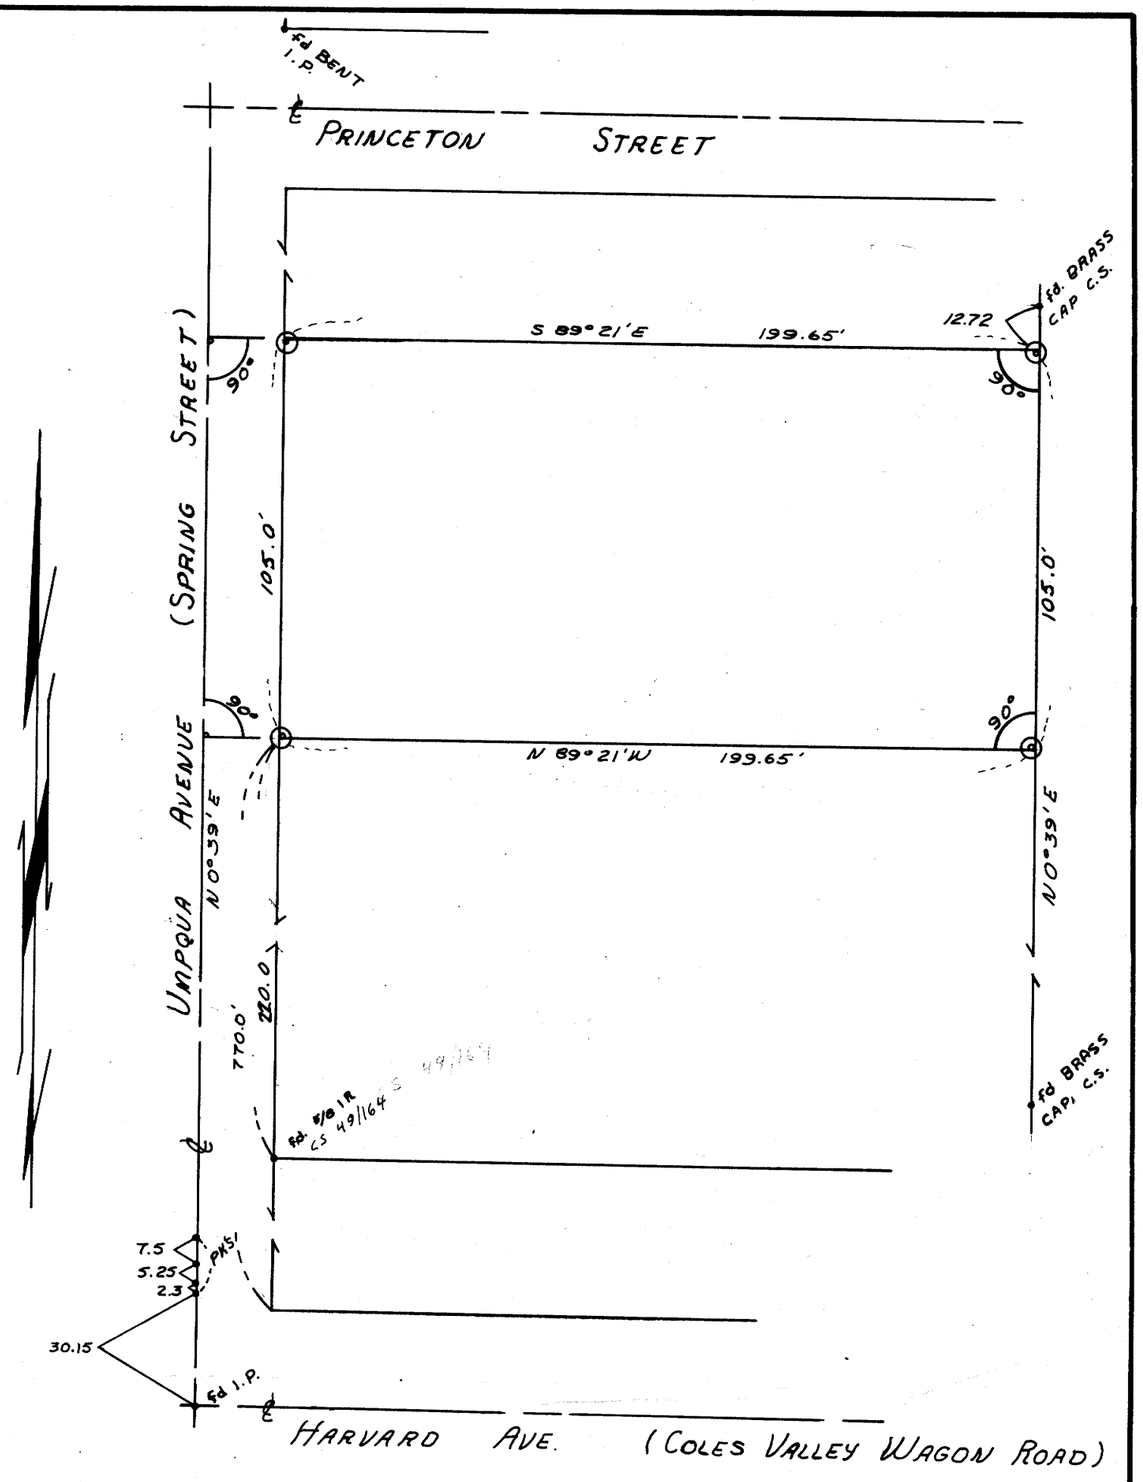

FILED
RECEIVED
OCT 23 1967
COUNTY SURVEYOR
DOUGLAS COUNTY, ORE.

COUNTY SURVEYORS FILE DATA
DO NOT REMOVE FROM OFFICE

NOTE:
BEARINGS BASED ON N 0°39'E ALONG UMPQUA AVENUE C.S. FILE 49/164

QUINER & BRITTON-CONSULTING ENGINEERS
751 WEST 12TH AVE
EUGENE, OREGON

PROJECT	PROPERTY SURVEY
FOR	DR. ARCH COLBRUNN
LOCATION	SECTION 13, TOWNSHIP 27 SOUTH, RANGE 6 WEST W.M. DOUGLAS COUNTY, OREGON
DATE :	9/22/67
SCALE :	1" = 40'
BY :	MTC FB 27-63

REGISTERED PROFESSIONAL ENGINEER 4868 James E. Britton OREGON JULY 9, 1962 JAMES E. BRITTON

MAP FILE M34-65