MAP FILE M35 - 30

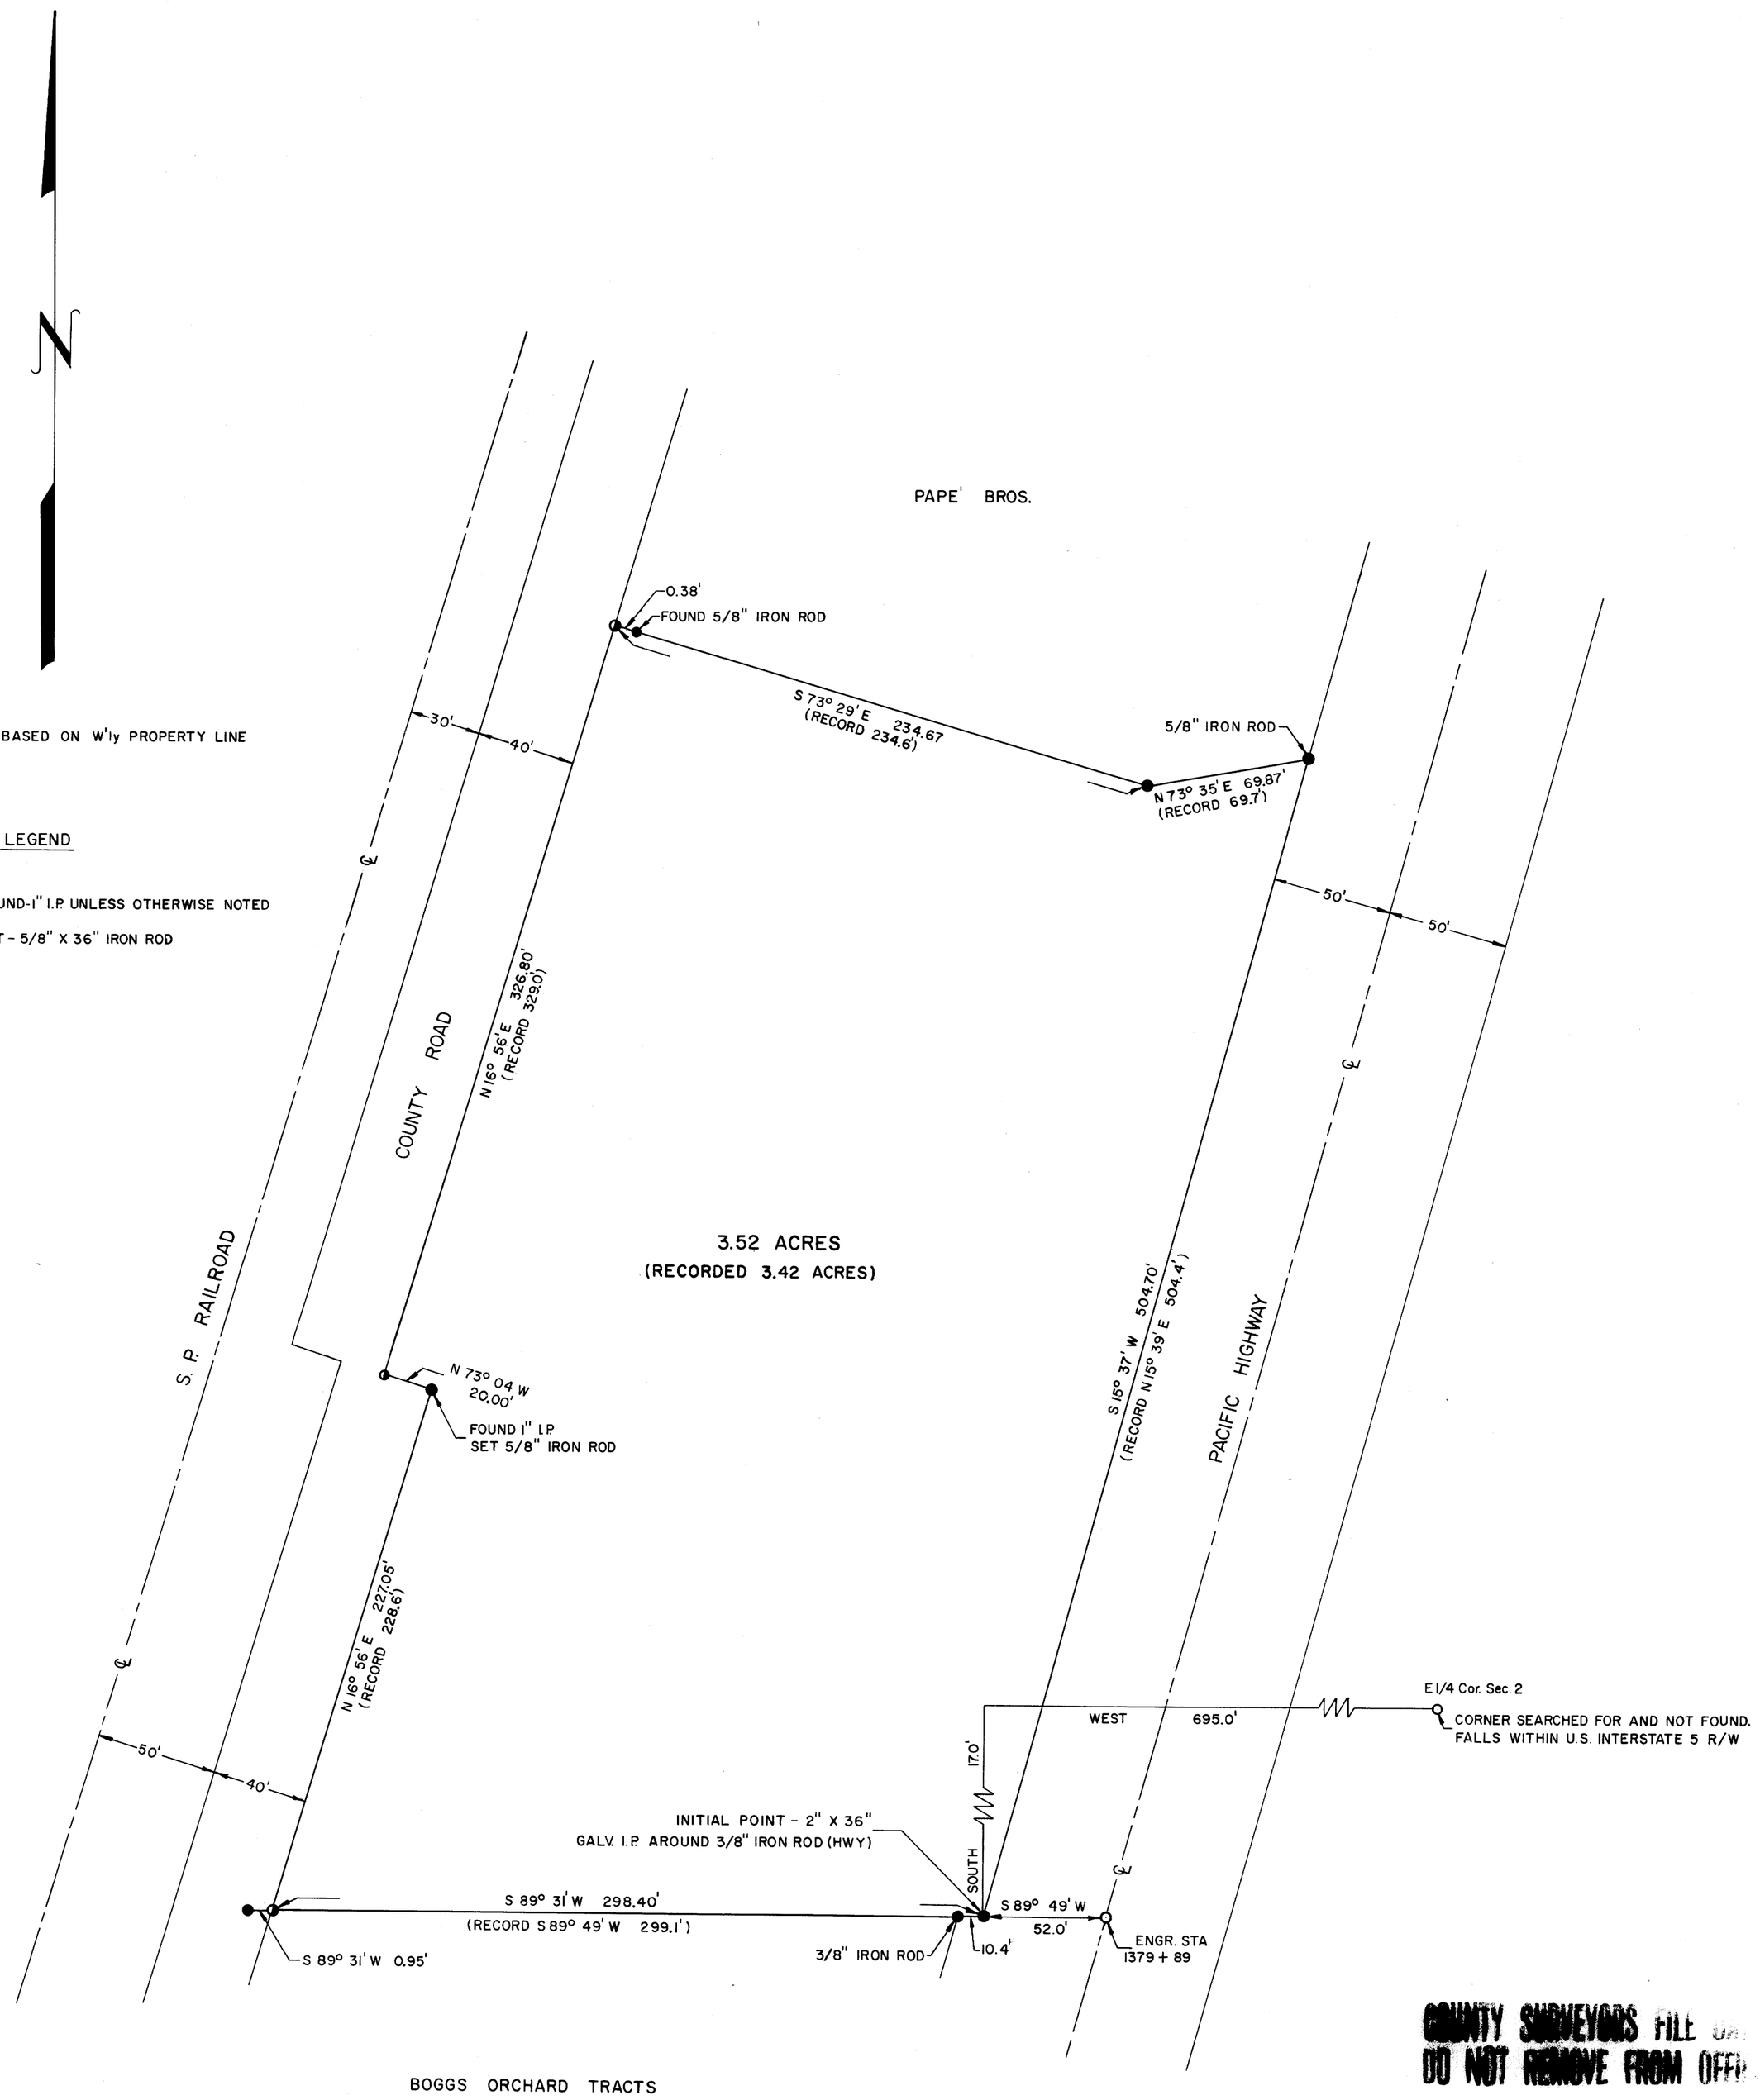

COUNTY SURVEYORS FILE
DO NOT REMOVE FROM OFFI

PROPERTY LINE SURVEY
FOR C. M. Mc DERMOTT

IN THE SE 1/4 NE 1/4 OF Sec. 2,
T28S, R6W, W.M.

JANUARY 26, 1968

BRUCE A. SHANER, ENGINEER

Bruce A Shaner

MAP FILE M35 - 30