FILED
RECEIVED
MAR 18 1968
COUNTY SURVEYOR
DOUGLAS COUNTY, ORE.

COUNTY SURVEYORS FILE DATA
DO NOT REMOVE FROM OFFICE

S. 12, T.22S., R.7W. + S 7, T22S., R6W. W.M.

SURVEY FOR DEED DESCRIPTION

Donald Davis EIKTON, Oregon

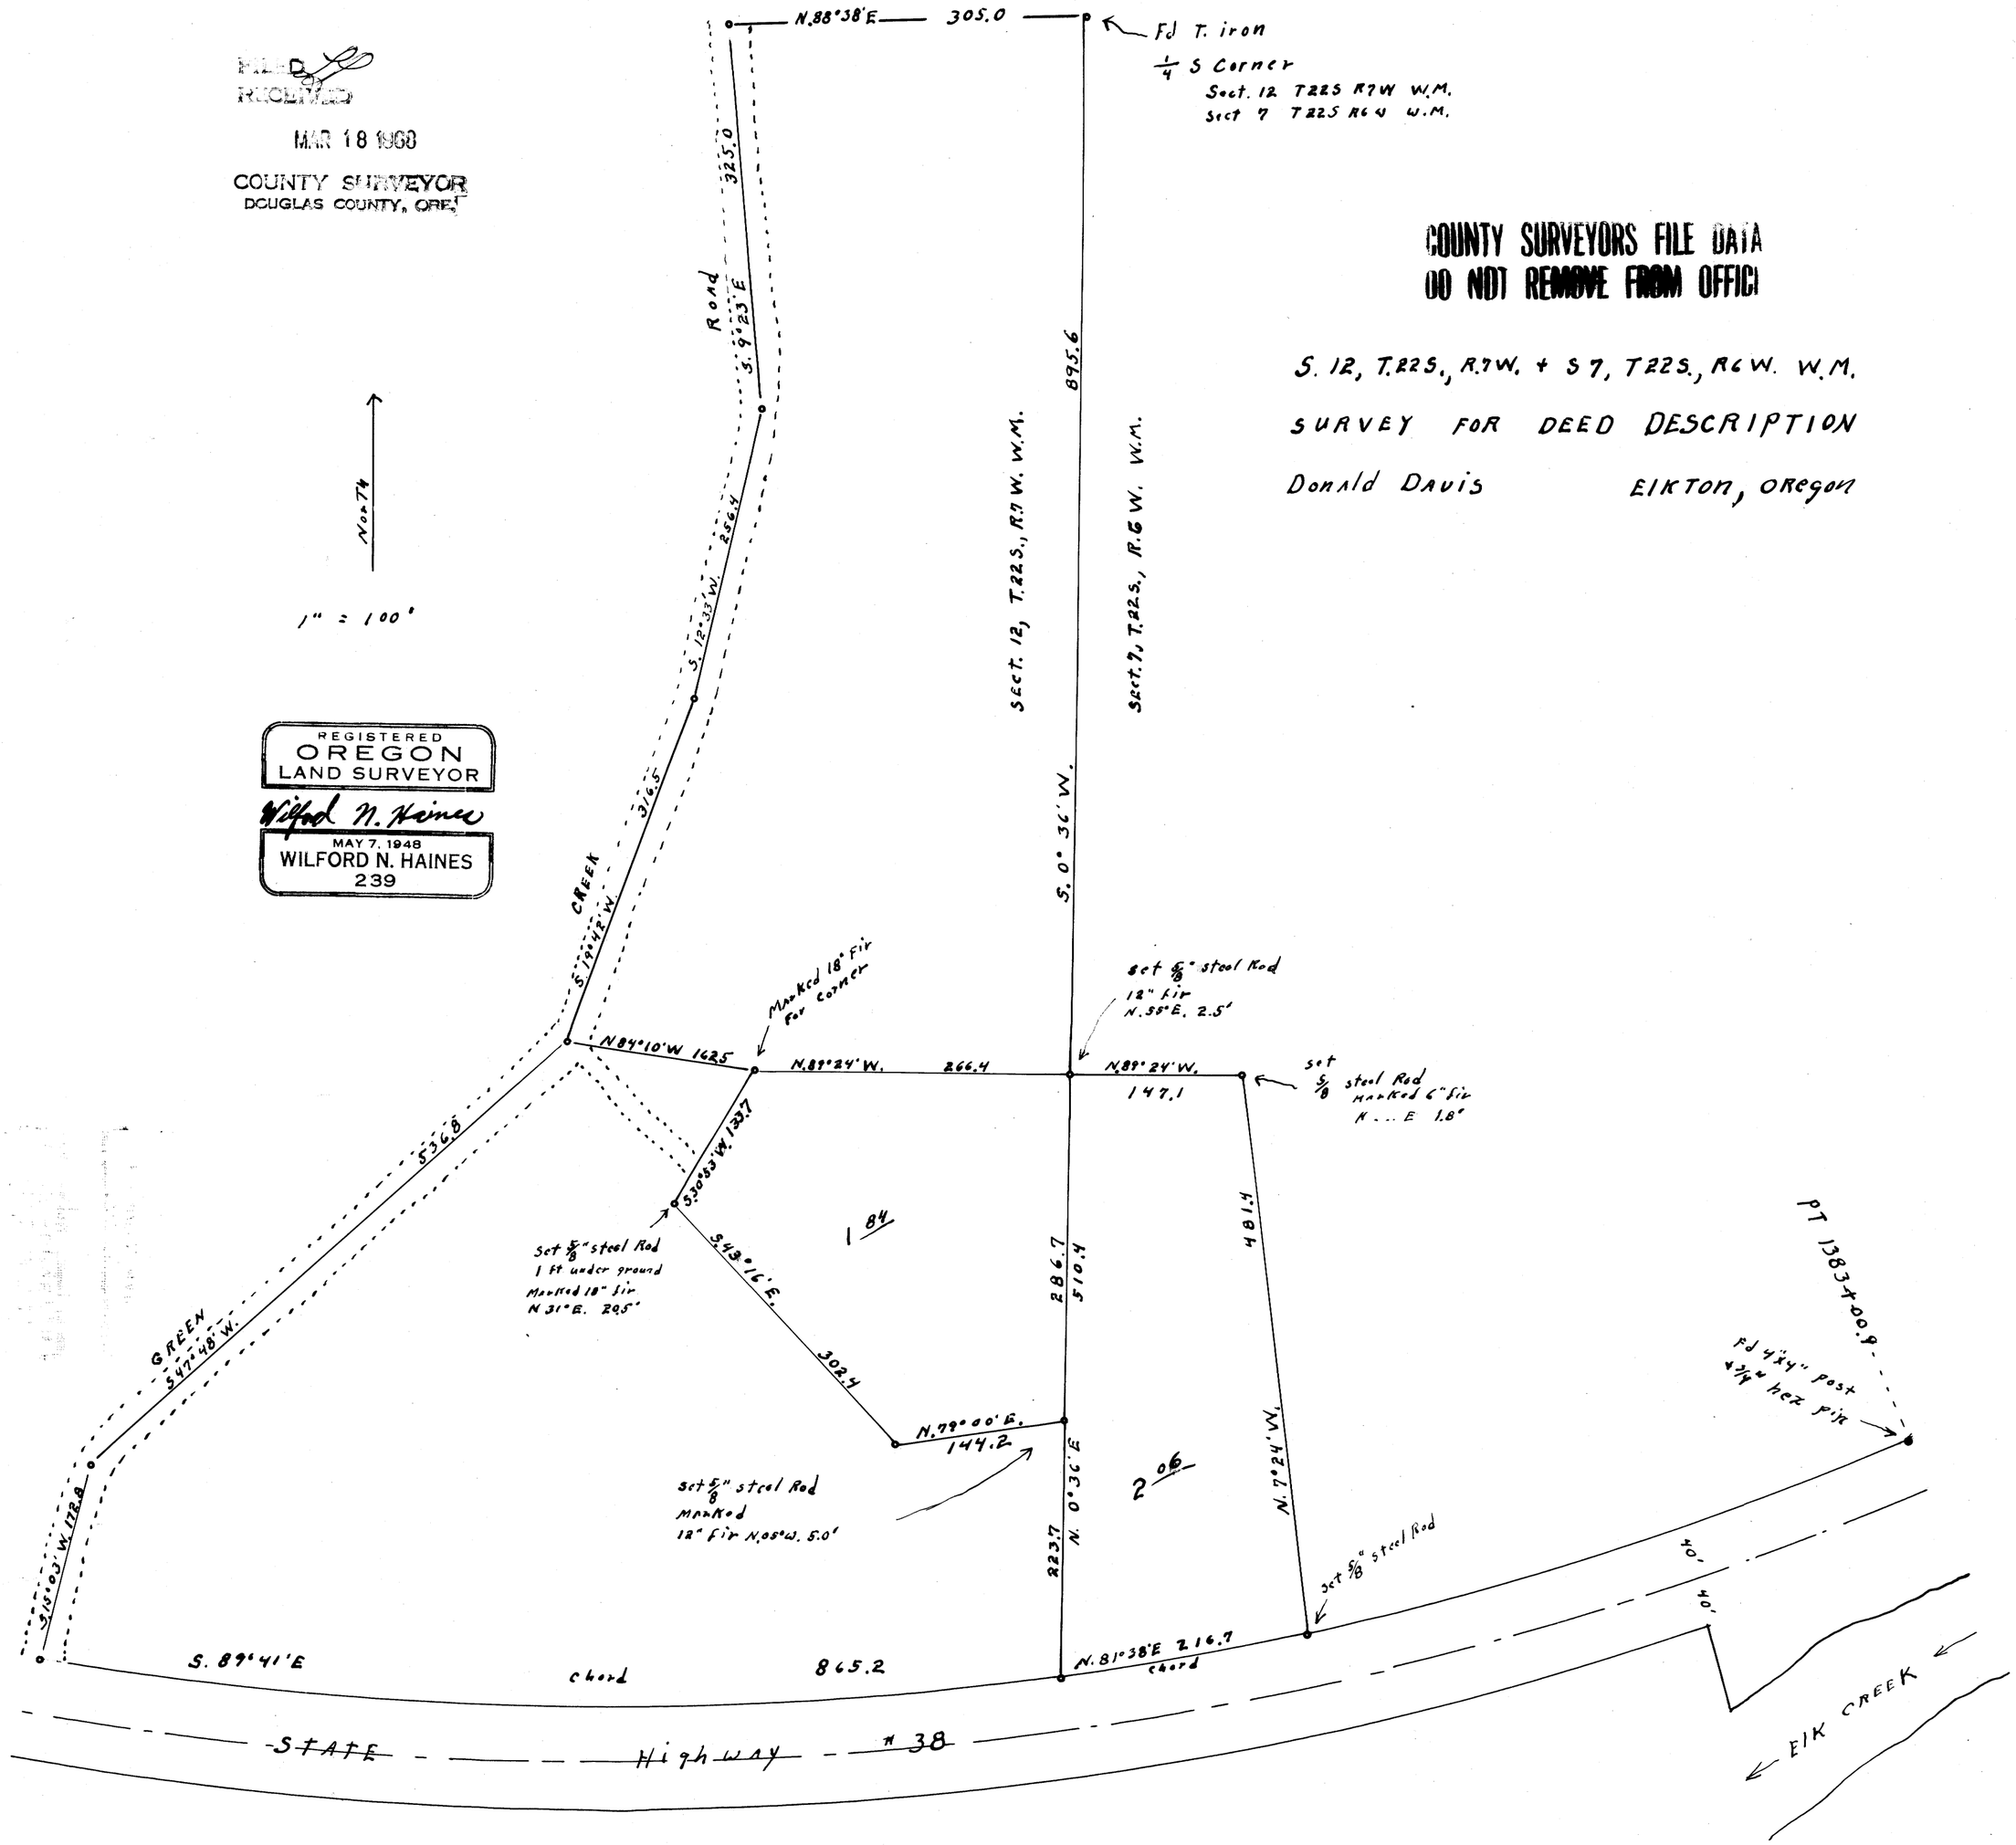


REGISTERED
OREGON
LAND SURVEYOR
Wilford N. Haines
MAY 7, 1948
WILFORD N. HAINES
239

MAP FILE M-35 P-53

MAP FILE M-35 P-53