SECTION COR. RESTORATION & SUB. SEC.
IN SEC. 1,2,3,10,11,12,13,14 & 15, T.27S. R.5W. W.M.
FOR 4 STAR LAND & DEVELOPMENT COMPANY
BY BAUGHMAN & ACKARET INC. 12-30-67

LEGEND

COUNTY SURVEYORS FILE DA:
DO NOT REMOVE FROM OFFIC!

REGISTERED LAND SURVEYOR GLENN A. BAUGHMAN 836

Glenn A. Baughman

SCALE 1" = 1,000'
BASE OF BEARING, SOLAR OBSERVATION
● SET BRASS CAP & STAMPED PER. O.R.S.

NO. *B.T. 12" MADRONA BEARS S34°W. 18.5' & 6" OAK BEARS N.75°W. 17.6'; SCRIBED 1/4 COR. 9 & 10, T.27S. R.5W.
*NO. 2: B.T. 24" OAK BEARS S.59°30'E. 16.8'; 34" OAK BEARS S.43°30'E. 40.9'; 22" OAK BEARS S.39°W. 51.8' & 14" FIR BEARS N.43°W. 31.2'; SCRIBED SEC. COR. 10, 11, 14 & 15, T.27S., R.5W.
*NO. 3: B.T. 10" OAK BEARS N.[illegible] & 6" MADRONA BEARS N.22°W. 34.7'; SCRIBED 1/4 COR. SEC. 10 & 11, T.27S. R.5W.
*NO. 4: SET 1" x 30" IRON RODS, BEARS N.27°W. 70.17'; BEARS N.52°E. 77.09'; BEARS S.27°W. 68.77' & BEARS S.53°W. 70.82'; W. BY DISTANCE TO SECTION COR. 2 & 3, T.27S., R.5W. W.M. & SEC. 34 & 35, T.26S., R.5W. W.M.
*NO. 5: B.T. 8" MADRONA BEARS N.69°W. 00.1'; 6" OAK BEARS S.50°W. 134.4'; SCRIBED W. 1/16 COR. SEC. 11 & 14
*NO. 6: B.T. 6" OAK BEARS N.42°W. 20.3' & 10" OAK BEARS S.1°W. 13.0'; SCRIBED C.W. 1/16 COR. SEC. 11
*NO. 7: B.T. 16" ELM BEARS S49°W. 65.9' & 5" OAK BEARS N.5°W. 13.74; SCRIBED 1/4 COR. SECS. 11 & 14, T.27S. R.5W.
*NO. 8: B.T. 20" OAK BEARS S.35°30'W. 62.5' & 12" OAK BEARS S.3°30'E. 108.0'; SCRIBED C. 1/4 COR. SEC. 11
*NO. 9: B.T. 14" OAK BEARS N.59°W. 13.4'; 22" OAK BEARS N.52°E. 43.3'; 12" OAK BEARS S.67°W. 34.0' & 6" OAK BEARS S.71°E. 68.8'; SCRIBED SEC. COR. 2, 3, 10 & 11, T.27S. R.5W.
*NO. 10: B.T. 4" MADRONA BEARS N.20°W. 57.0'; SCRIBED 1/4 COR. SEC. 2, T.27S. R.5W.; SET 1" I.P. BEARS S.14°E. 44.0'
*NO. 11: SET 1" I.P. BEARS S.62°W. 55.0'; SET 1" I.P. BEARS N.54°E. 16.0'; SET 1" I.P. BEARS N.62°W. 44.0'; B.T. 4" MADRONA BEARS S.89°E. 21.6'; SCRIBED SEC. 12, T.27S., R.5W.

* NO. 12: B.T. 6" OAK BEAR S.14°E. 29.0'; SCRIBED SEC. COR. SEC. 7, T.27S., R.4 W.W.M.; SET 1" I.P. BEARS: N.24° W. 32.5'; B.T. 12" OAK BEARS S.33°W. 94.0'; 8" OAK BEARS N.86°W. 73.2'; SCRIBED SEC. COR. 1 & 12, T.27S., R.5 W.W.M.

NOTE: ALL BEARING TREES SCRIBED WITH THE SEC. NO. OF THE SEC. IN WHICH IT FALLS IN ONLY

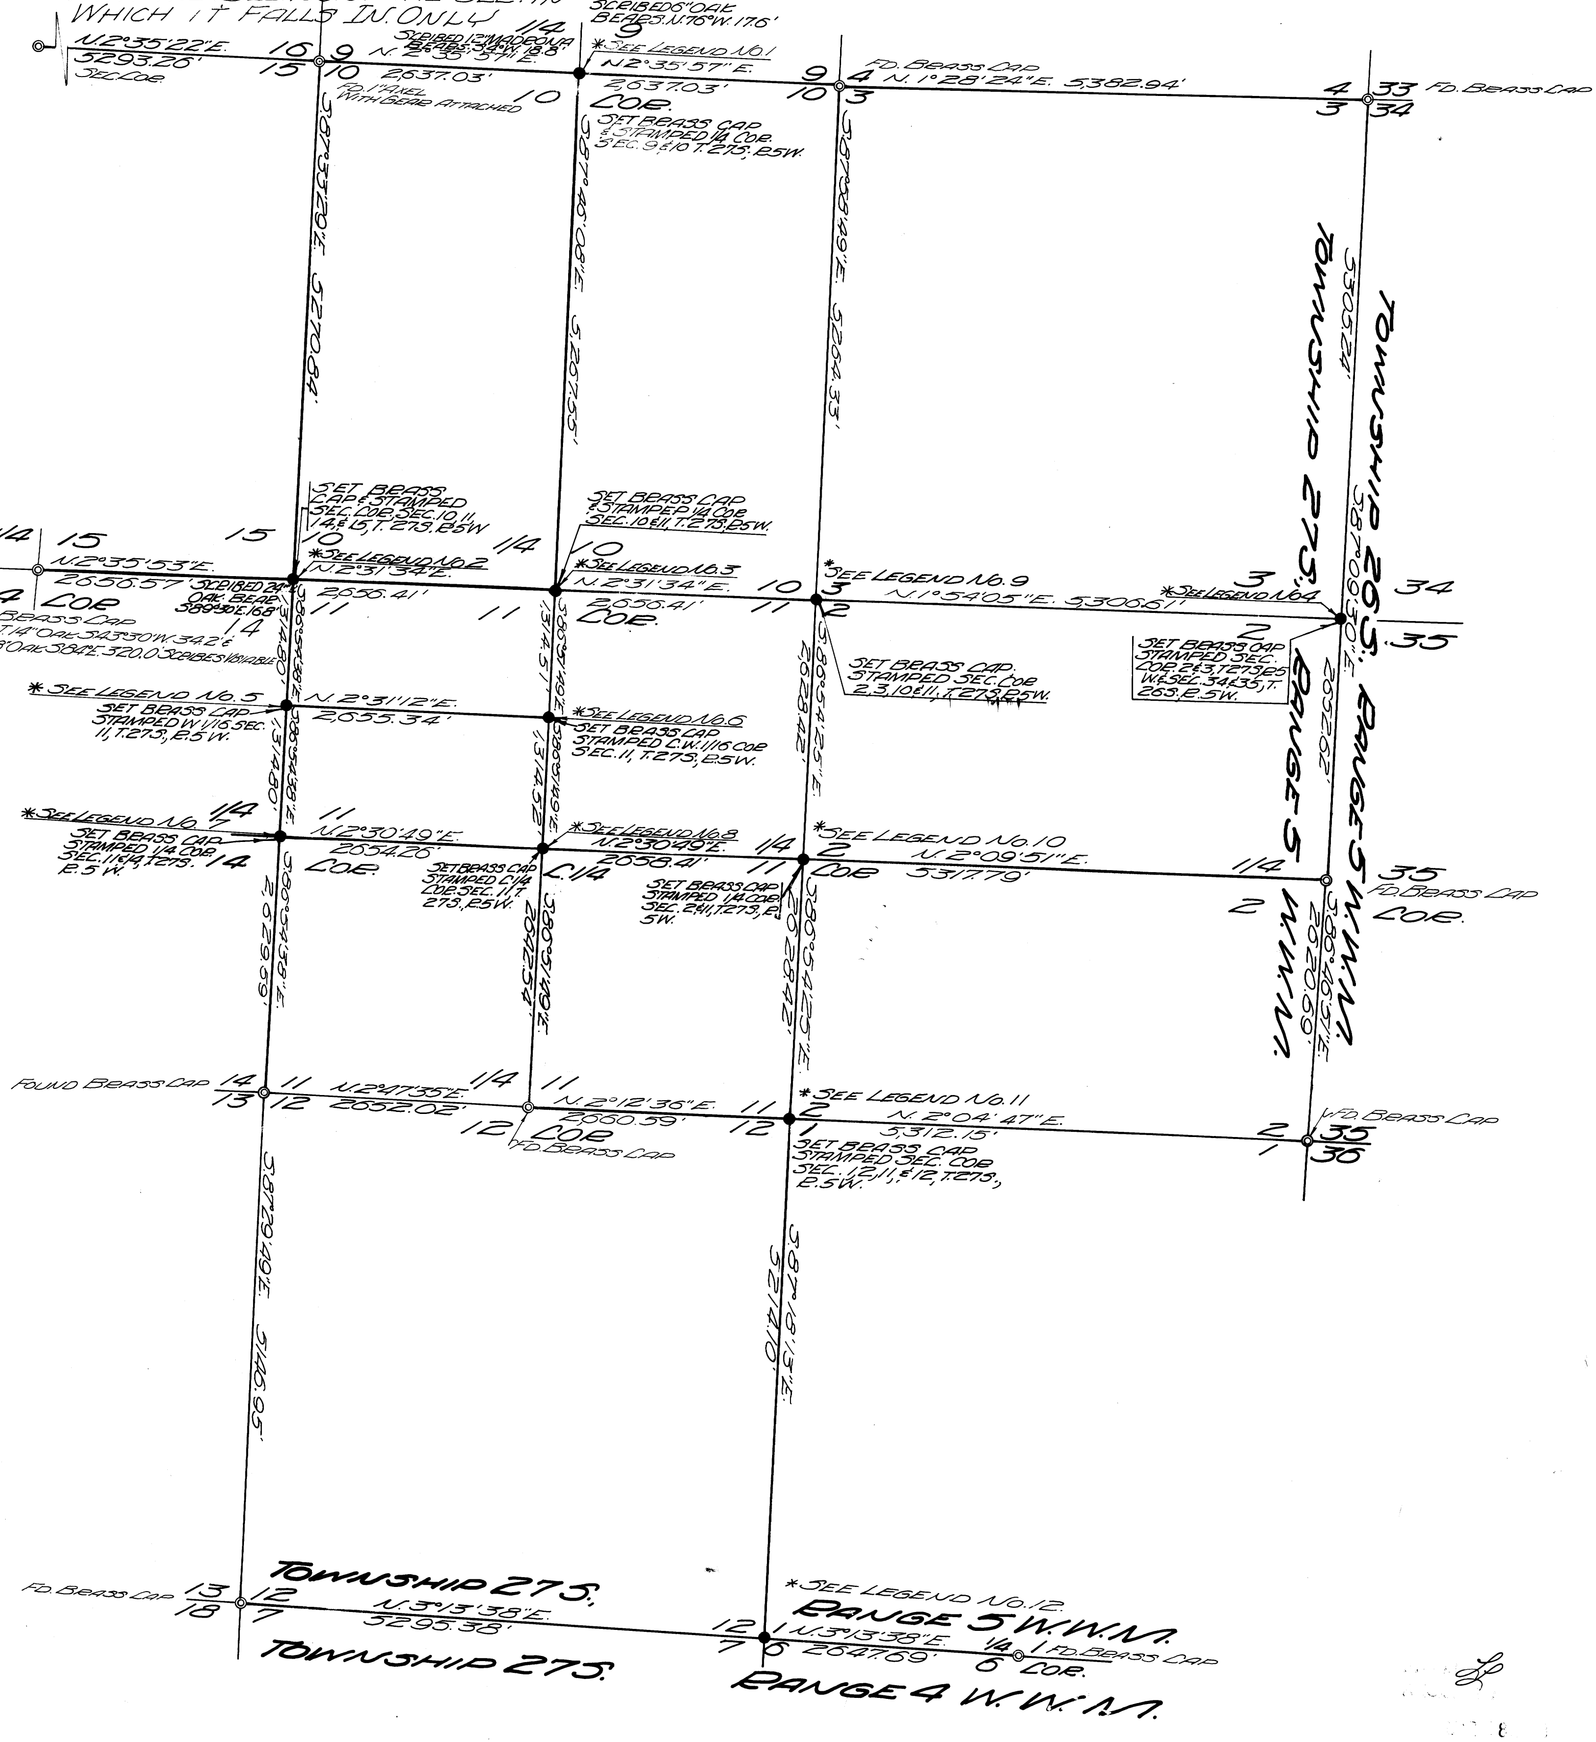

Note: No. 3 AMENDED 5/19/80

MAP FILE M.35 + 54