MAP FILE M35 # 69

COUNTY SURVEYORS FILE DATA
DO NOT REMOVE FROM OFFICE

SURVEY TO ESTABLISH PROPERTY CORNERS IN EDENBOWER ORCHARD TRACTS. DOUGLAS COUNTY, ORE.

SURVEYED FOR - TOWN & COUNTRY MOBILE PARK
SURVEYED BY - W.S. BARNES

APRIL 1968
SCALE - 1" = 100'

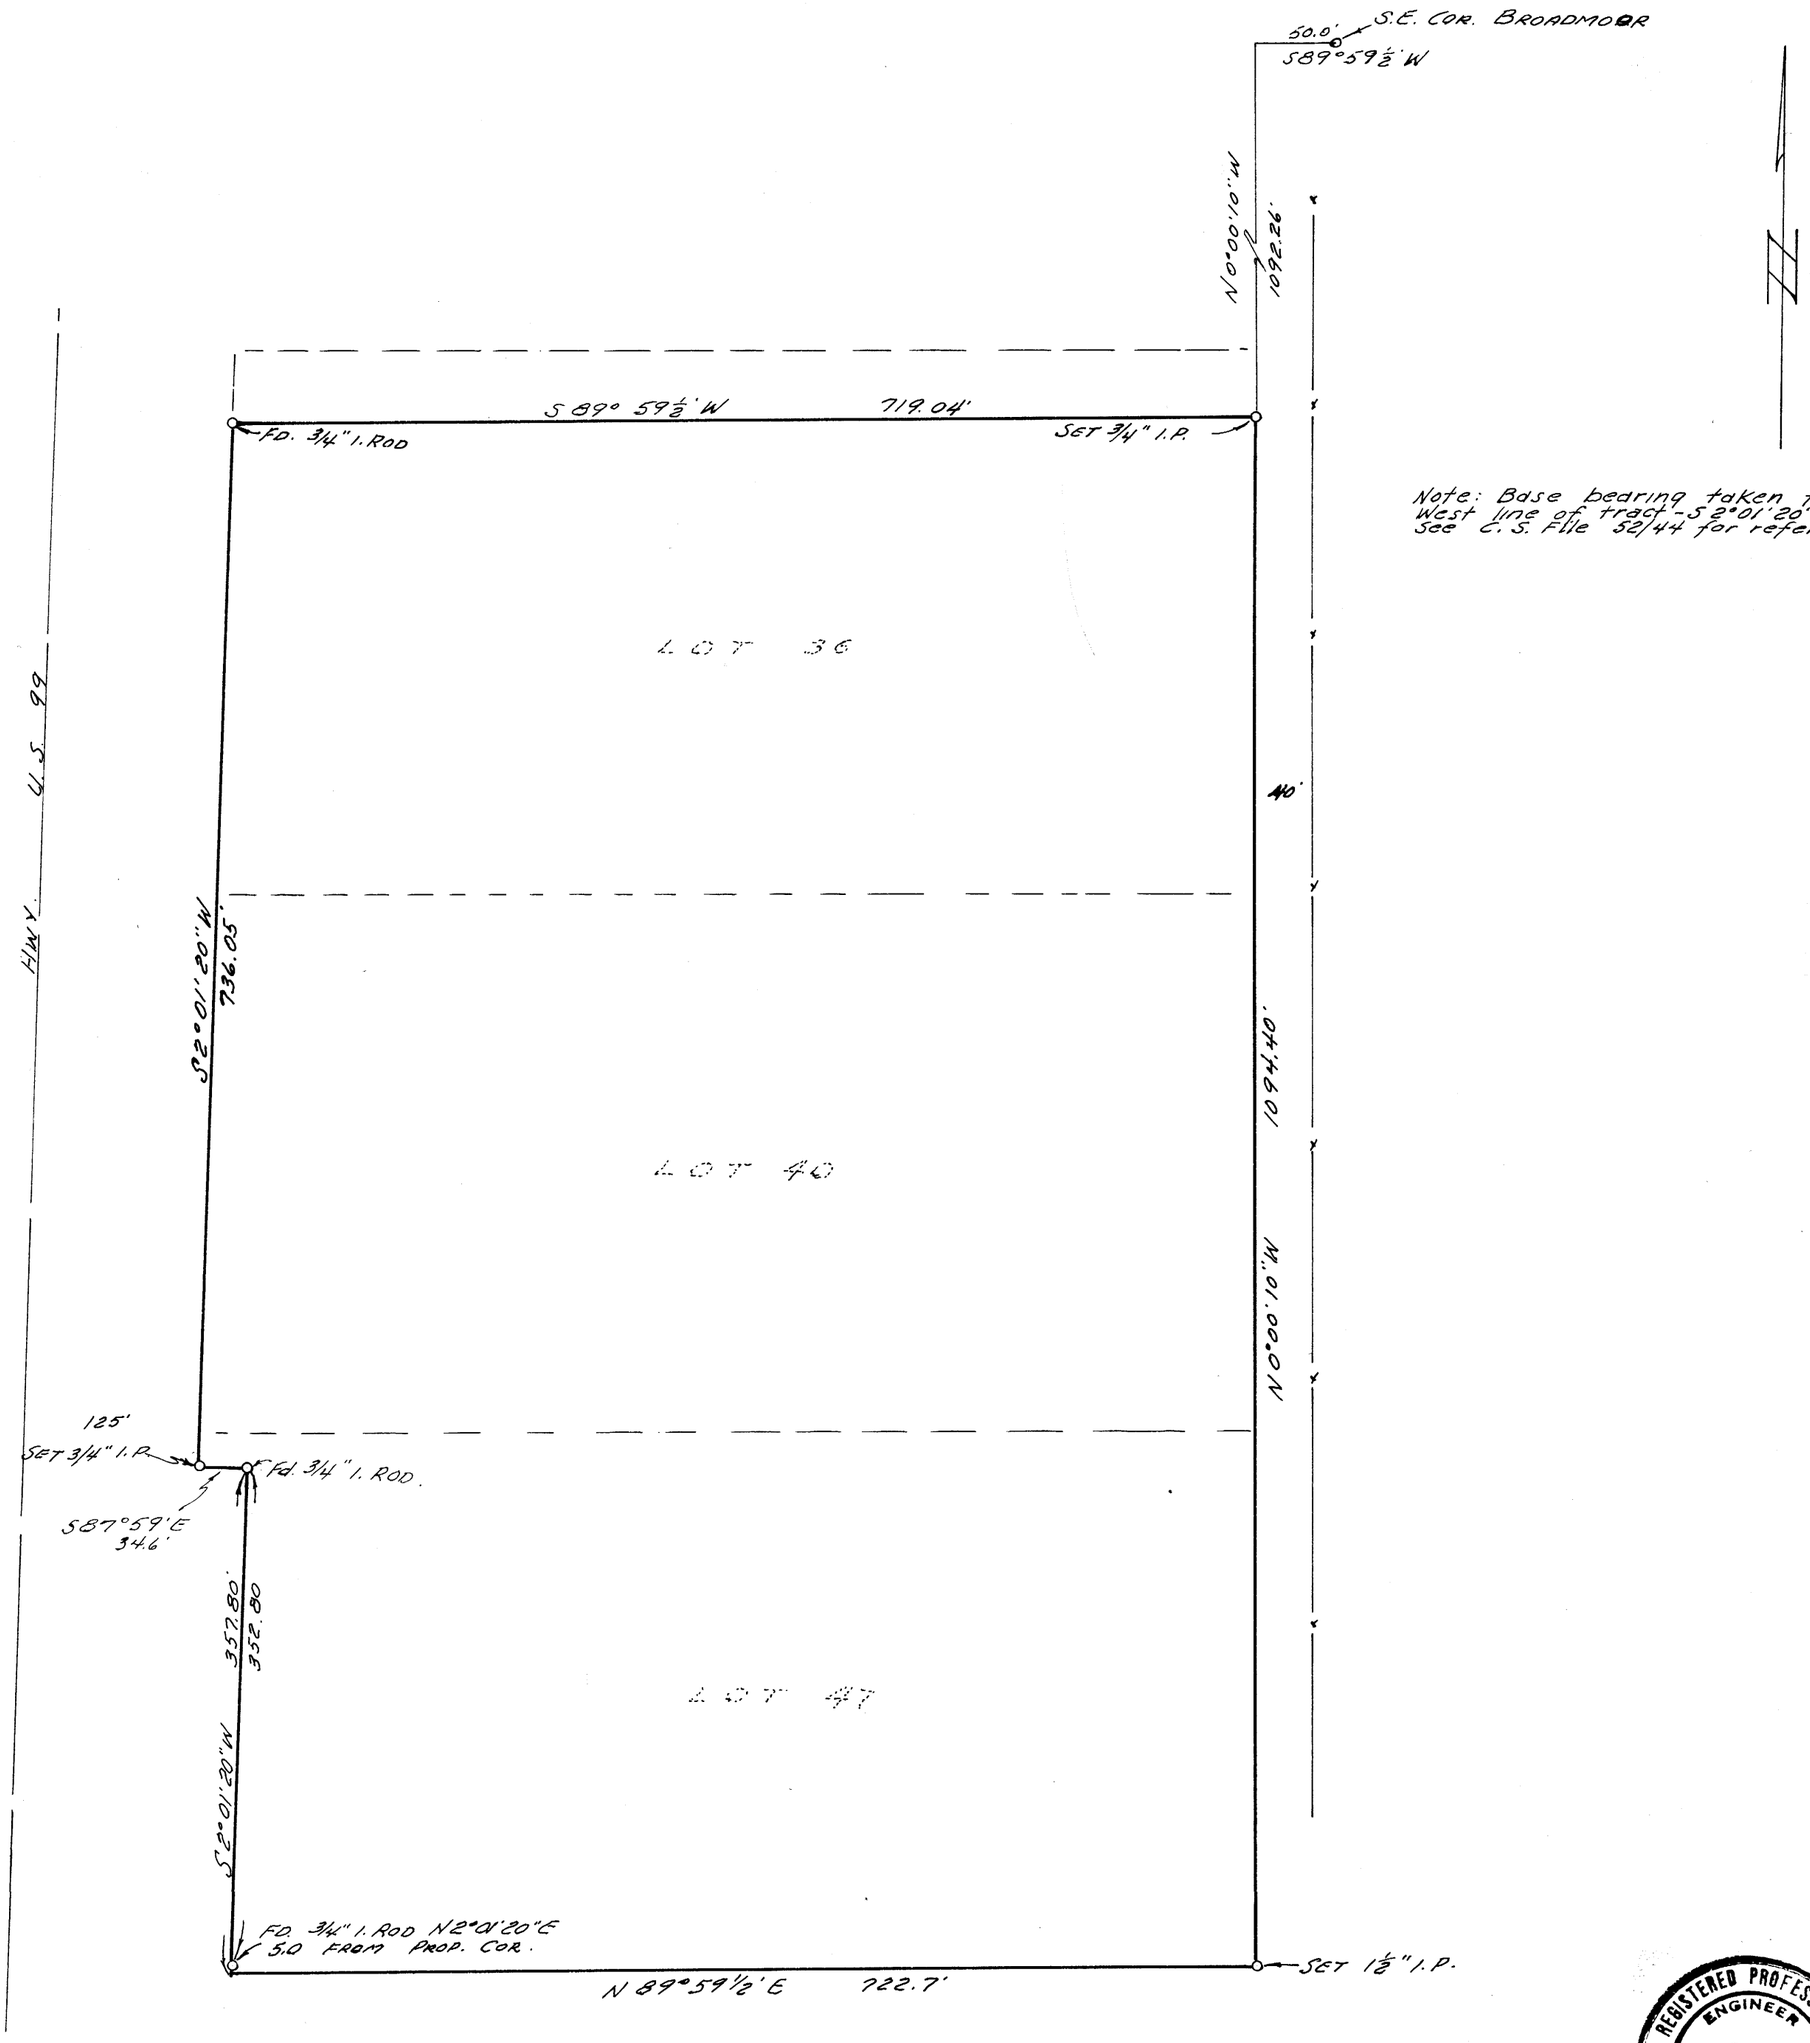

Note: Base bearing taken from West line of tract - S2°01'20"W. See C.S. File 52/44 for reference.

REGISTERED PROFESSIONAL ENGINEER 2128 OREGON SEPT. 5, 1941 William S. Barnes

W. S. Barnes

FILED
RECEIVED
APR 29 1968
COUNTY SURVEYOR
DOUGLAS COUNTY, ORE.

MAP FILE M-35 P-69