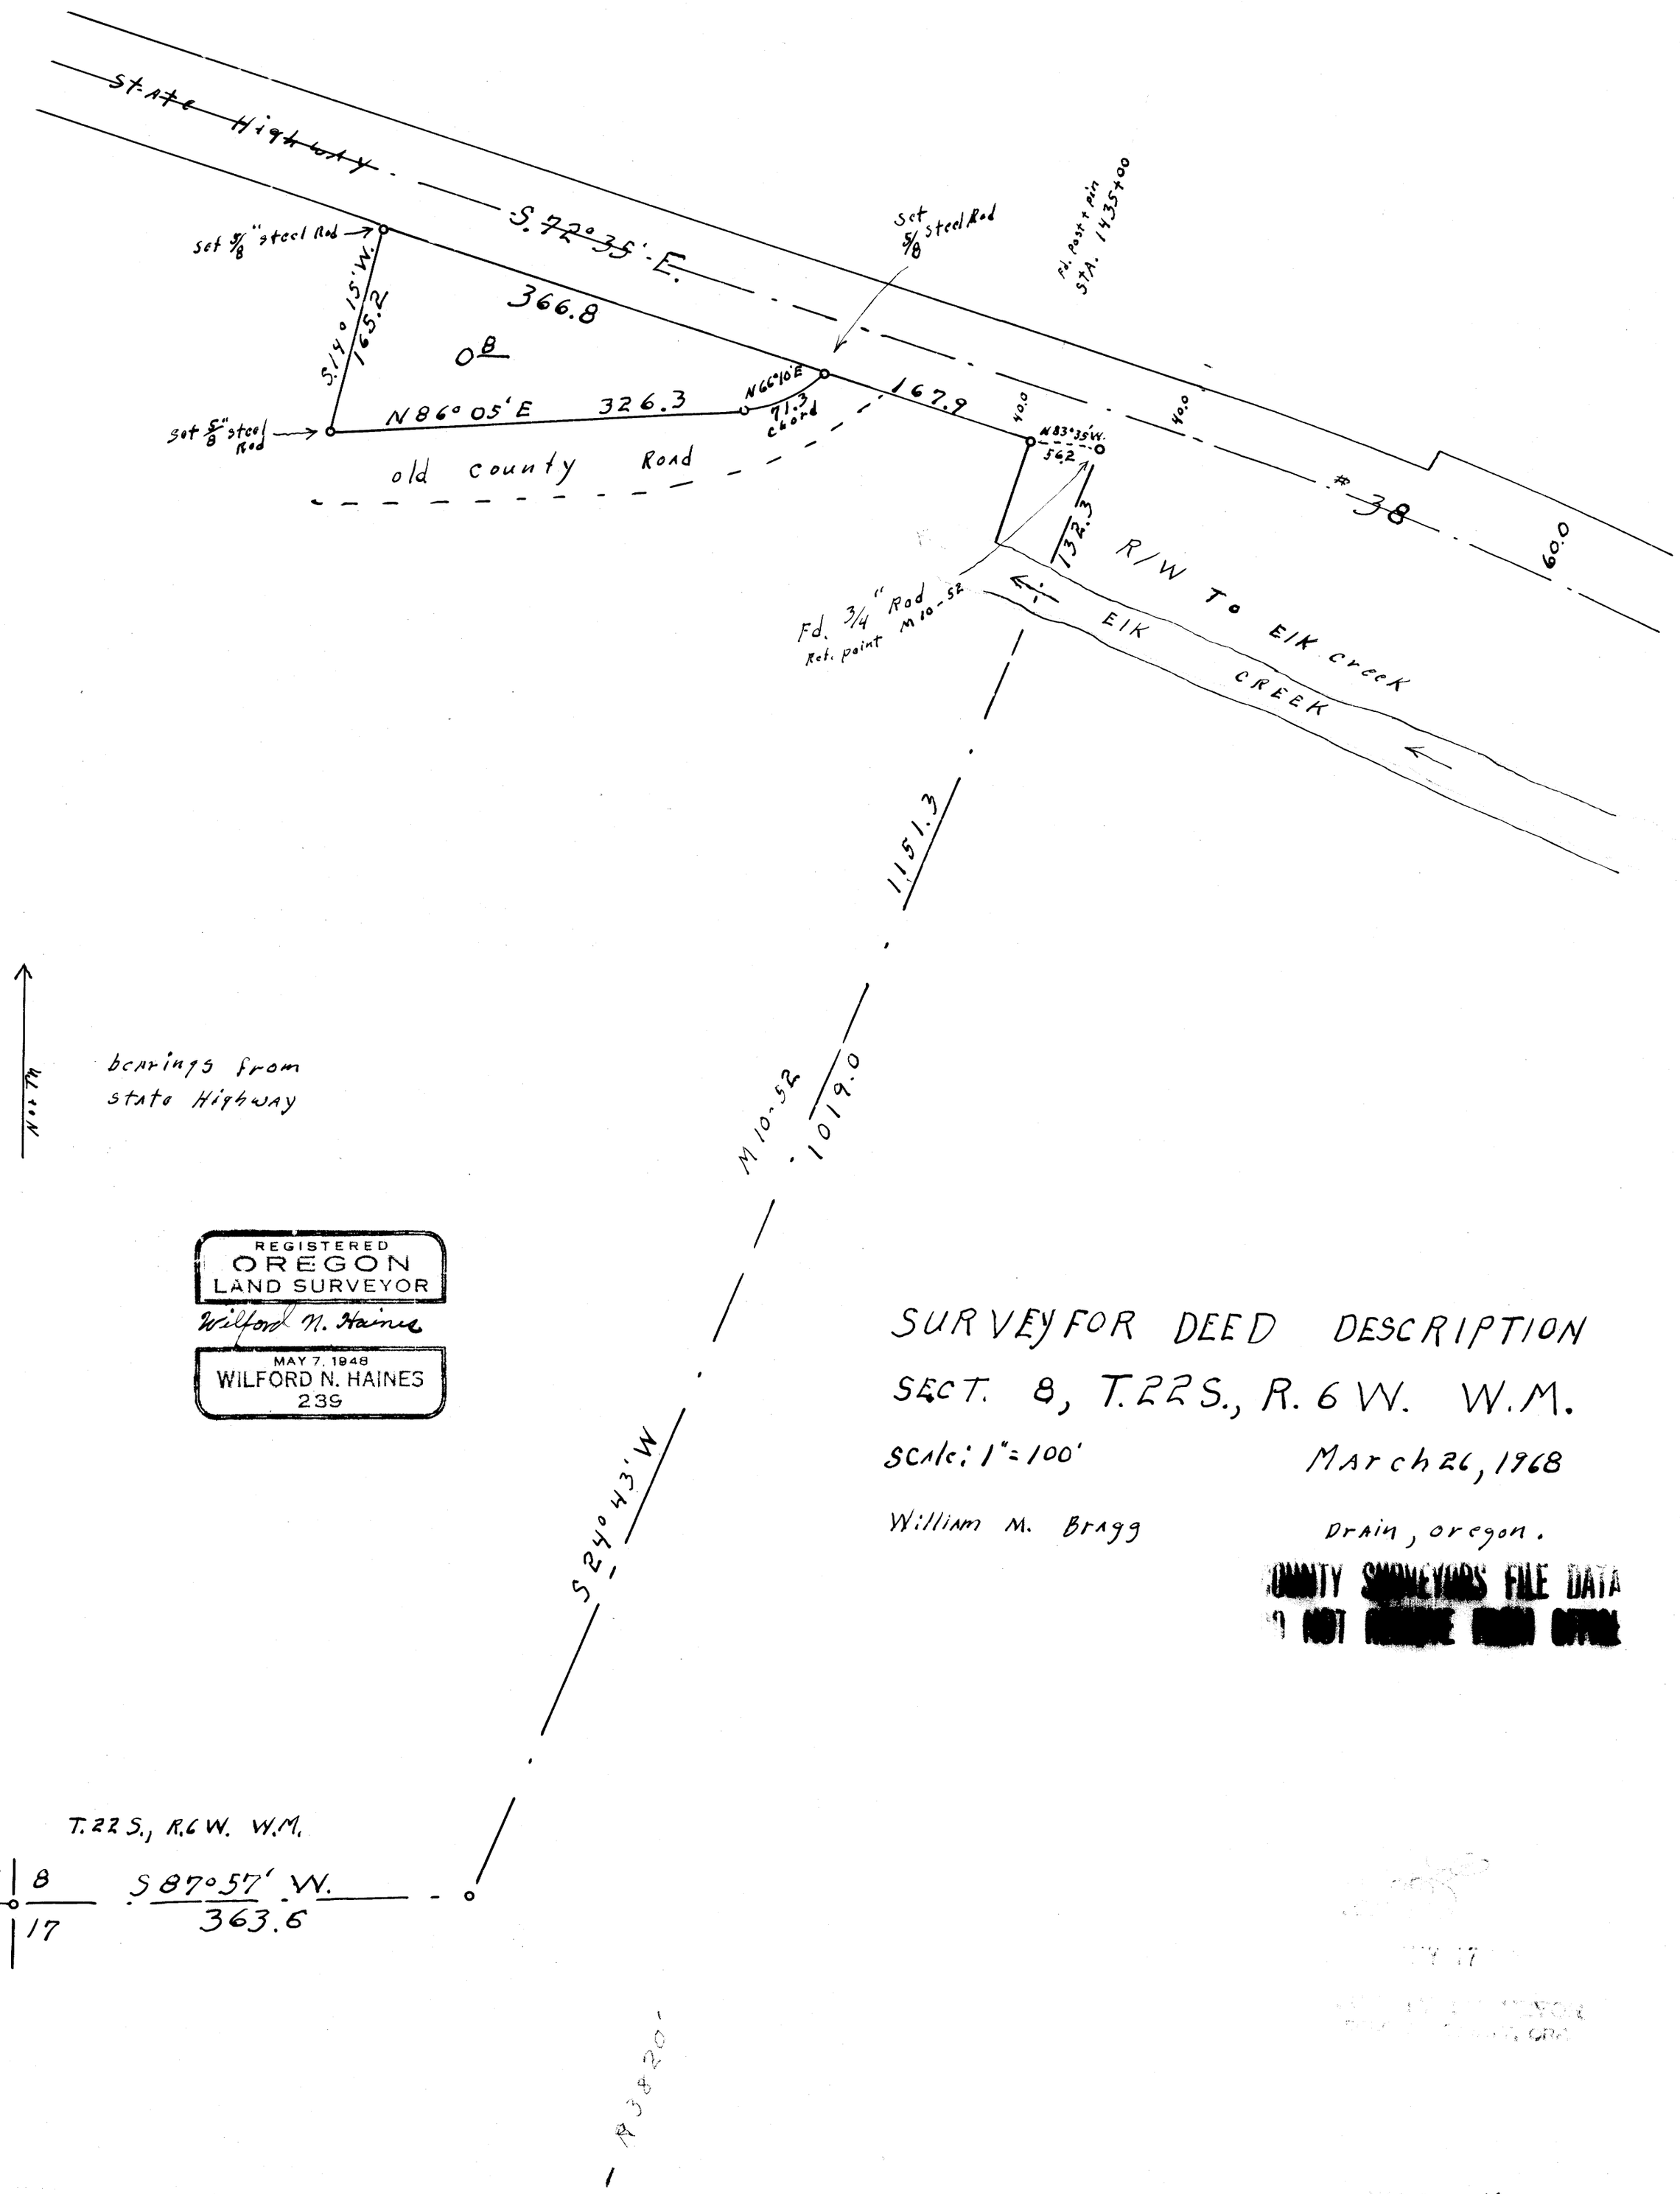

SURVEY FOR DEED DESCRIPTION

SECT. 8, T.22S., R.6W. W.M.

Scale: 1" = 100' March 26, 1968

William M. Bragg Drain, Oregon.

COUNTY SURVEYORS FILE DATA
DO NOT REMOVE FROM OFFICE

MAP FILE M35 - 76