COUNTY SURVEYORS FILE DATA
DO NOT REMOVE FROM OFFICE

FILED
RECEIVED
AUG 13 1968
COUNTY SURVEYOR
DOUGLAS COUNTY, ORE.

SURVEY IN S.W. 1/4 of SEC. 13, T. 26 S., R. 4 W. W.M. DOUGLAS COUNTY, ORE.

SURVEYED FOR – SO. ORE. LOG SCALING & GRADING BU.
SURVEYED BY – W. S. BARNES

JULY 1968
SCALE: 1" = 40'

Note: Base bearing taken from east line of L. L. Burr property – S16°33'E.

Reference M 34-62

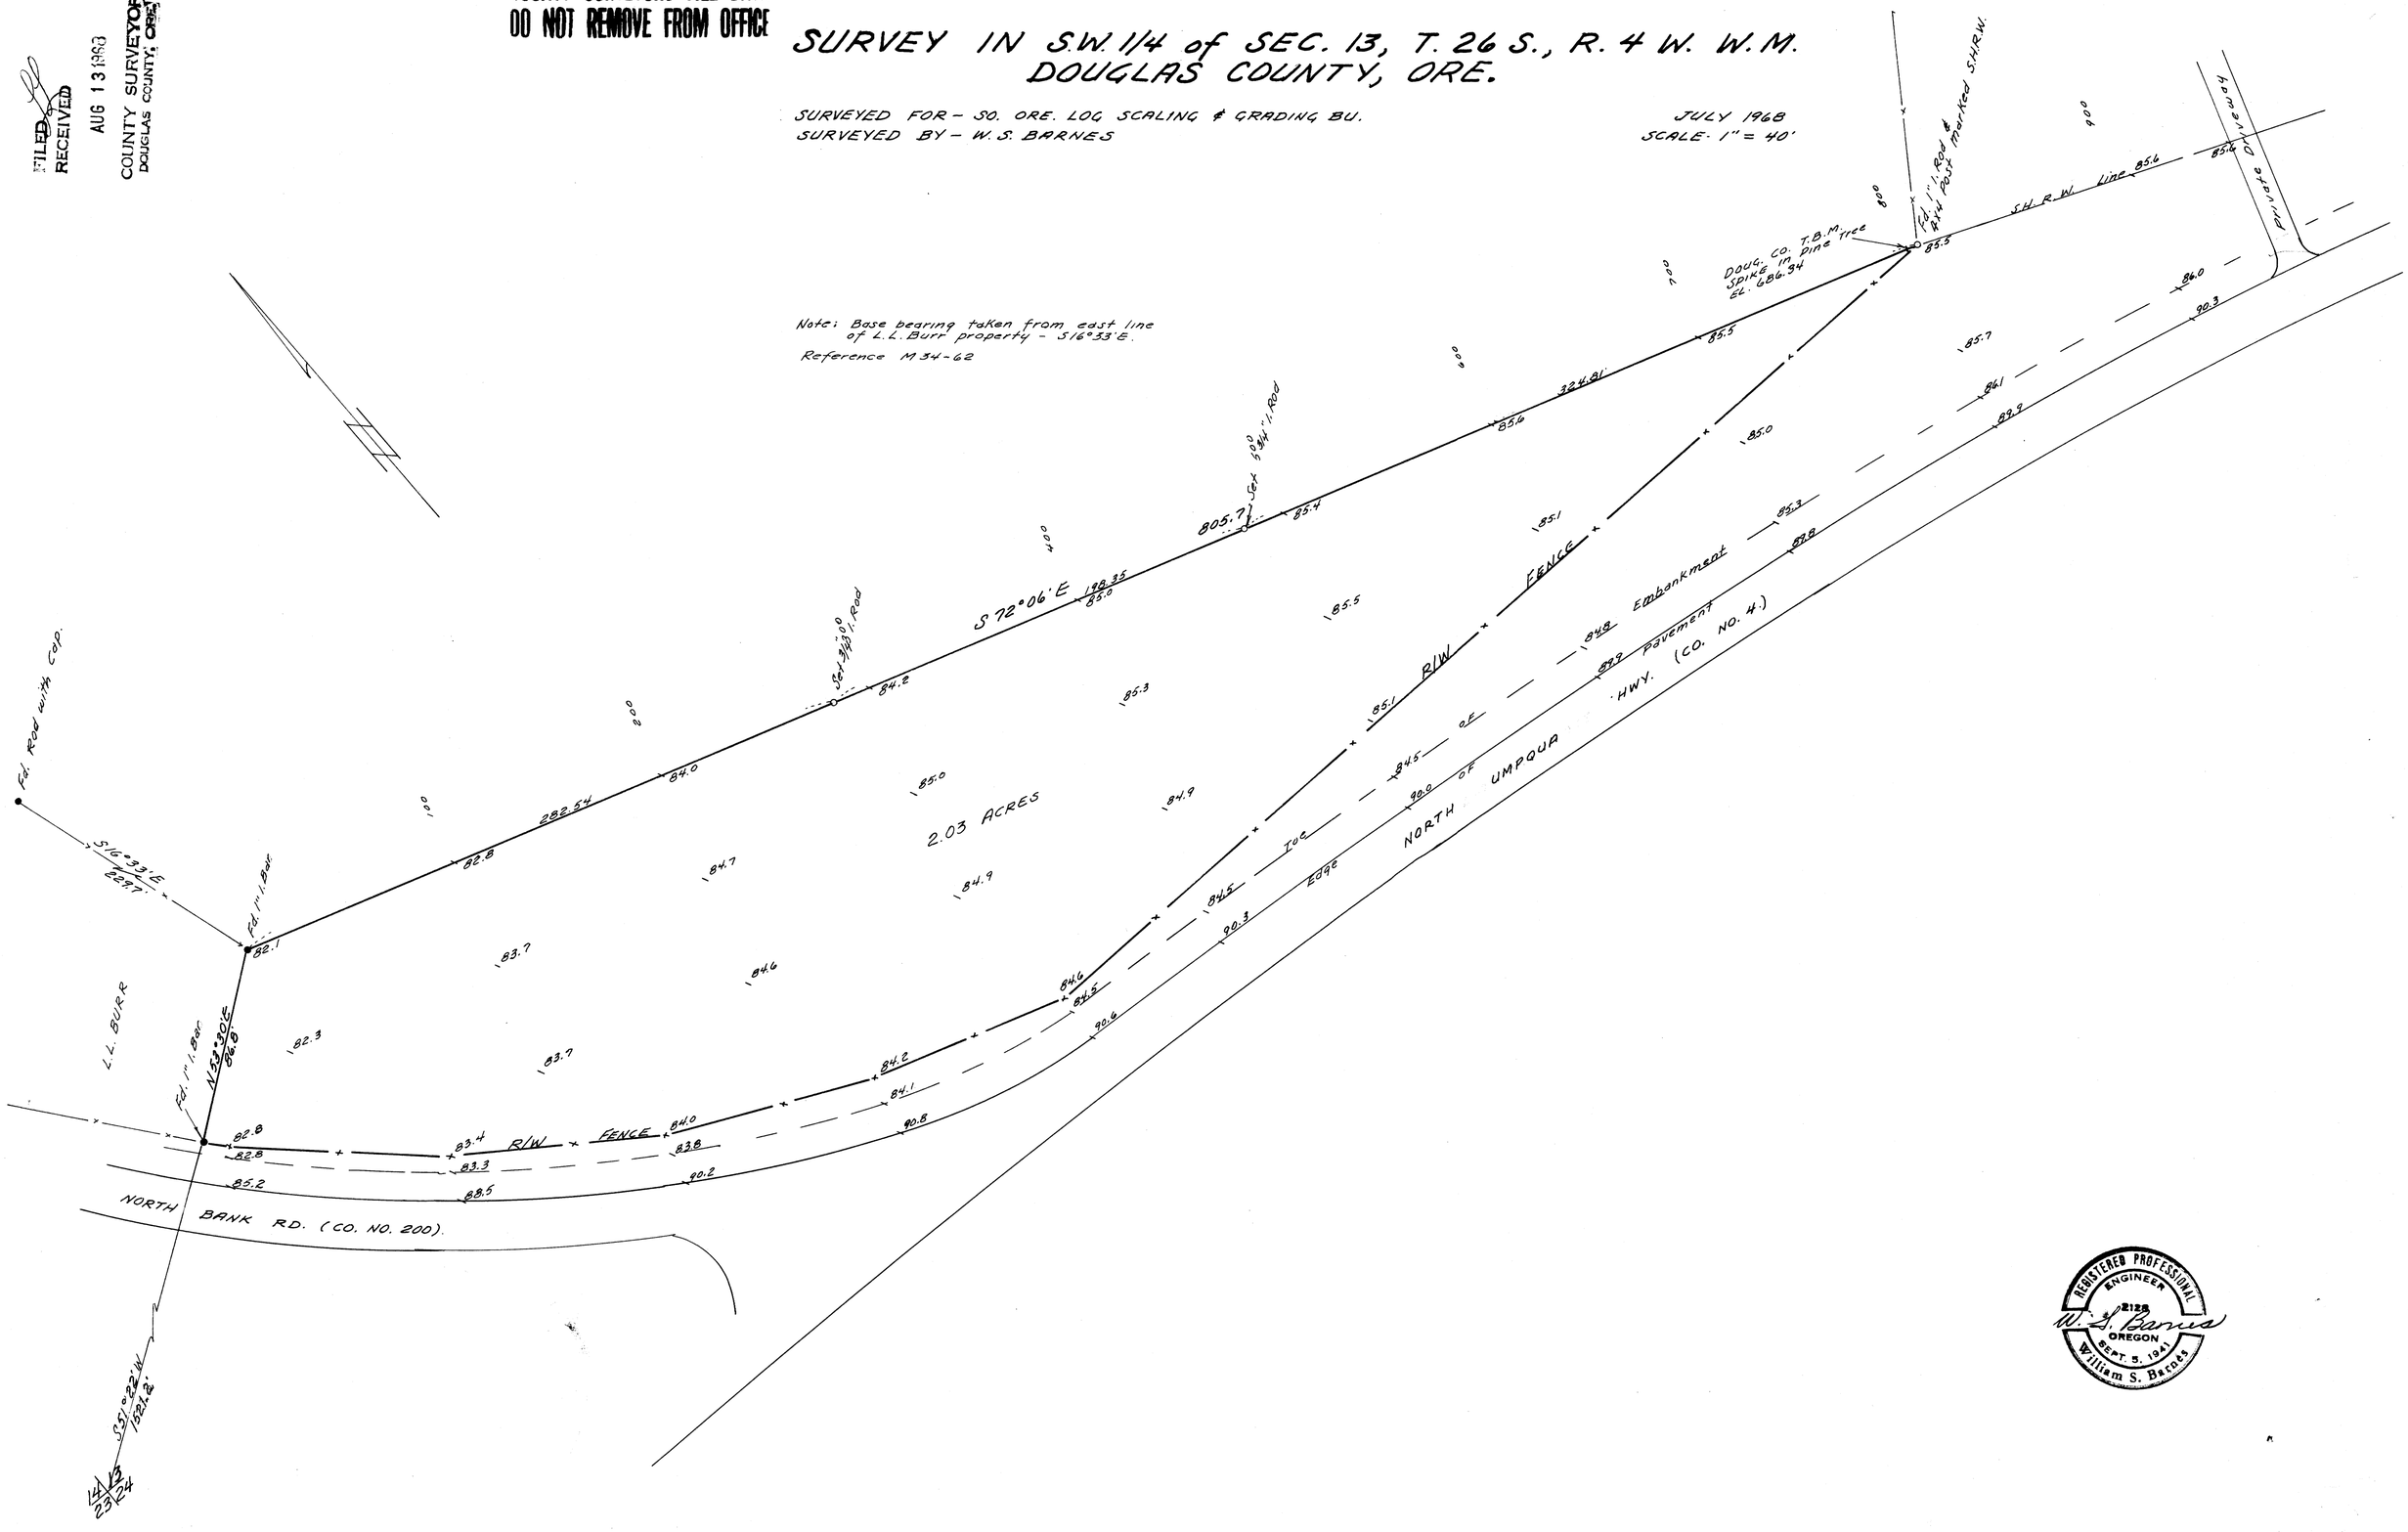

REGISTERED PROFESSIONAL ENGINEER
2128
W. S. Barnes
OREGON
SEPT. 5, 1941
William S. Barnes

MAP FILE M-36 # 25

MAP FILE M-36 # 25