COUNTY SURVEYORS FILE DATA
DO NOT REMOVE FROM OFFICE

SURVEY OF

LOTS 170, 171, & 172 TRACT 1, PLAT 1
ROSEBURG ORCHARD COMPANY

for

Mr. & Mrs. Richard L. Shadoan

Scale: 1" = 100'
Date: August 13, 1968

Dennis O. Bryant
Registered Engineer

FILED
RECEIVED
AUG 13 1968
COUNTY SURVEYOR
DOUGLAS COUNTY, OREG.

REGISTERED PROFESSIONAL ENGINEER 5709 Dennis O. Bryant OREGON JULY 8 1966 DENNIS O. BRYANT

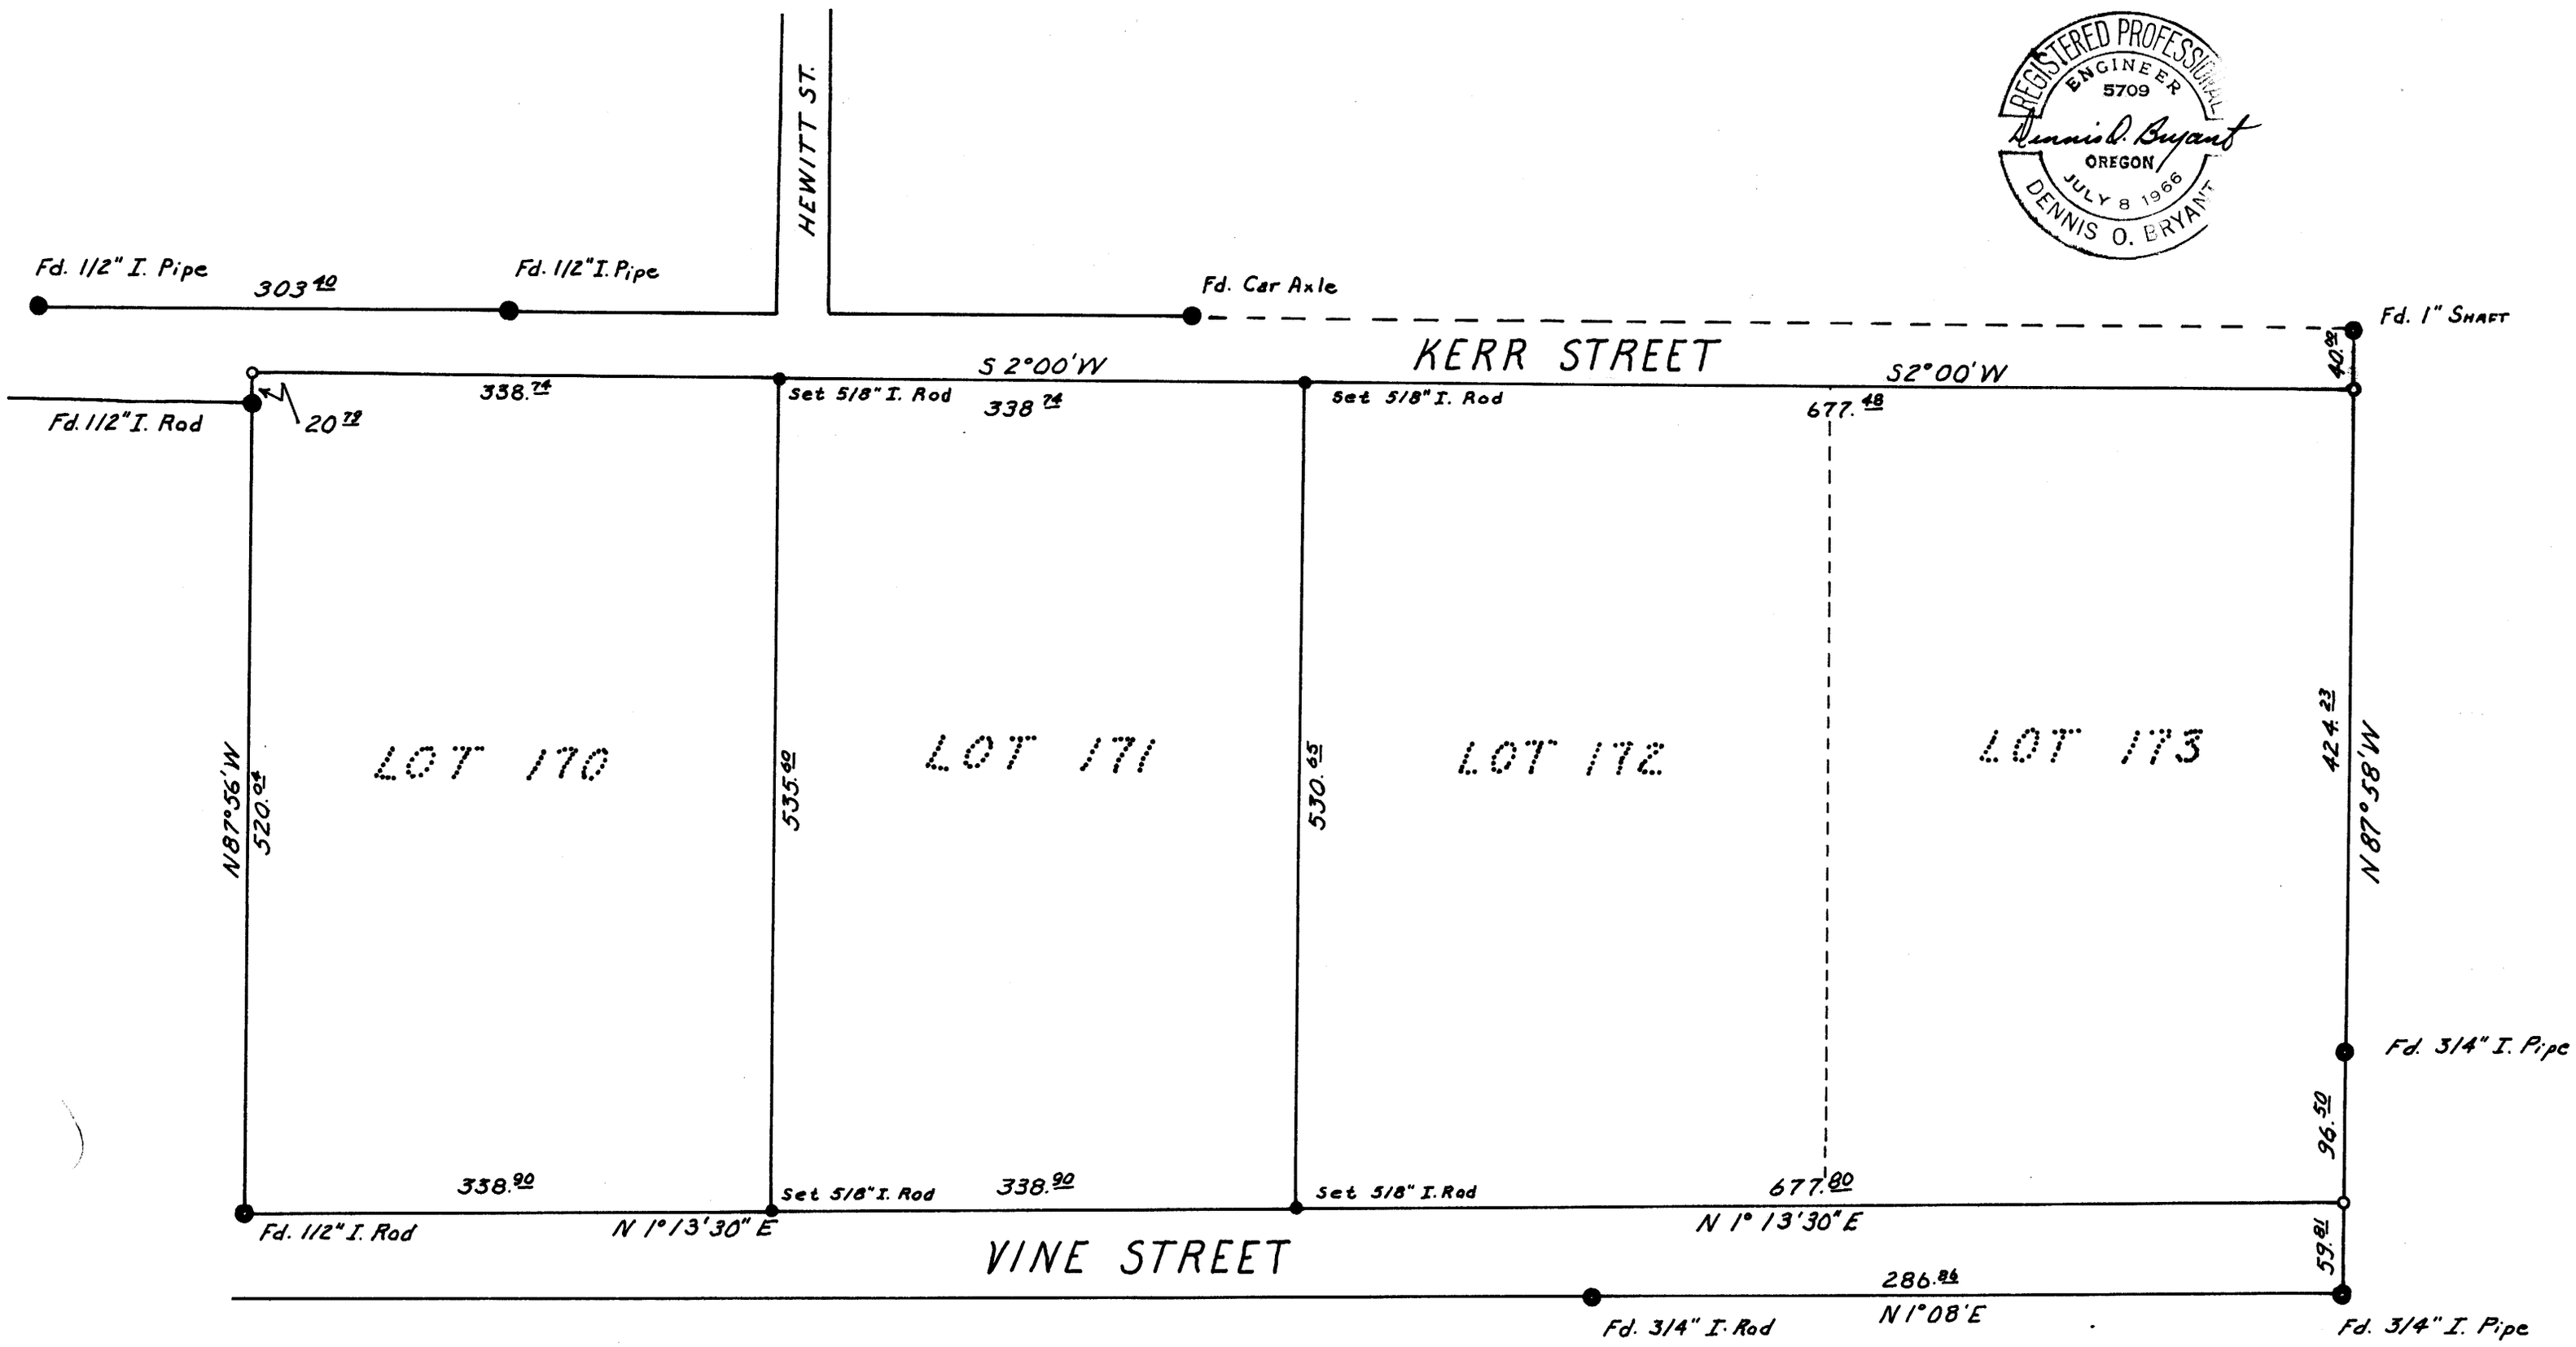

● Corner Found
• Corner Set This Survey
○ Calculated Point

Note: Bearings based on South Line Lot 170 per C.S. File 54/13

MAP FILE M-36 P-26
MAP FILE M-36 P-26